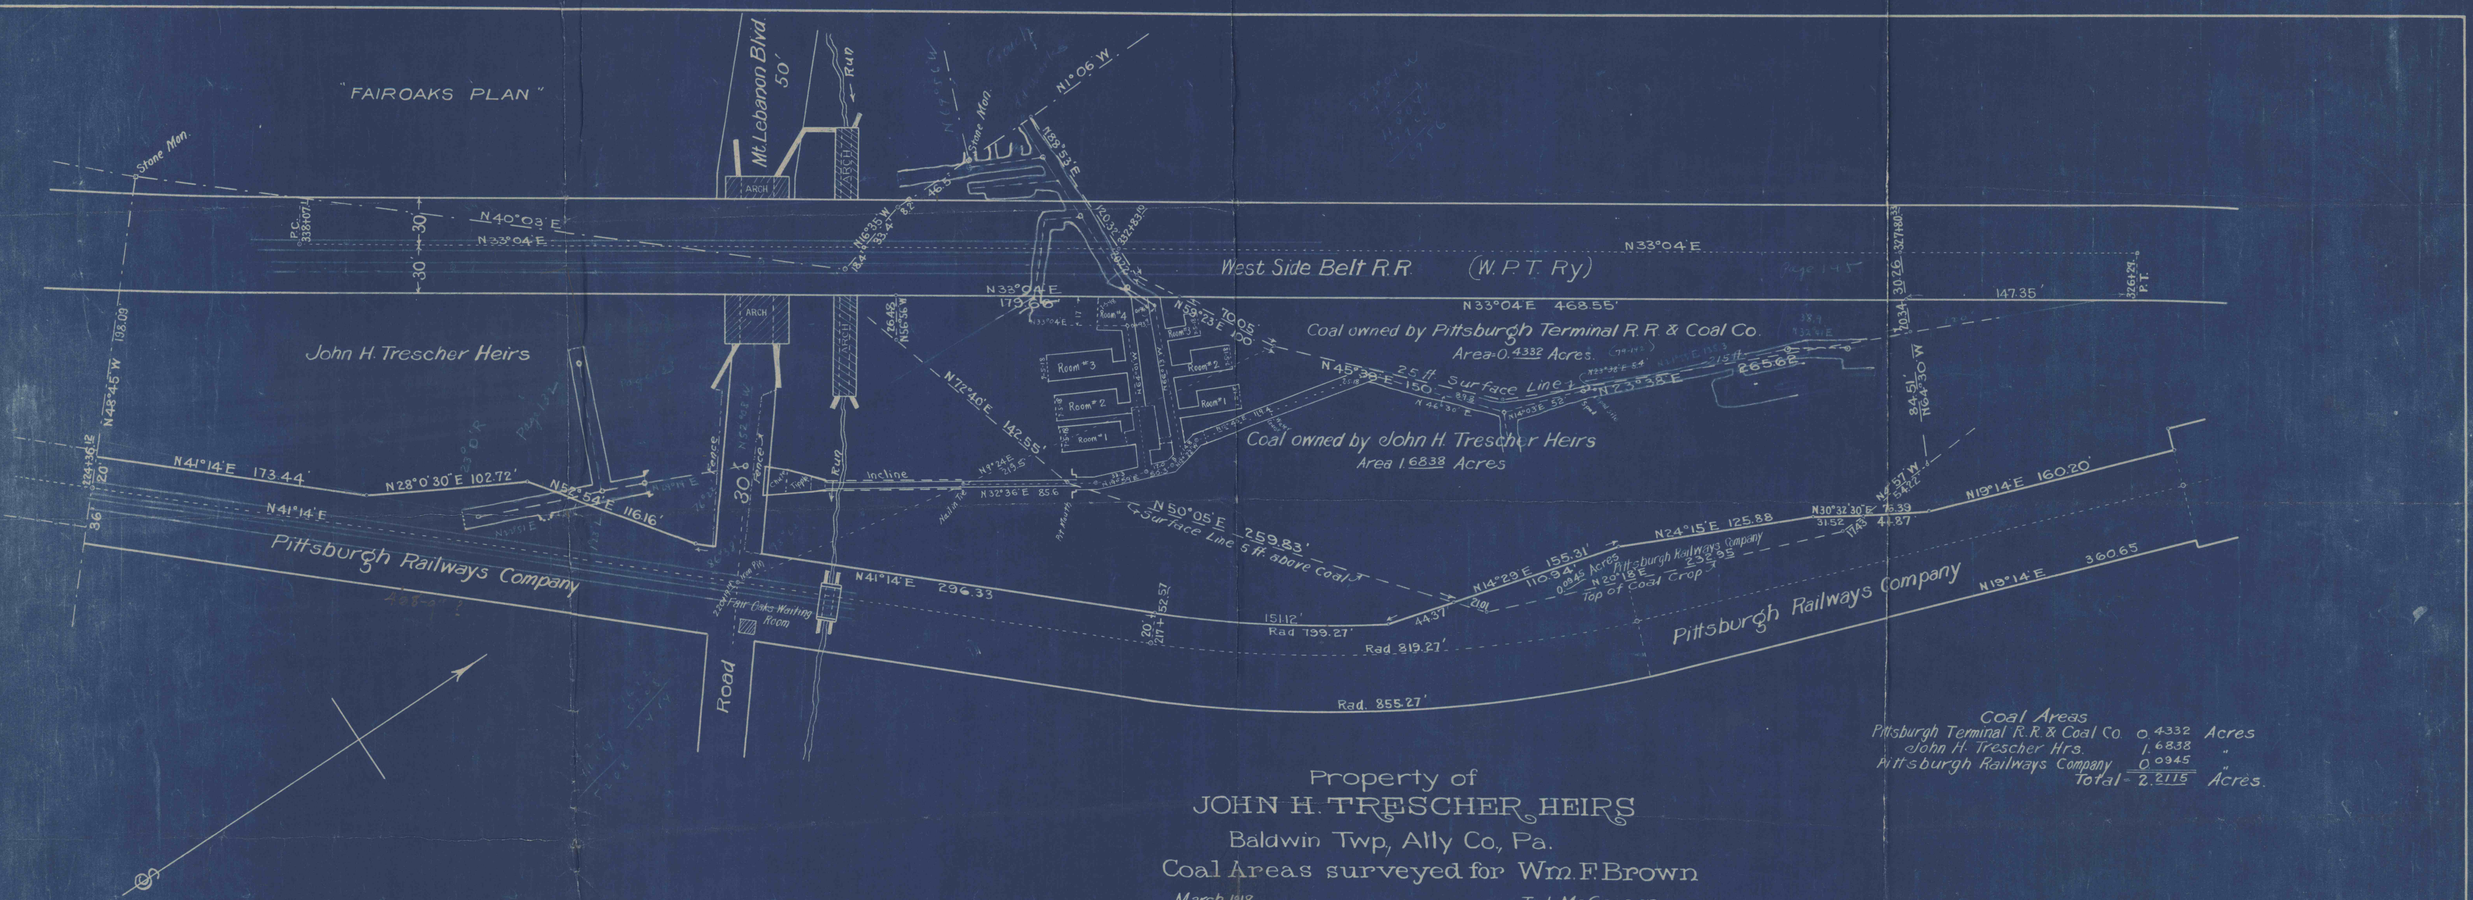

Property of
JOHN H. TRESCHER HEIRS
Baldwin Twp, Ally Co., Pa.
Coal Areas surveyed for Wm. F. Brown
March 1918.

T. J. McGovern
Civil and Mining Engineer.

Coal Areas

Pittsburgh Terminal R.R. & Coal Co.	0.4332	Acres
John H. Trescher Hrs.	1.6838	"
Pittsburgh Railways Company	0.0945	"
Total	2.2115	Acres.