


#680
12-29-99
CO

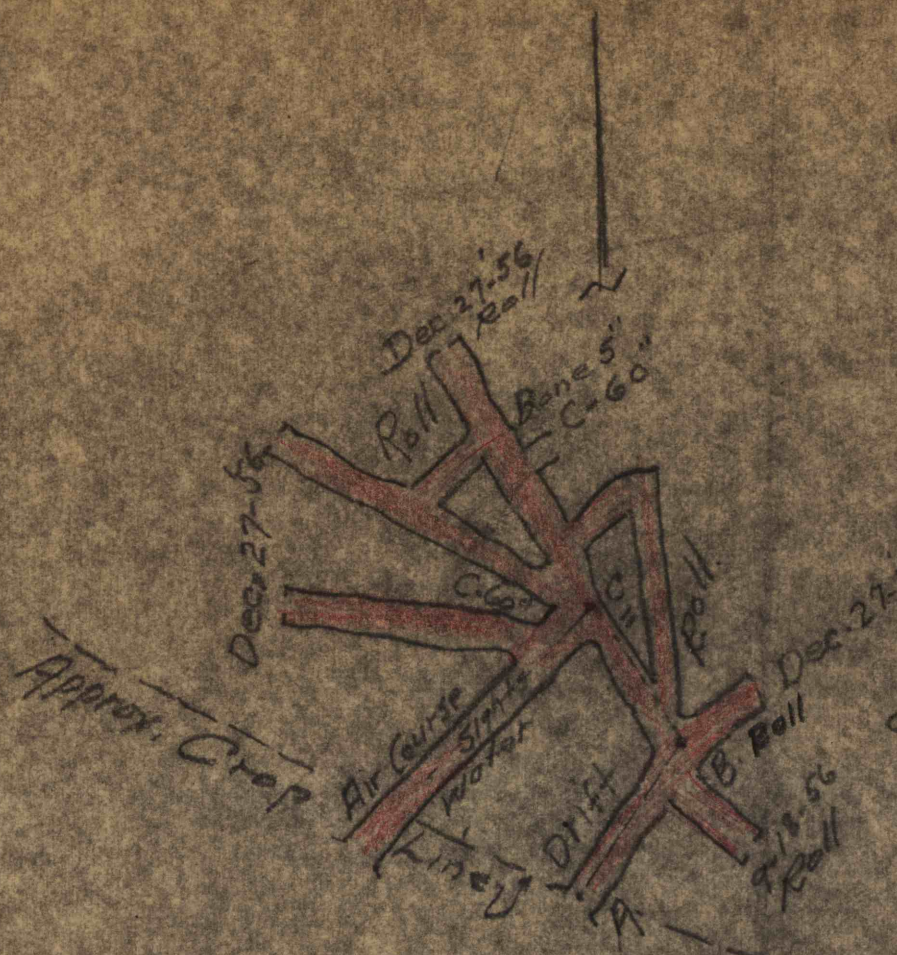

Map of Creek Bottom Mine
Operated by Shank Brothers.
Scale 1" = 50' - Sep 18 - 1956.

W. B. Jones - Reg #1691 -
Revised to Dec. 27-56 -
Idle since " " " "
Mine Inspection District #25
Oil & Gas " " #2
Situate White Township
Indiana County - Pennsylvania -
Lower Kittanning Seam -

Private Road to Tipple



25-1956

outlines plus 3