


**HECLA COAL & COKE Co.
CRYSTAL MINE.**

Original Acreage 395.05
 Acreage Available Jan. 1, 1920 ... 207.43 *

* Figure includes remainder of $\frac{1}{2}$ Undivided interest in 150.64 Ac.
 " " " " " " " " " " " " " " 225.786 Ac.

NEAR GANS STATION - B.&O. R.R.
 SPRING HILL TWP., FAYETTE CO., PA.

NOTE: Area crosshatched shows coal removed.

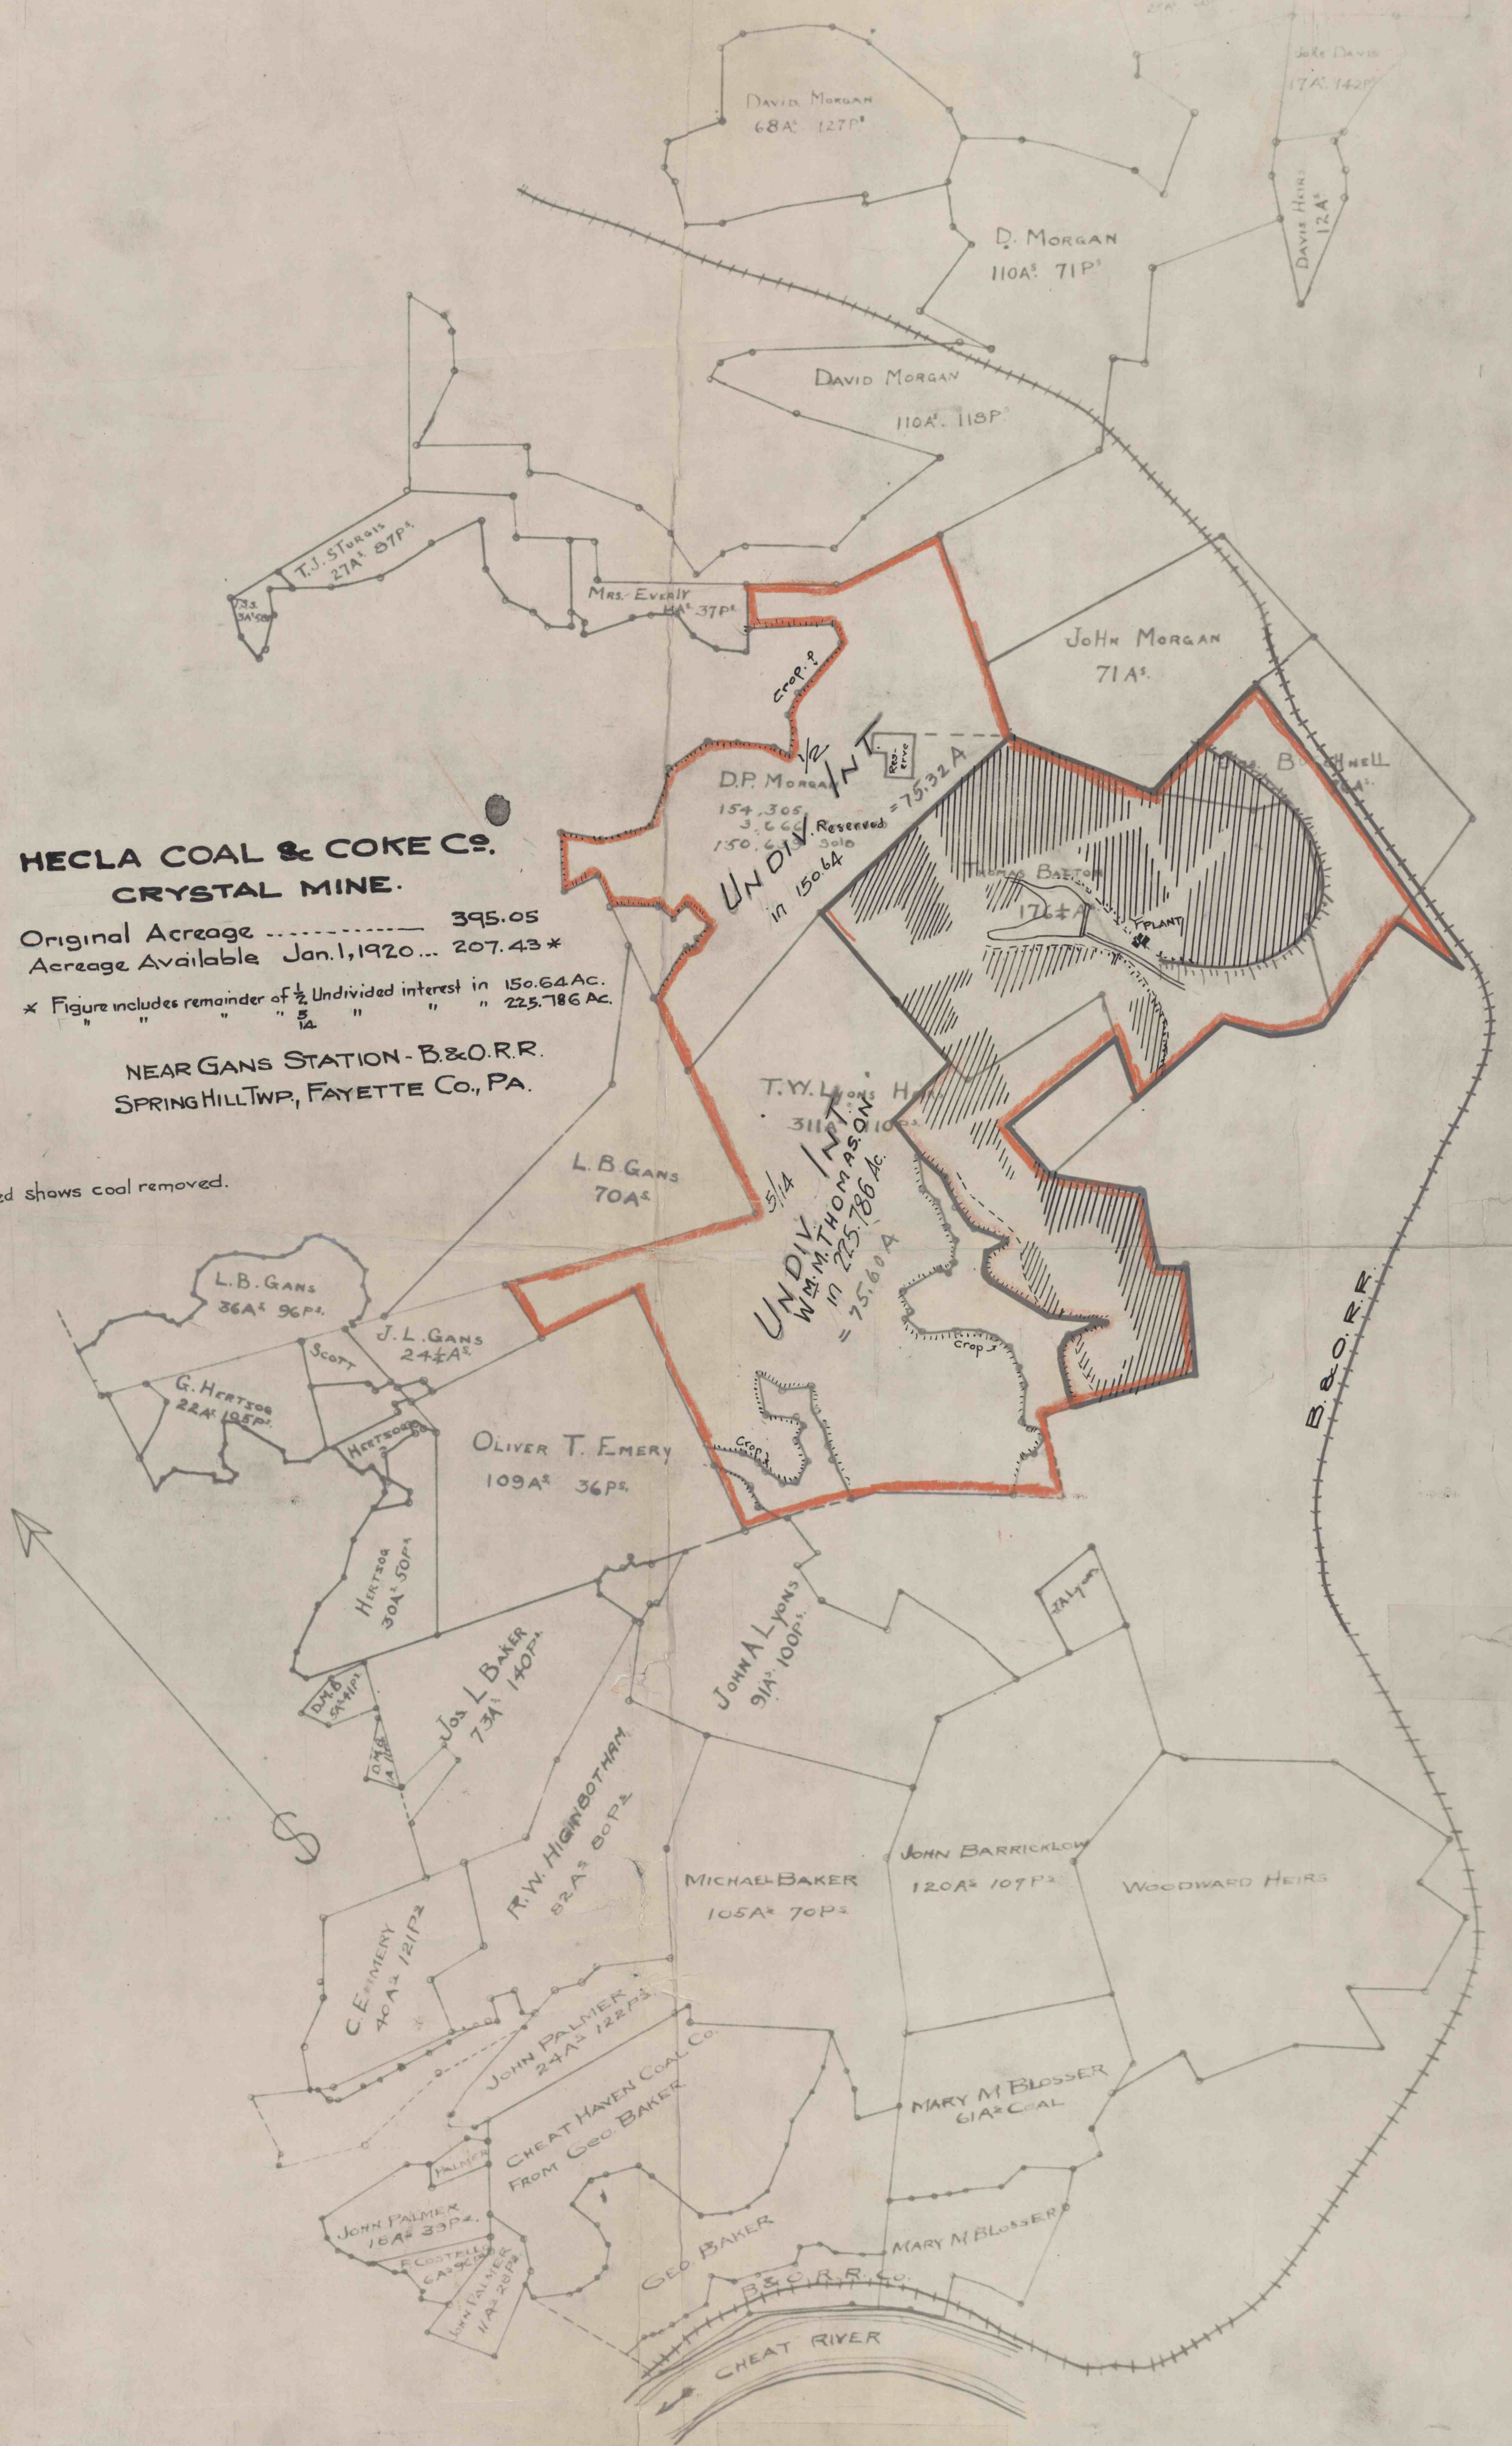

#704
 7-28-99
 C.C.

SCALE 1 IN = 50 RODS