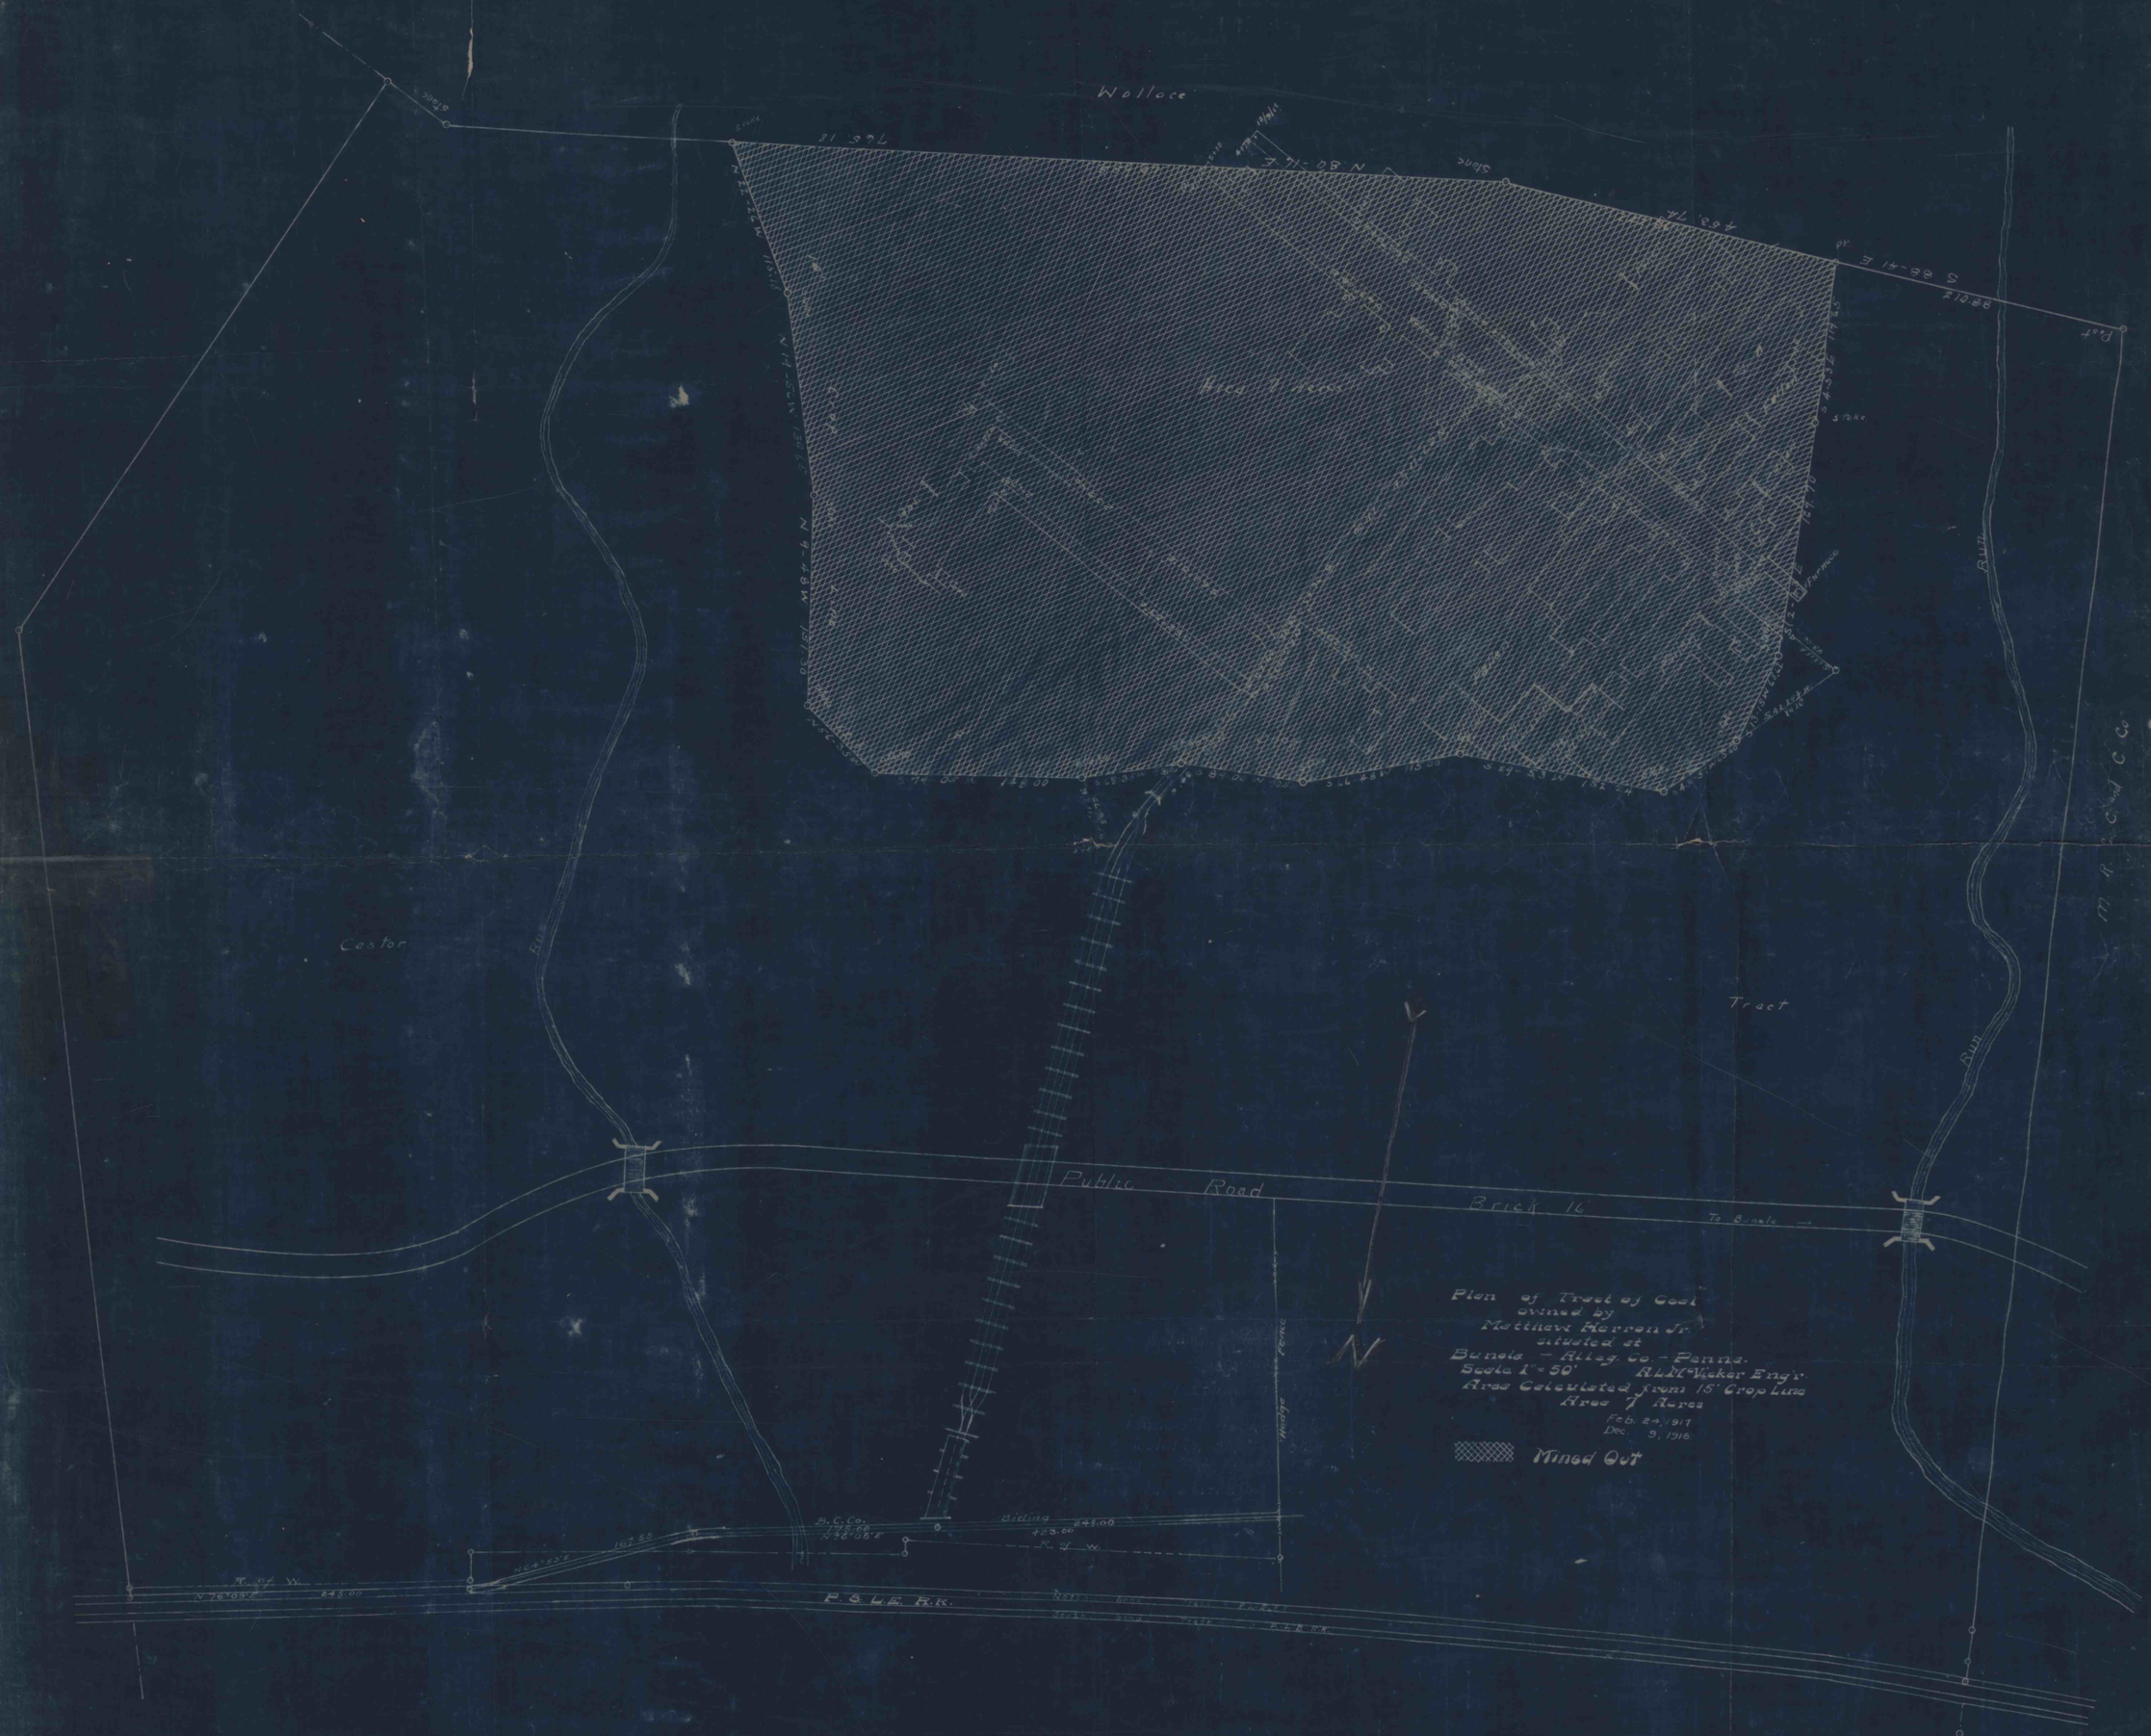
Wallace
Stone
Stone
Stone