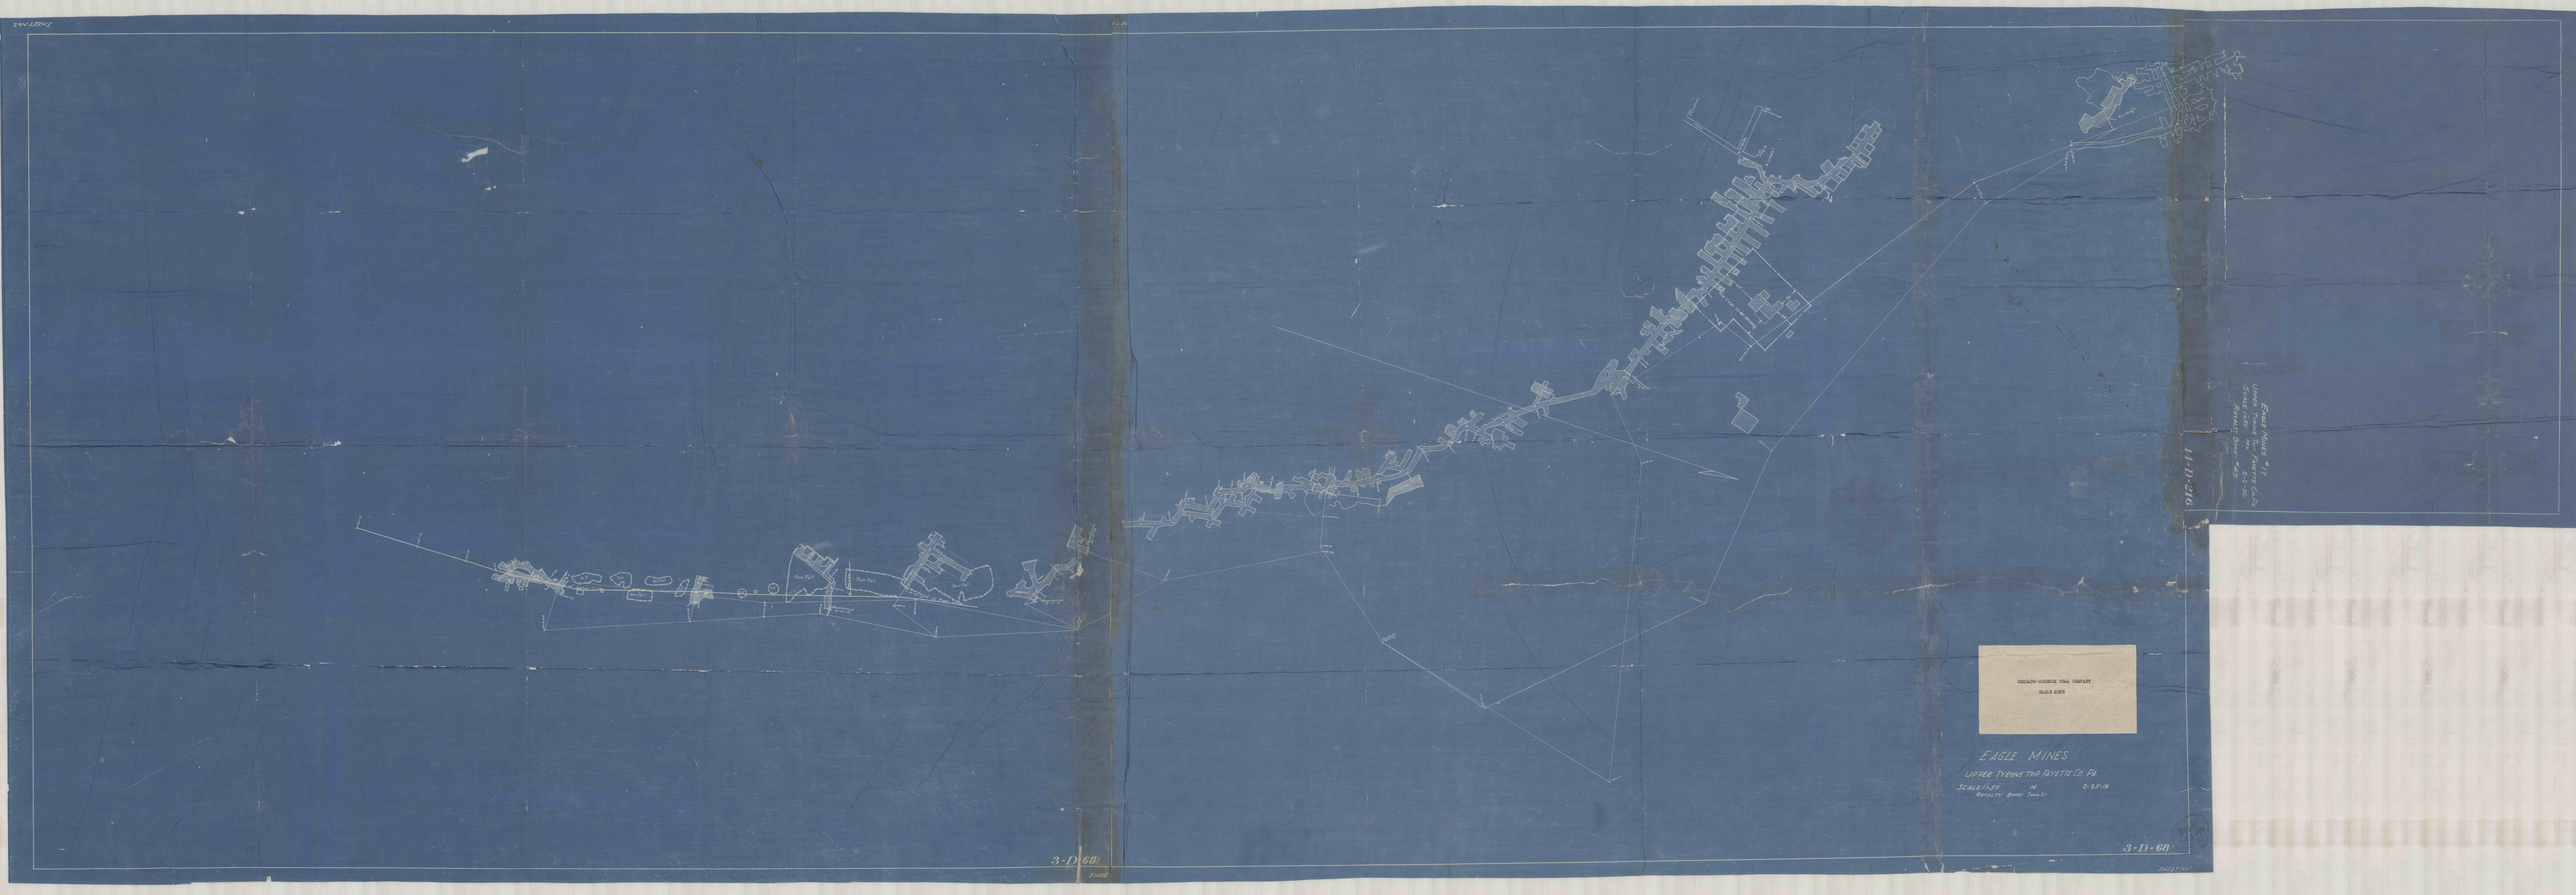
Eagle Mines
Upper Tyrone Twp
Fayette Co. Pa.
Date 2-23-18
Sheet No. 1
Sheet No. 2
Sheet No.