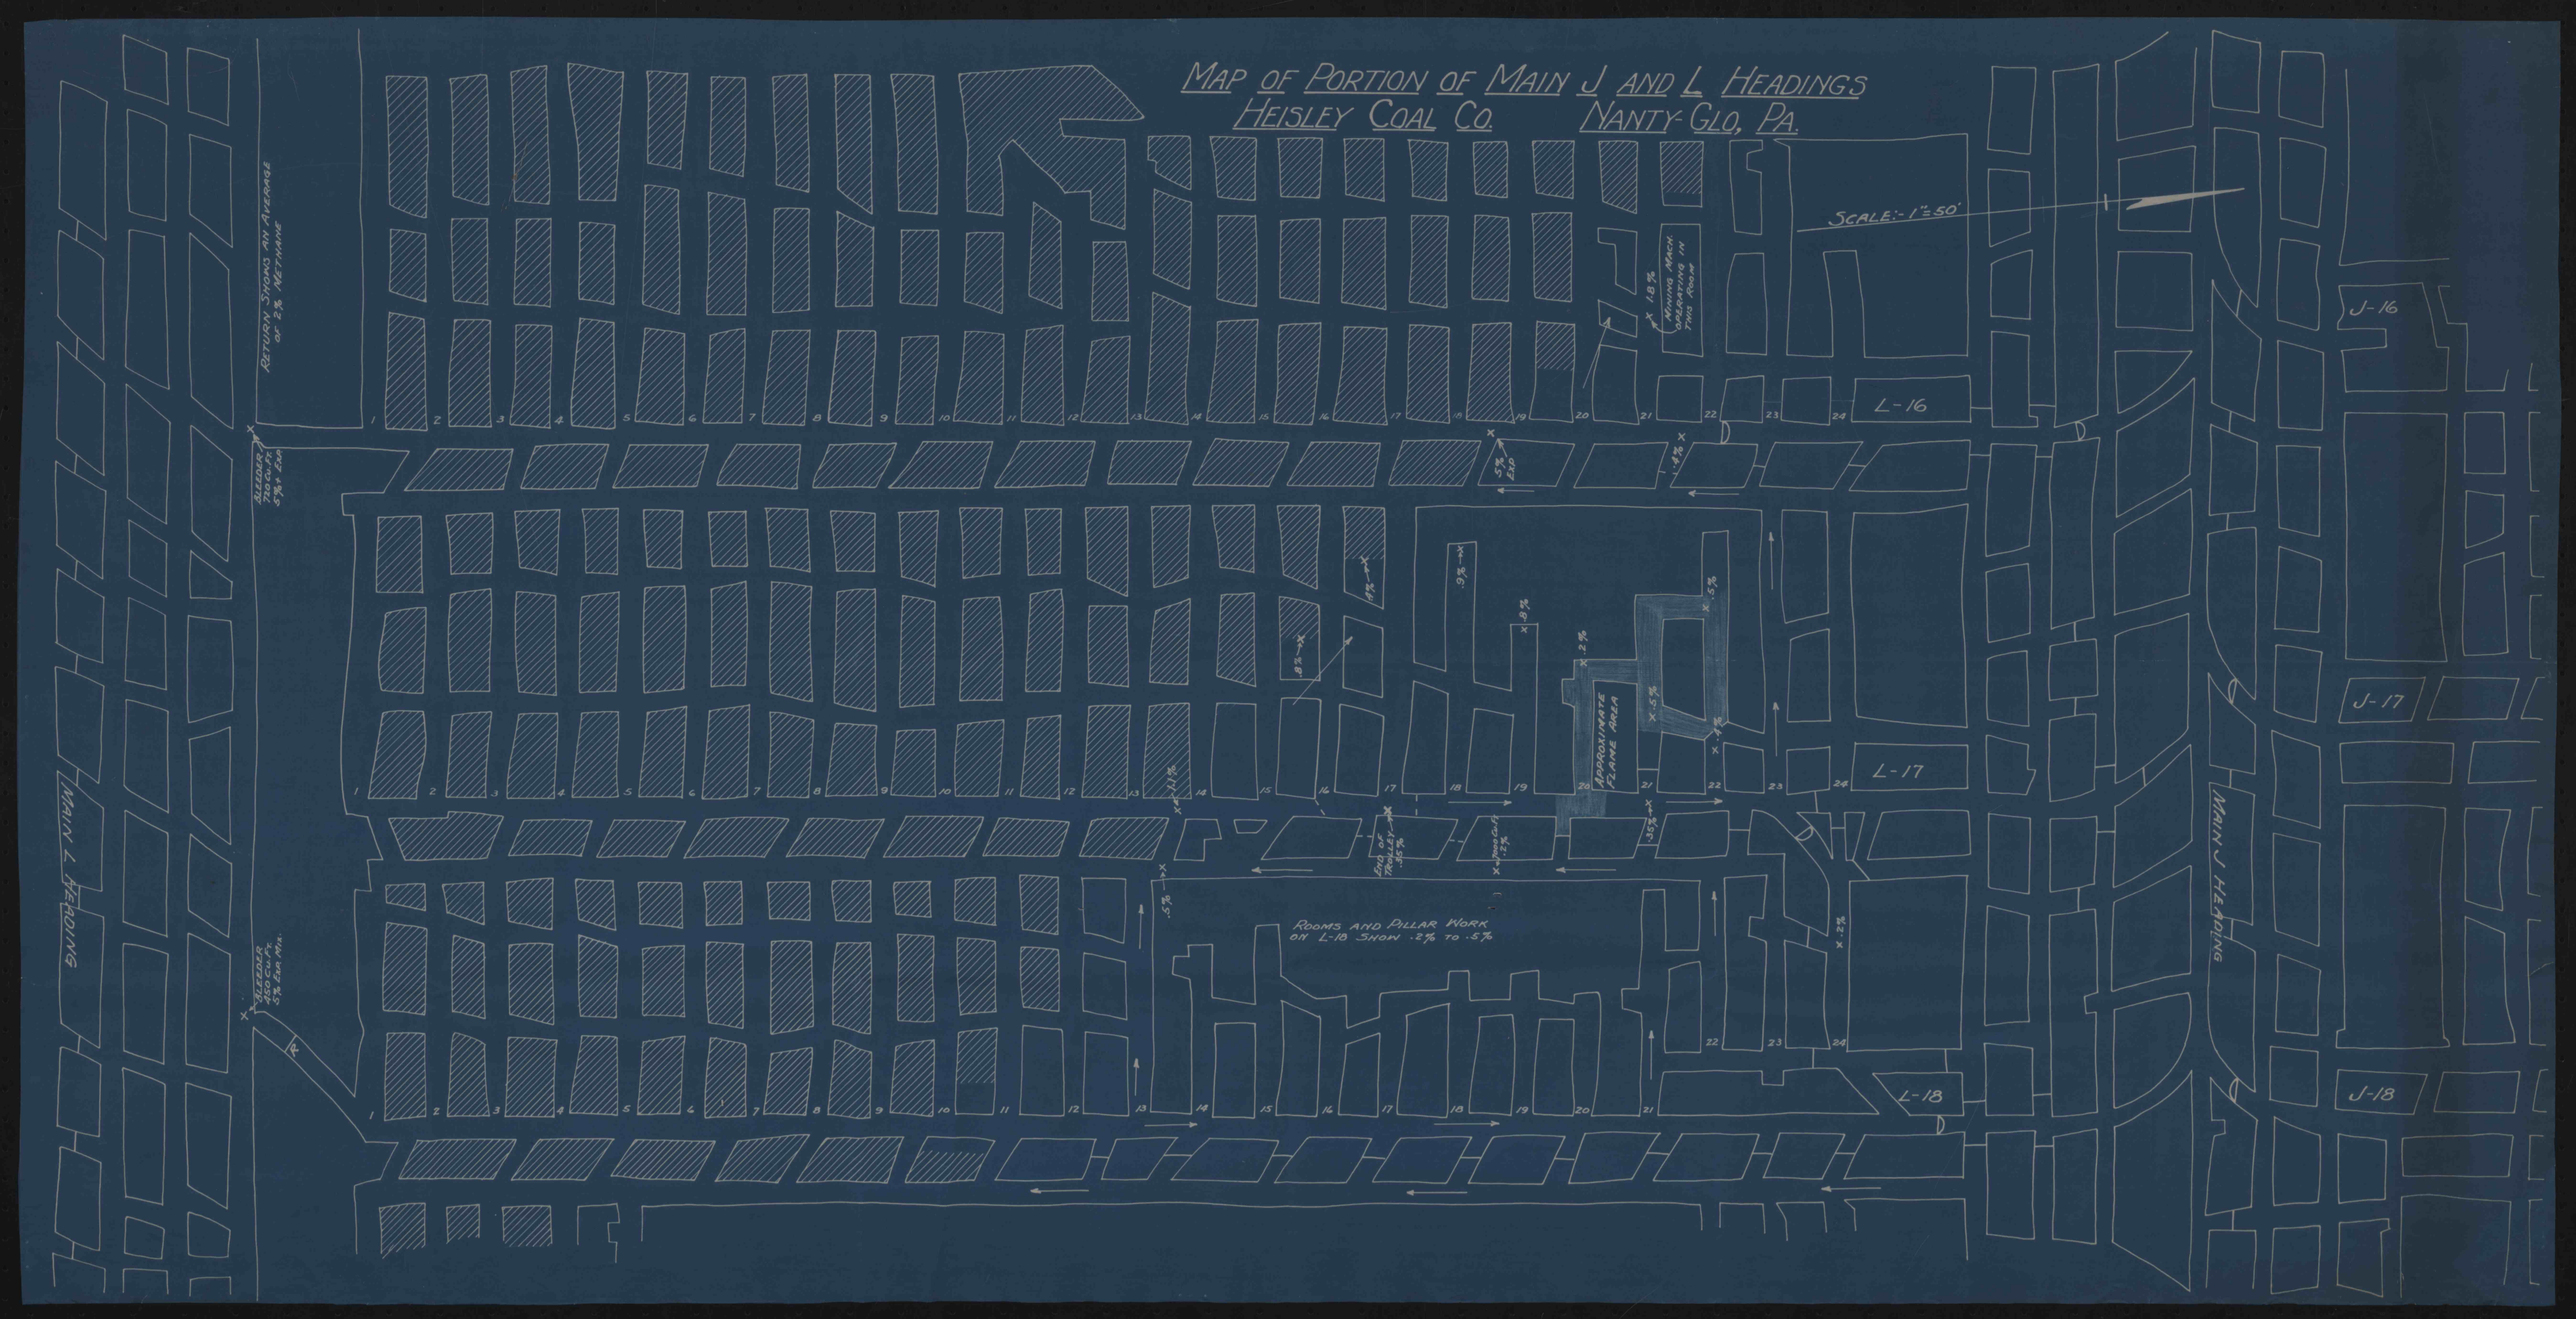MAP OF PORTION OF MAIN J AND L HEADINGS
HEISLEY COAL CO. NANTY-GLO, PA.