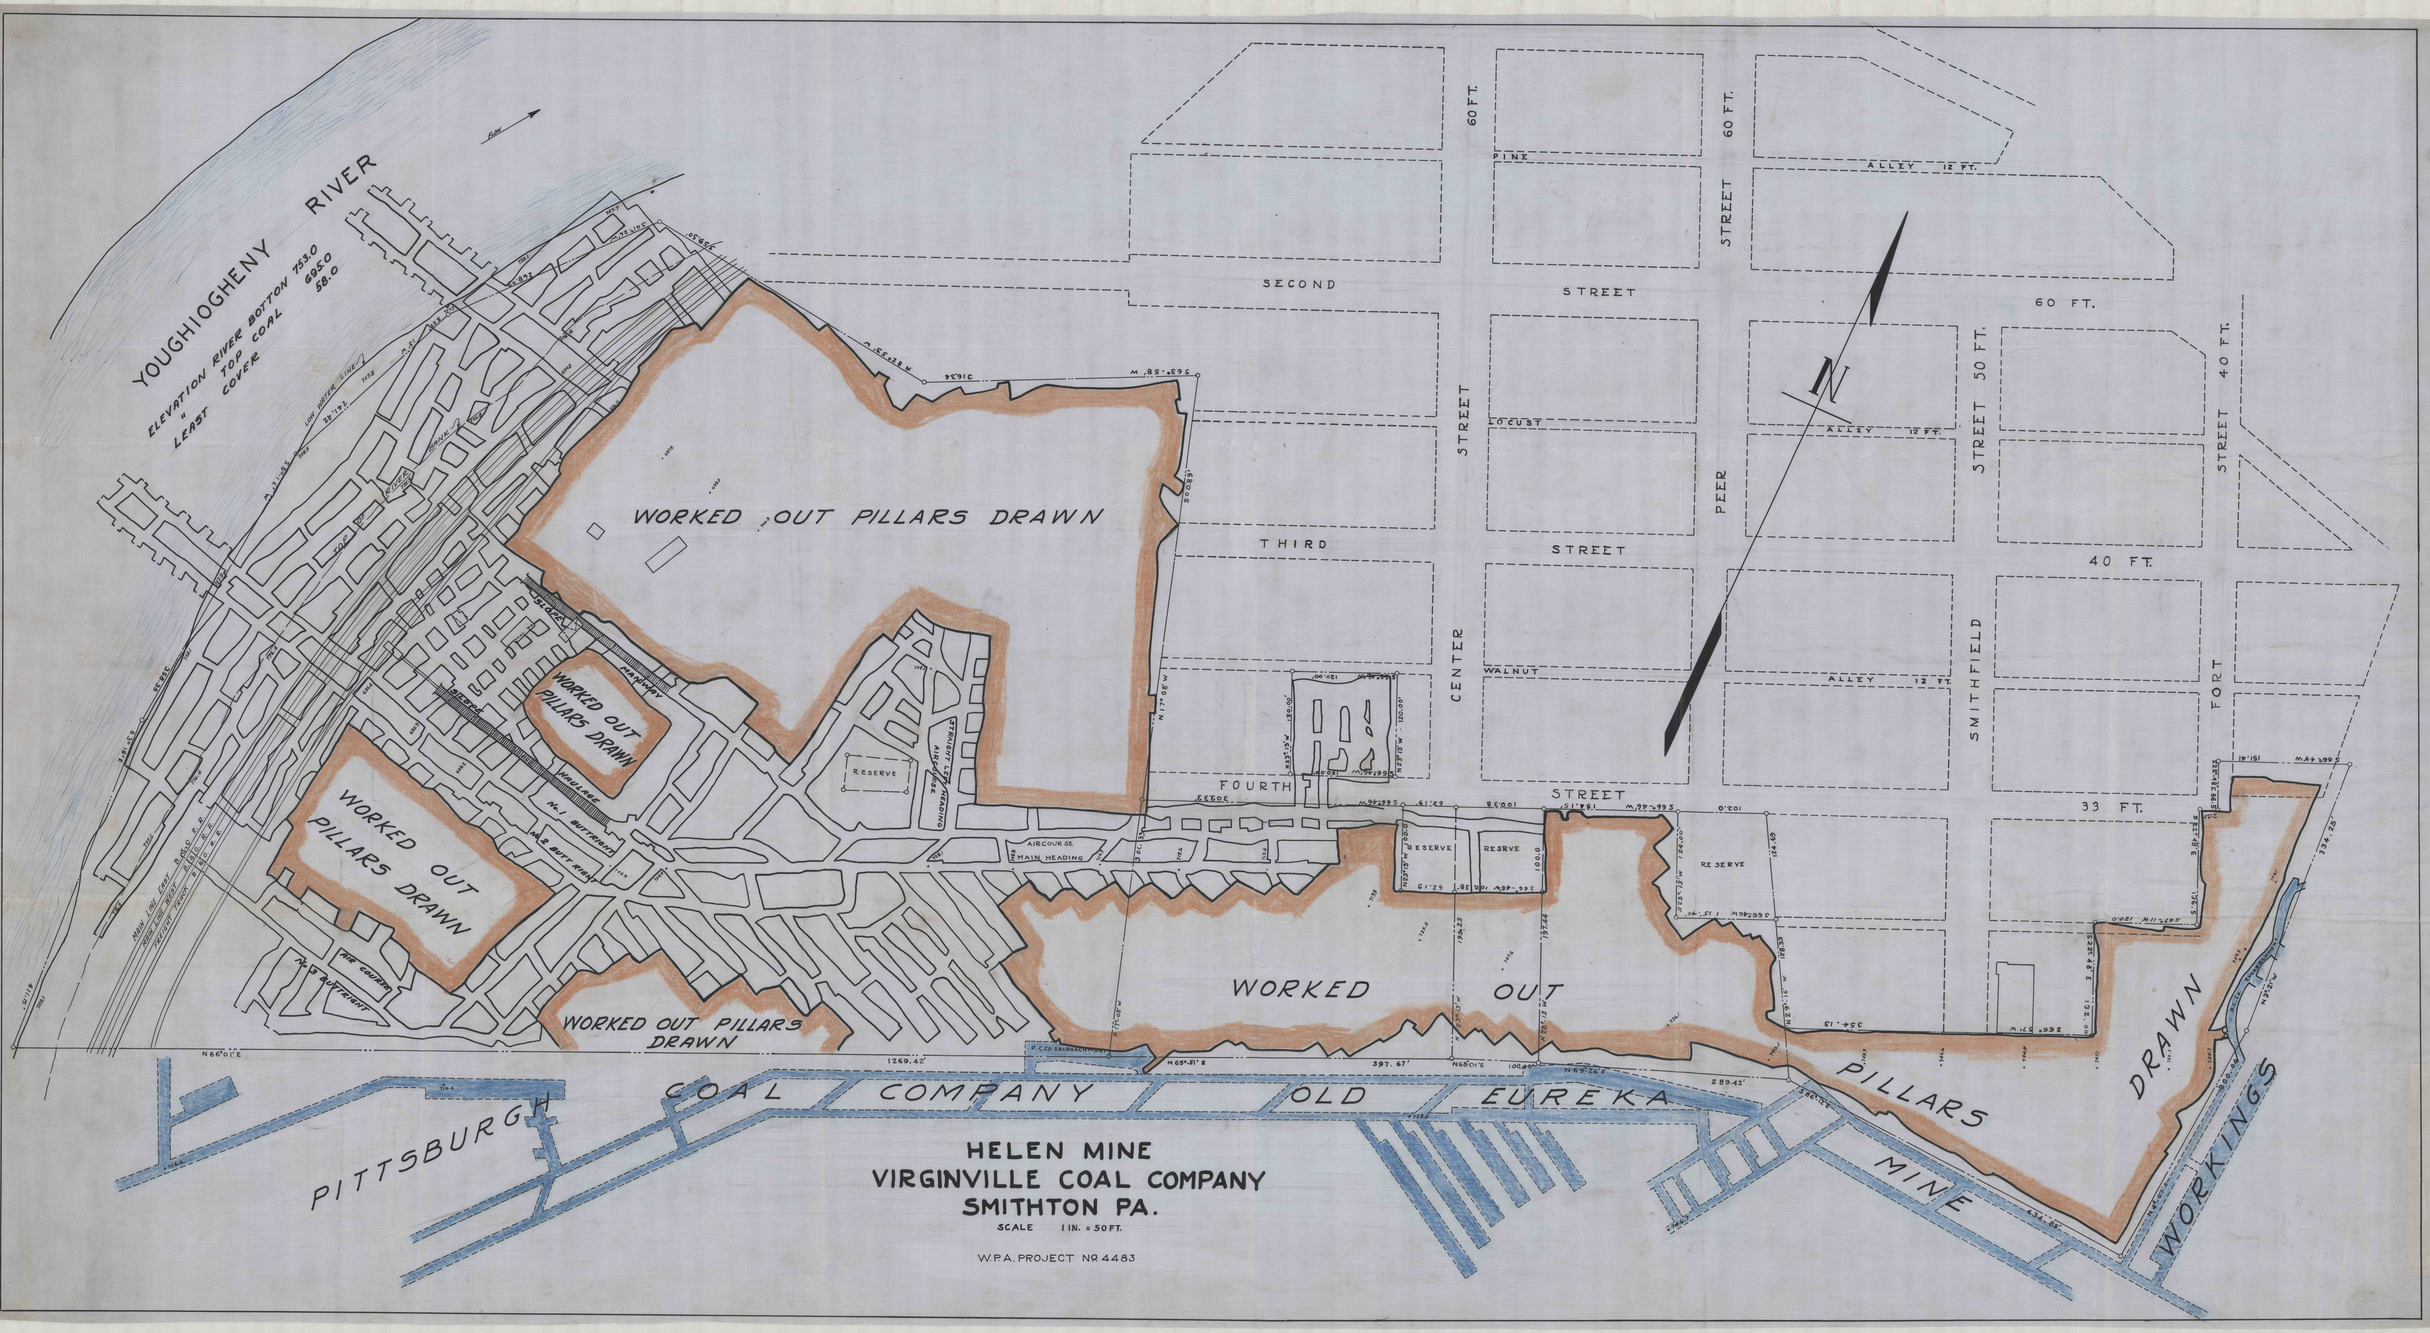

YOUGHIOGHENY RIVER
FLOW
ELEVATION RIVER BOTTON 753.0
" TOP COAL 695.0
LEAST COVER 58.0
LOW WATER LINE
TOP OF RIVER BANK
541°26'W
359.50'
268.09
241.42
S55°16'W
358.35
S30°18'W
411.15
MAIN LINE EAST B.&O. R.R.
MAIN LINE WEST B.&O. R.R.
FREIGHT TRACK B.&O. R.R.
SLOPE
SLOPE
MANWAY
HAULAGE
No. 1 BUTTRIGHT
No. 2 BUTT RIGHT
No. 3 BUTTRIGHT
AIR COURSE
WORKED OUT PILLARS DRAWN
WORKED OUT PILLARS DRAWN
WORKED OUT PILLARS DRAWN
WORKED OUT PILLARS DRAWN
N82°53'W
316.34
S63°58'W
500.89'
N17°08'W
RESERVE
STRAIGHT LEFT HEADING
AIRCOURSE
AIRCOURSE
MAIN HEADING
303.33
N66°01'E
1269.42'
P.C.CO. ENCROACHMENT
N65°51'E
397.67'
N68°01'E
100.40
N69°26'E
289.42'
S86°12'E
434.88'
N17°08'W
N23°13'W
N28°13'W
195.23
197.44
120.00'
S66°46'W
N23°13'W
120.00'
RESERVE
RESRVE
100.0
62.19
100.38
154.15
S66°46'W
102.0
124.00'
124.69
RESERVE
S66°46'W
115.90
128.33
N29°16'W
354.13
S66°57'W
132.00
S22°48'E
S67°11'W
120.0
136.5
S22°48'E
56.5
200
151.41
S66°49'W
334.25'
P.C.CO. ENCROACHMENT
N3°21'W
300.00
N44°07'E
SECOND STREET
THIRD STREET
FOURTH STREET
PINE ALLEY 12 FT.
LOCUST ALLEY 12 FT.
WALNUT ALLEY 12 FT.
CENTER STREET 60 FT.
PEER STREET 60 FT.
SMITHFIELD STREET 50 FT.
FORT STREET 40 FT.
60 FT.
40 FT.
33 FT.
N
WORKED OUT PILLARS DRAWN
PITTSBURGH COAL COMPANY OLD EUREKA MINE WORKINGS

HELEN MINE
VIRGINVILLE COAL COMPANY
SMITHTON PA.

SCALE 1 IN. = 50 FT.

W.P.A. PROJECT No. 4483