

8-4-99
1307


March 16, 1923
Dec. 31, 1923
Engr.

Plan showing P.R.R. Coal Co. Mine
Site at
Frye Station, Garroll Twp., Wash. Co., Pennsylvania
Scale 1"=50'

The cross-hatch on this tracing indicates the mine
workings as of date of Dec. 31, 1923, showing
complete exhaustion of all coal in this tract,
mine being finished and abandoned as such
H. L. McVicker
Civil & Mining Engineer

M. & W. R. R. Co.

I, Oly. A. Mollik, do hereby certify that said
tracing is a true and correct copy of the original
map of said mine and that the original map is a
true, complete, and correct map and survey of
all excavations made in abandoned mine.
Oly. A. Mollik, C. & M. Engr.
Jan. 31, 1924

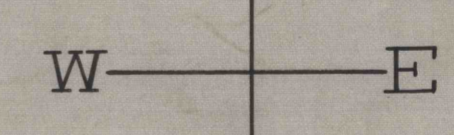

Pittsburg Coal Co.

APPROVED