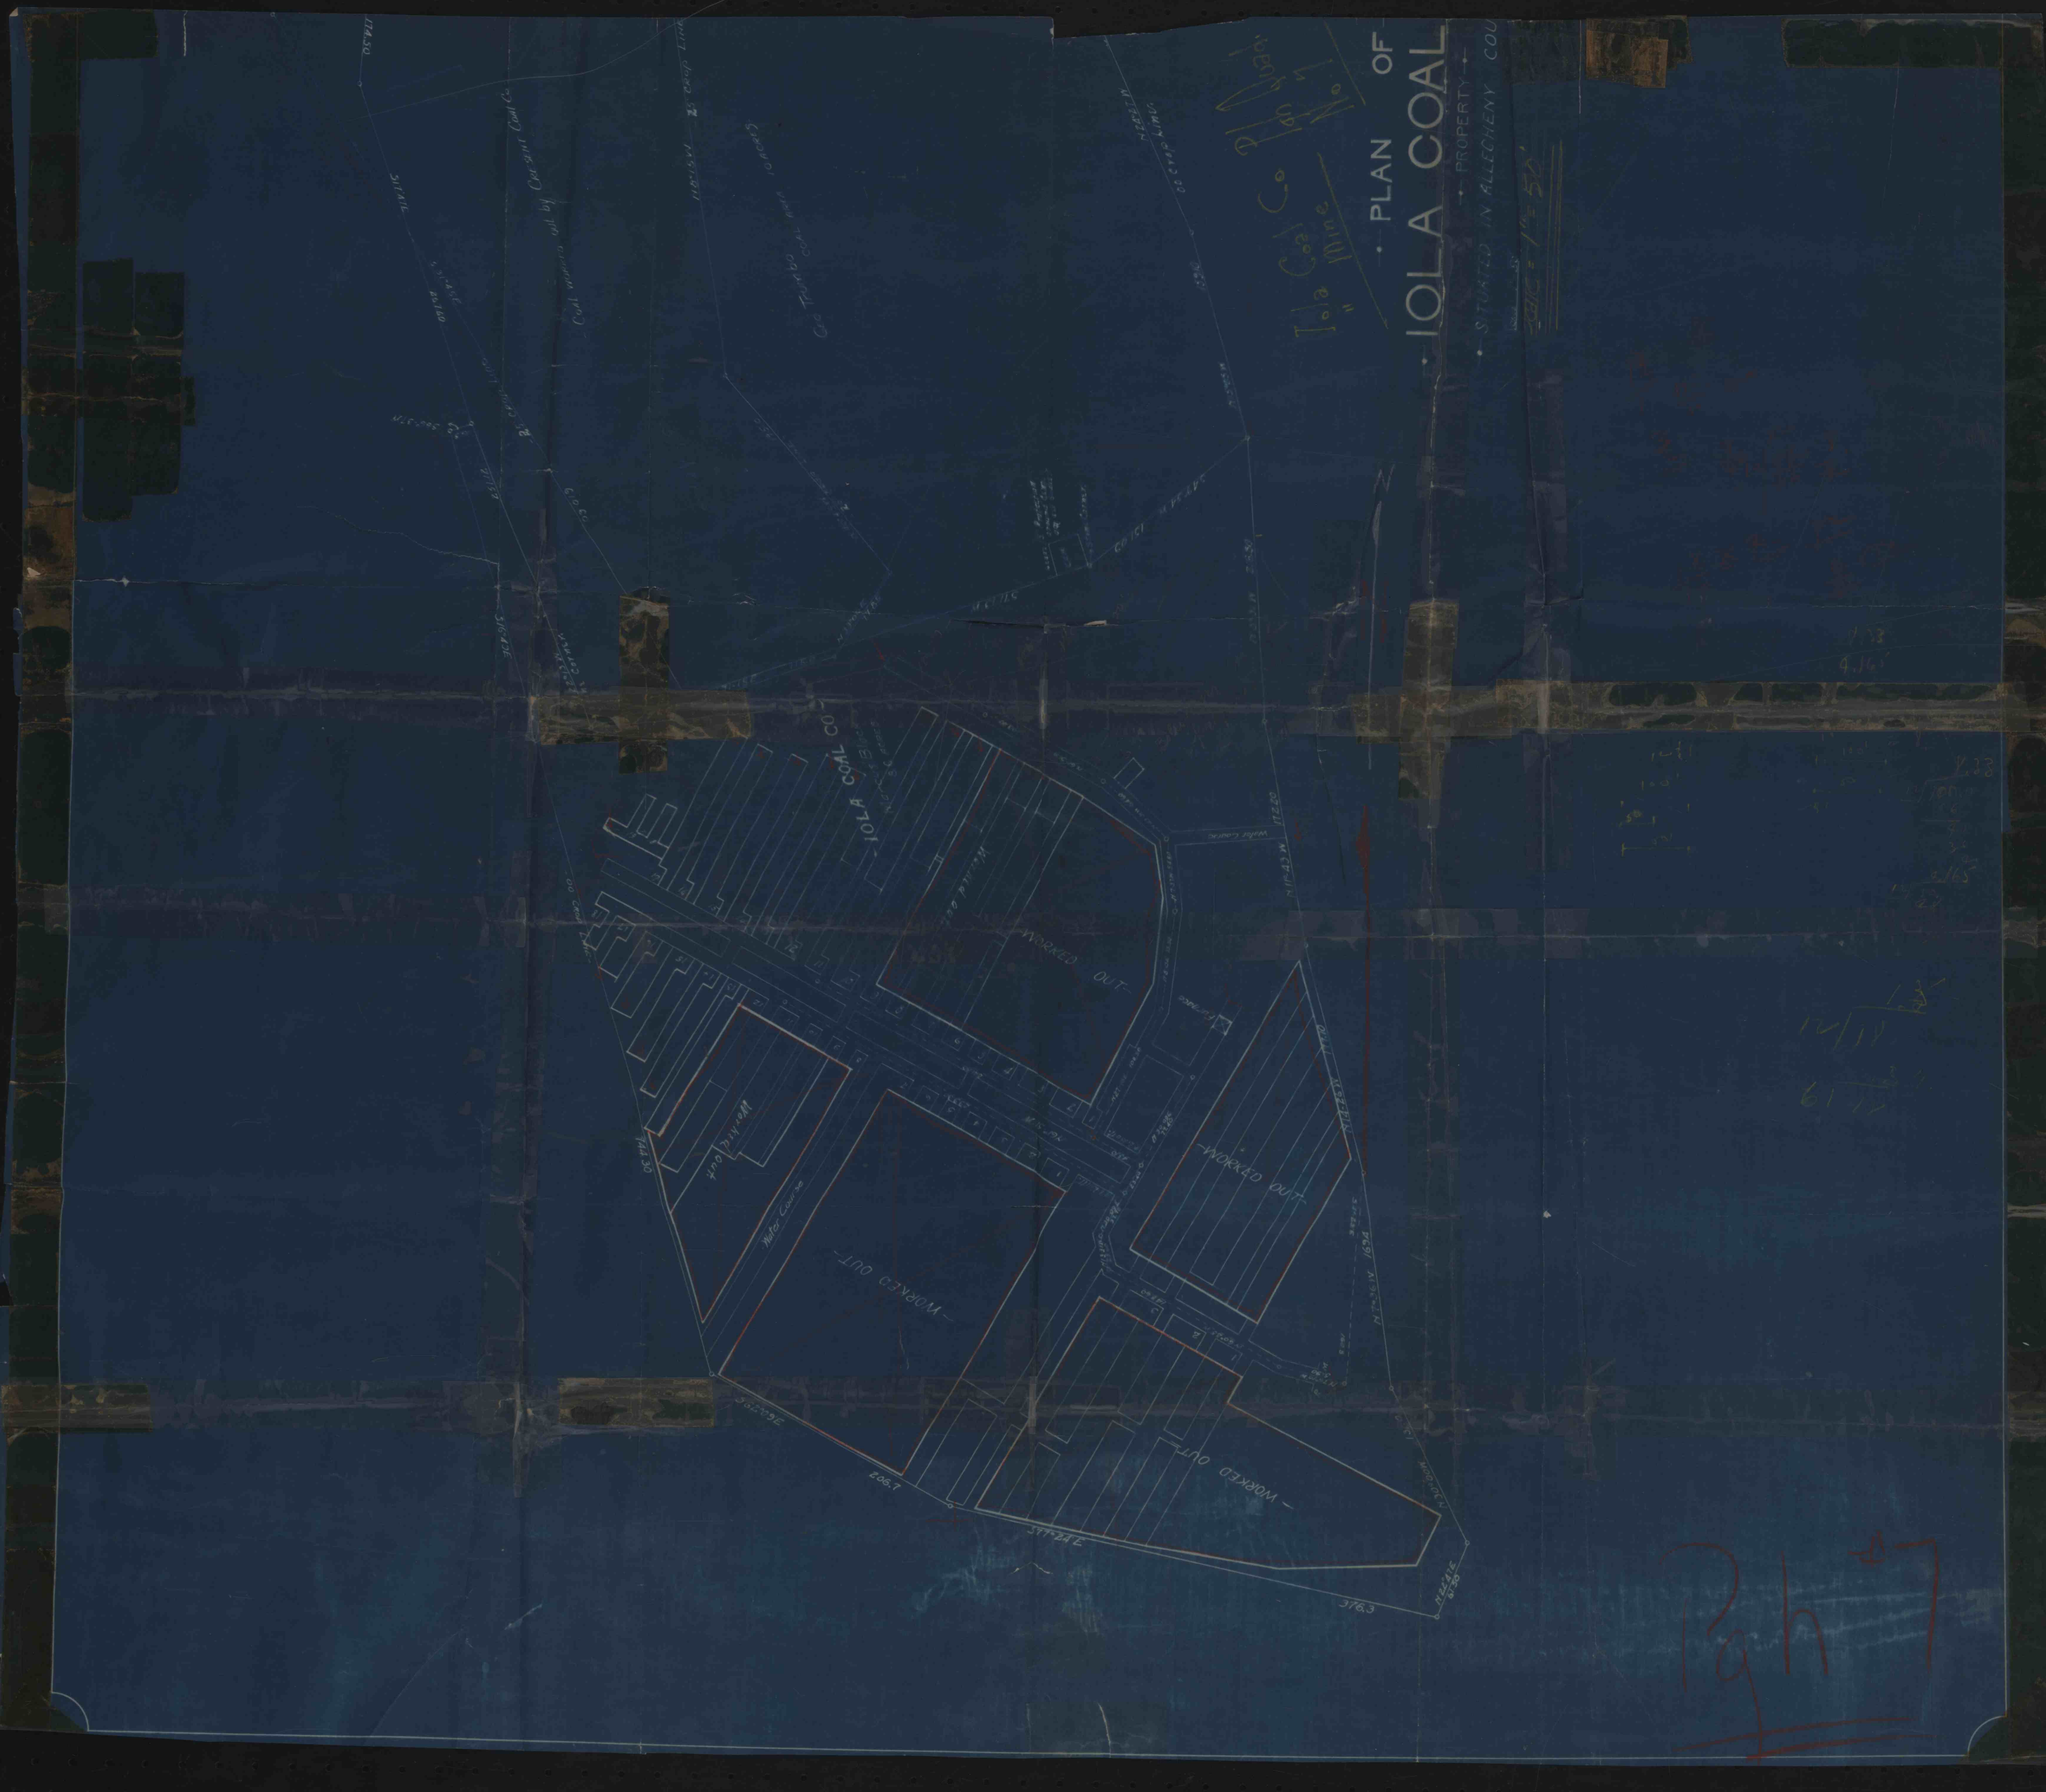
PLAN OF
IOLA COAL
PROPERTY
SITUATED IN ALLEGHENY COU
Iola Coal Co
Mine
IOLA COAL CO
Coal worked out by Cresent Coal Co.
Geo Trumbo Coal Area 10 Acres
25 Crop Line
00 Crop Line
174.50
744.30
WORKED OUT
Worked out
Water Course
Furnace
206.7
S77°24'E
376.3
1694
Pgh 7