


KENDALL #2 MINE,
KENDALL COAL CO.

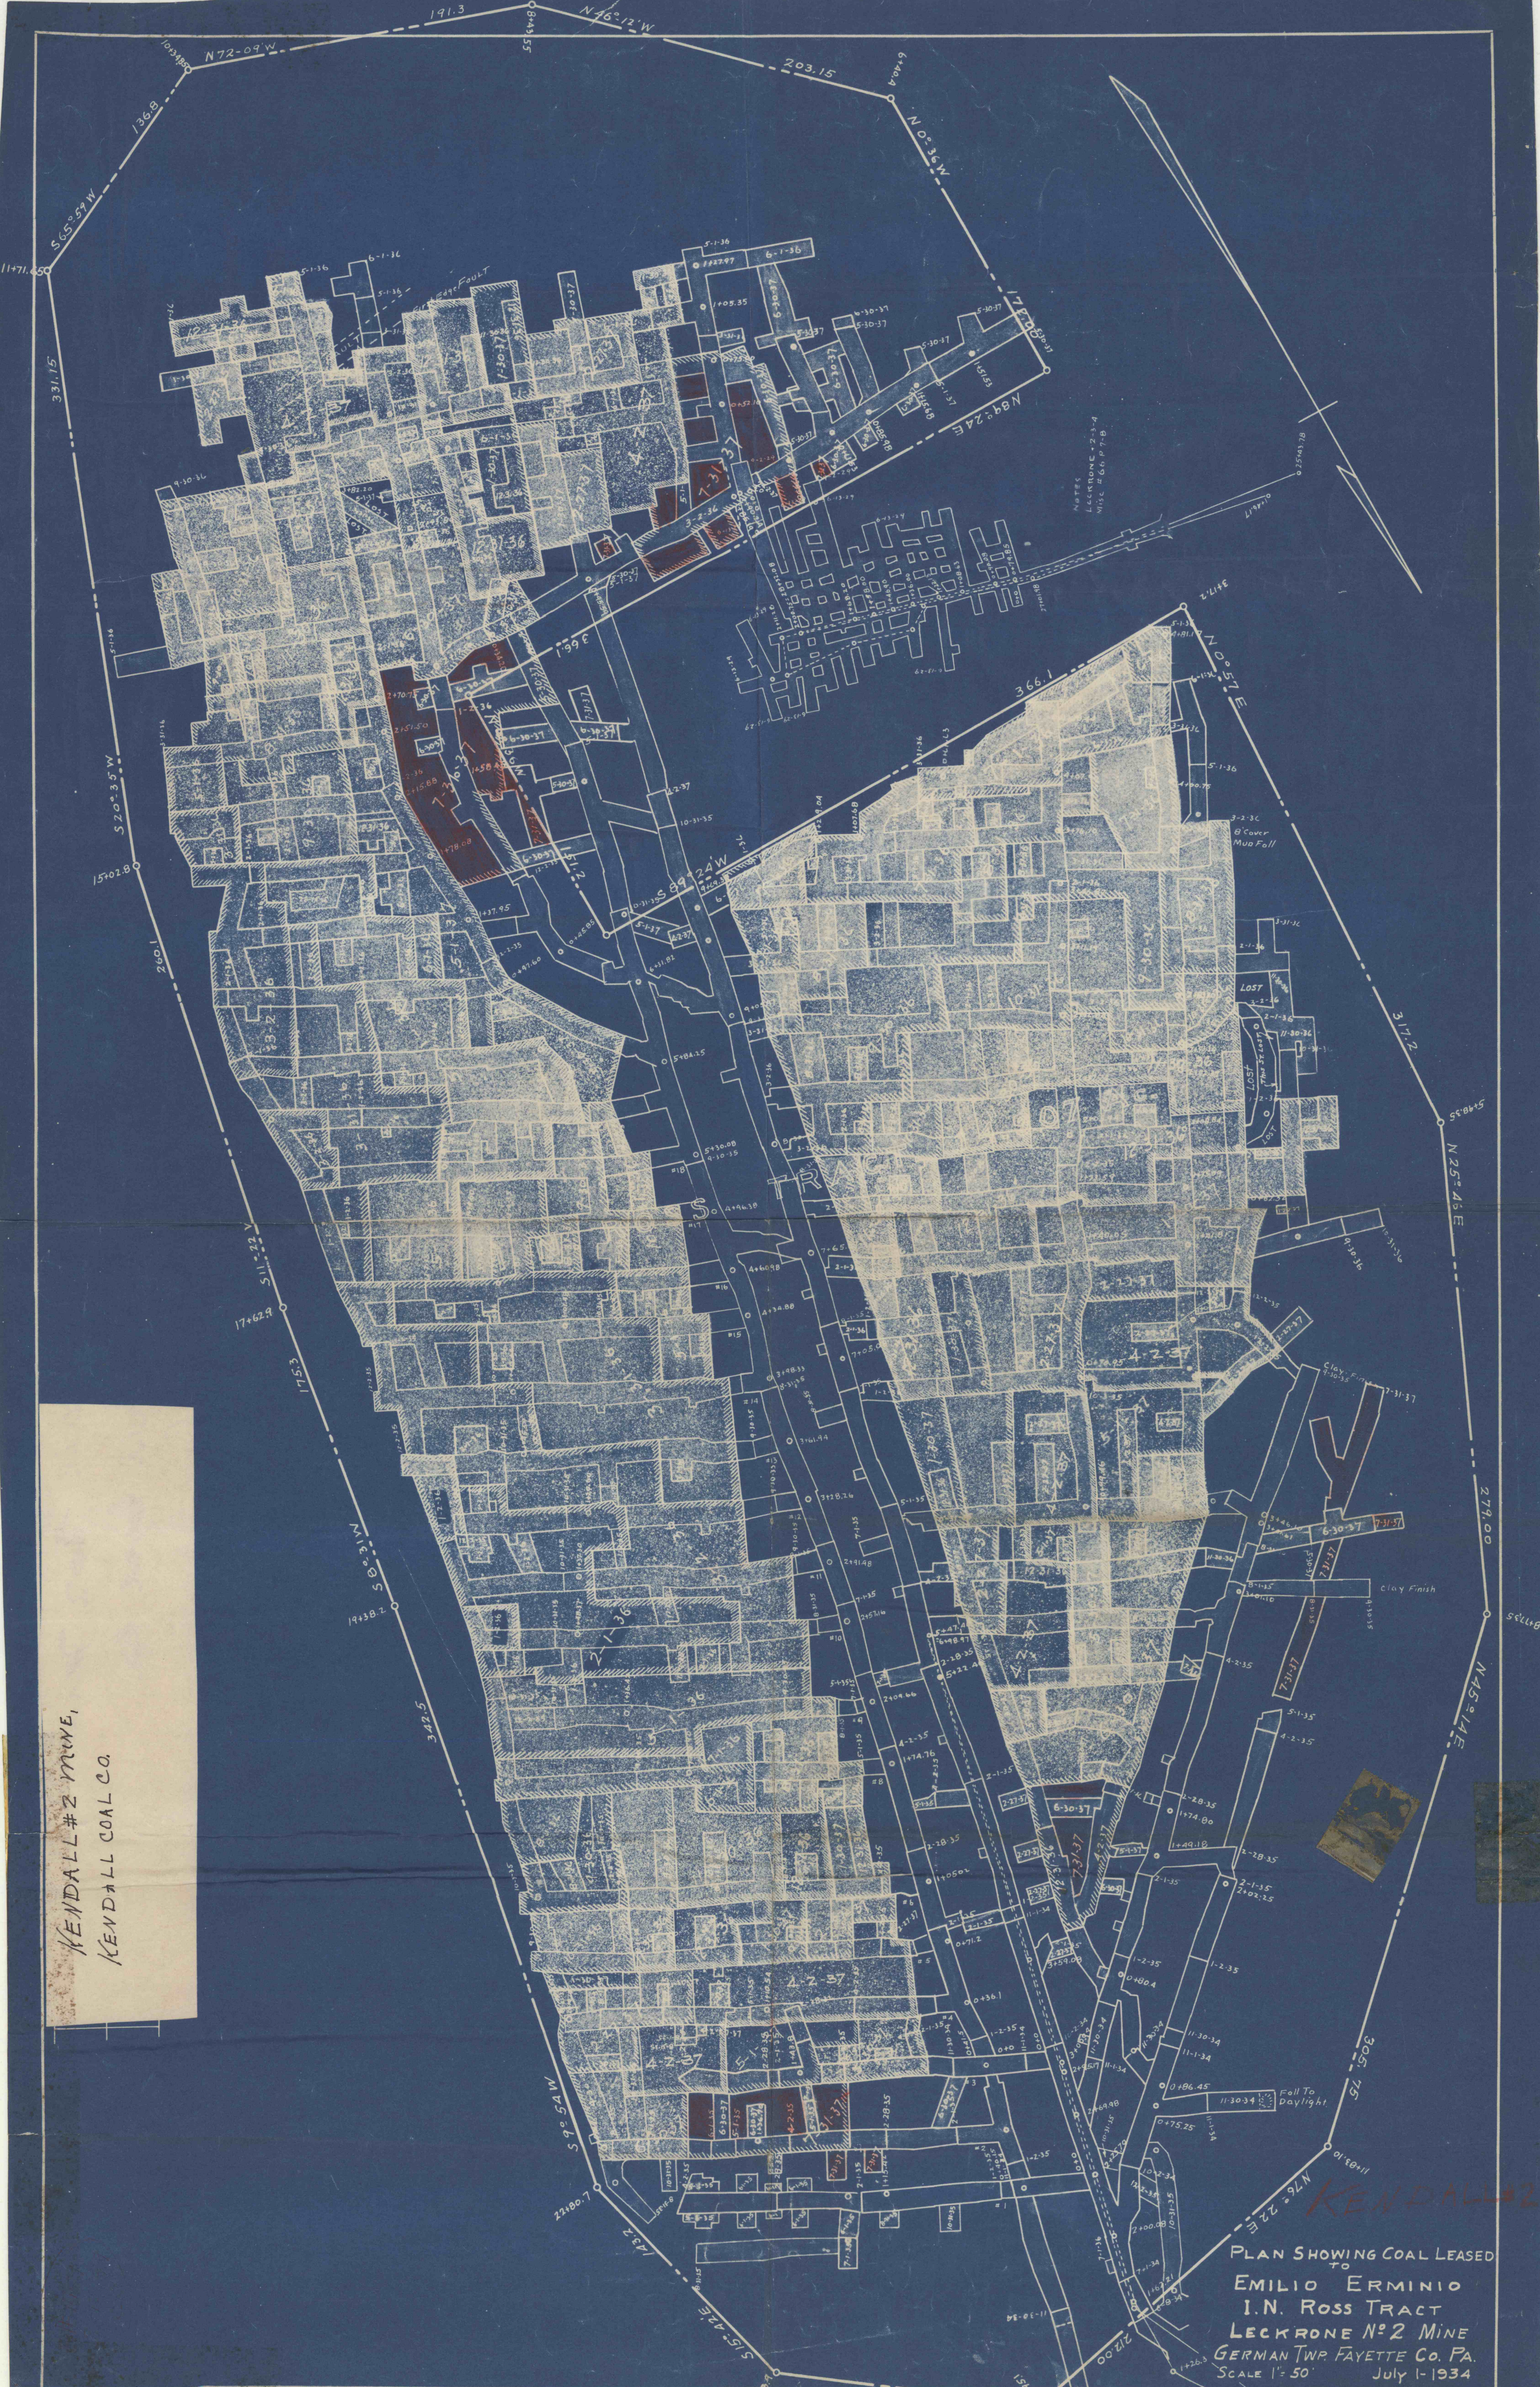

PLAN SHOWING COAL LEASED
TO
EMILIO ERMINIO
I. N. ROSS TRACT
LECKRONE NO 2 MINE
GERMAN TWP FAYETTE CO. PA.
SCALE 1" = 50'
July 1-1934

14-C-19