

ED. BYERS

OLD WORKS

FLORELLA RANKIN

PHOEBE RANKIN

OLD WORKS

LEIDECKER



OLD WORKS

B.C.C. CO.

VANDYKE

OLD WORKS

OLD WORKS

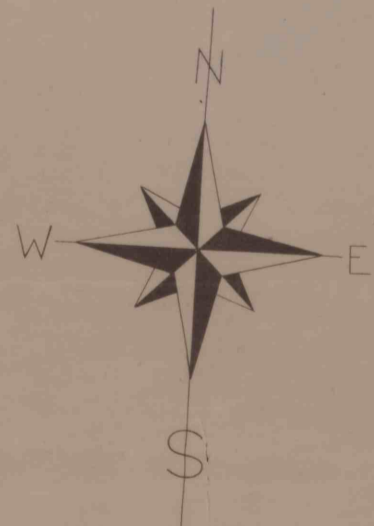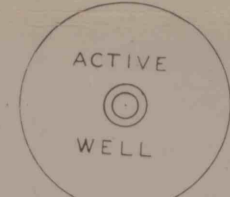

BUTLER CONSOLIDATED COAL CO.
KINCAID MINE NO. 3

SITUATE IN
FAIRVIEW TOWNSHIP BUTLER CO. PA.
SCALE 1" = 100' OCTOBER 1945

SURVEY EXTENDED TO - MARCH 31, 1950 SURVEYED BY - C. FRED LOUCKS

Handwritten initials: HMB, 1-10-45, EC