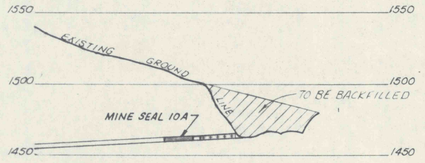

SECTION J-J'

SCALE 1"=50'

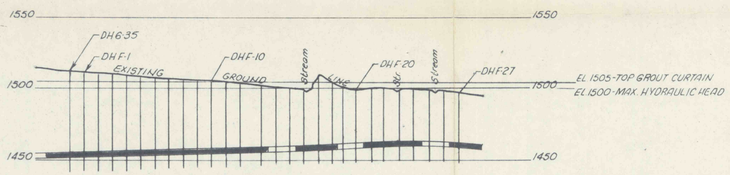

SECTION I-I'

SCALE: 1"=50'

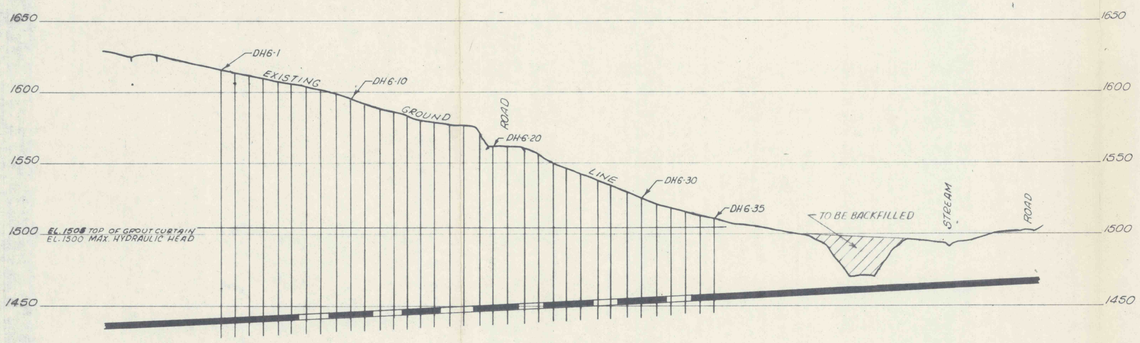

SECTION H-H'

SCALE: 1"=50'

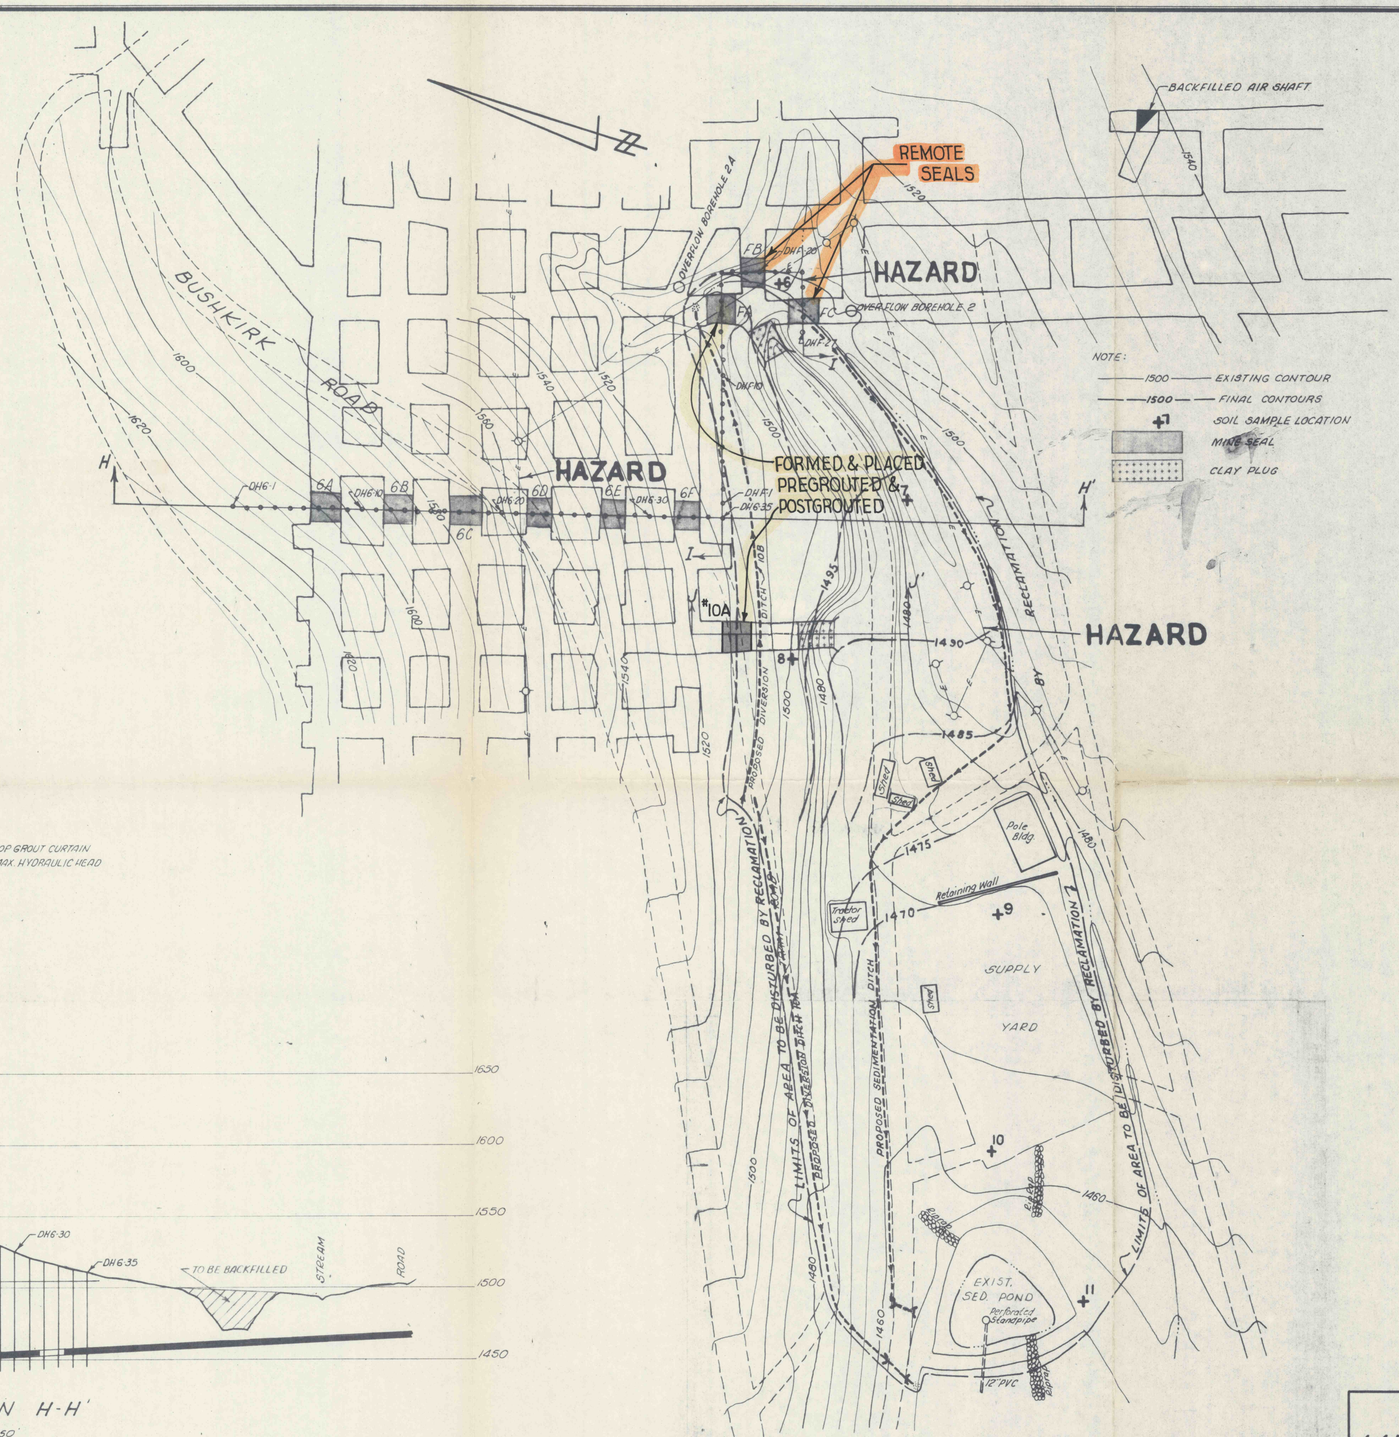

PLAN OF MINE SEALS No 6, 10, FAN & OVERFLOW BOREHOLE 2
DEEP MINE HYDRAULIC SEALS & PRESSURE GROUTING DRILL HOLES

SCALE: 1"=50'

REVISIONS 22 MAR 85 L.A.B.

MINE CLOSURE PLAN
FOR
LADY JANE COLLIERIES, INC.
MINE SEAL AREAS 6, 10, FAN
& OVERFLOW BOREHOLE 2
HUSTON TWP., CLEARFIELD CO., PA.

SCALE	GWIN, DOBSON & FOREMAN, INC. CONSULTING ENGINEERS ALTOONA, PENNSYLVANIA	SHEET NO
1"=50'		6 of 12

17 0543 EX SMITH A. B. B. SMITH CO. PGH., PA.

PR 9879-976