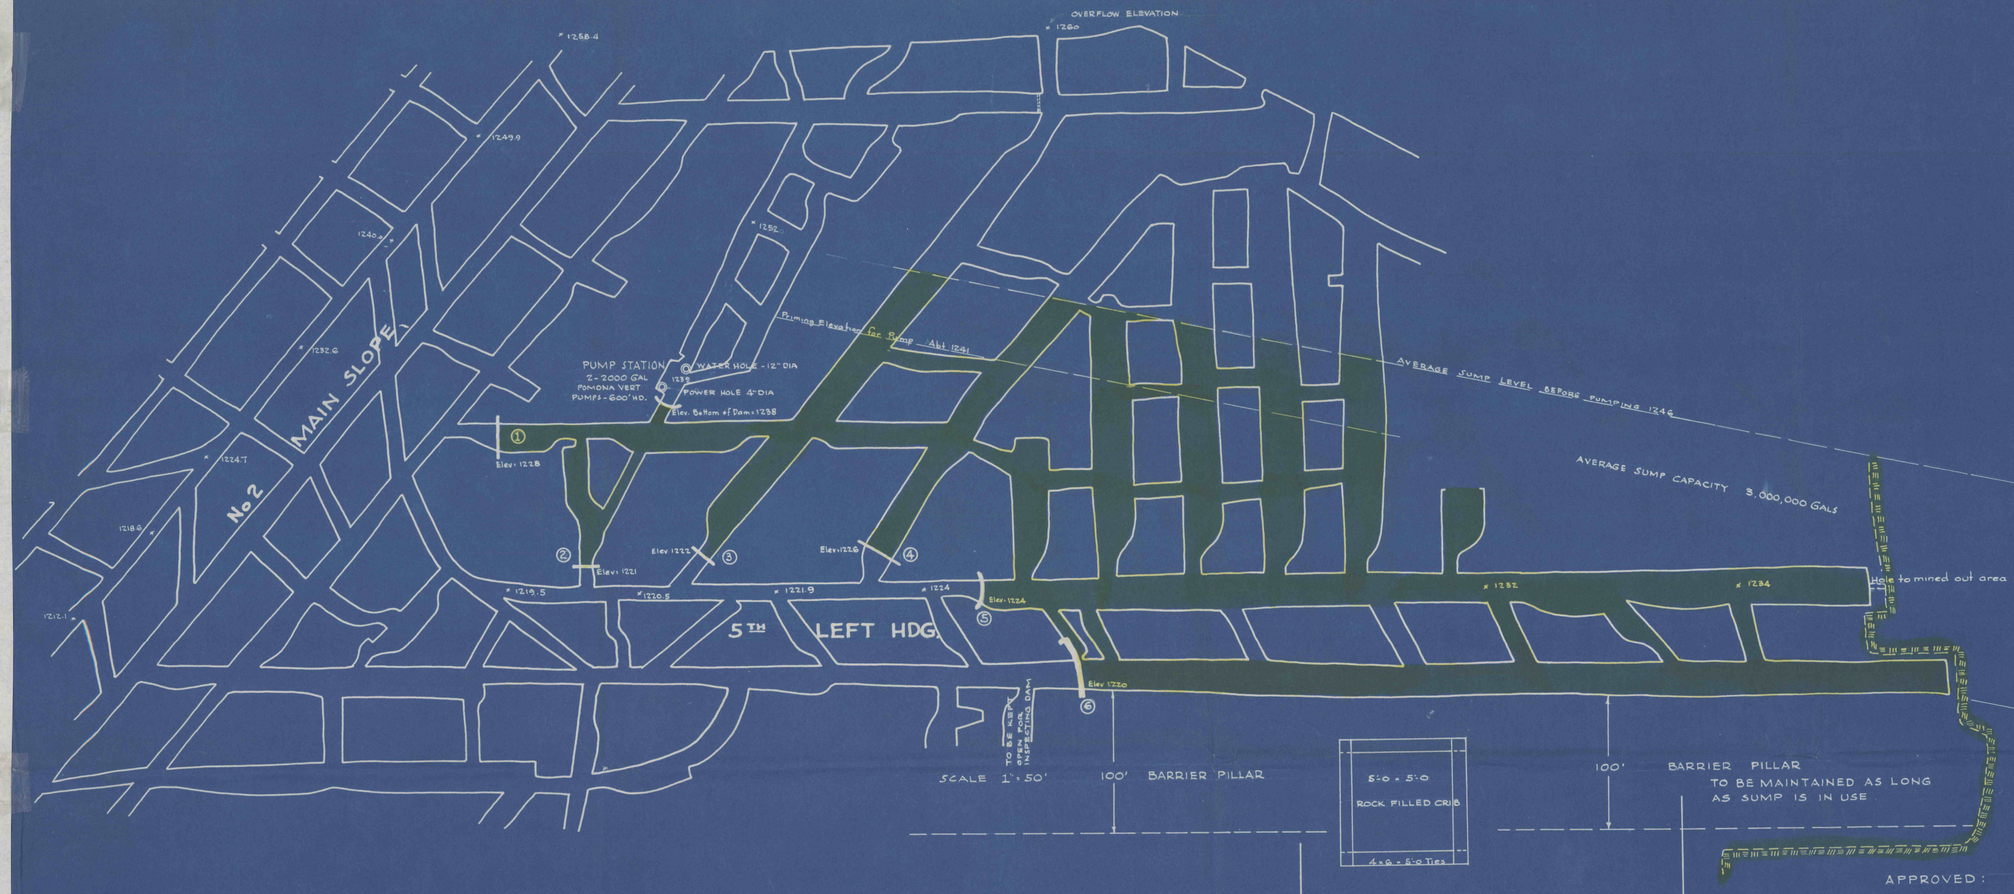

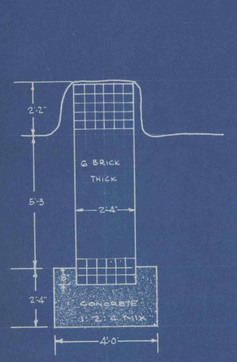

CROSS SECTION

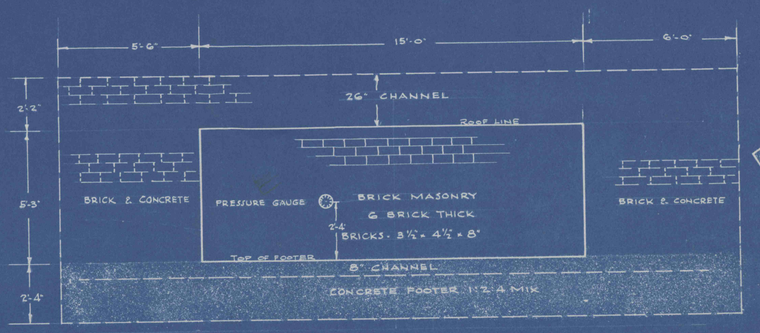

FRONT ELEVATION

DAM No 5

SCALE 3/8" = 1'-0"

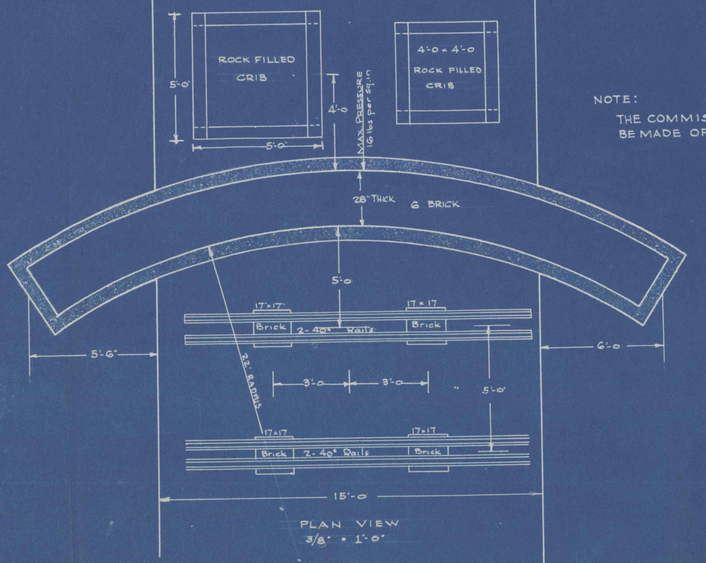

PLAN VIEW

3/8" = 1'-0"

APPROVED:

COMMISSION:

INSPECTOR - 6TH DISTRICT

INSPECTOR - 20TH DISTRICT

INSPECTOR - 24TH DISTRICT

NOTE:

THE COMMISSION RECOMMENDS THAT PERIODIC INSPECTIONS BE MADE OF THE DAMS.

WE THE UNDERSIGNED HAVE PERSONALLY SUPERVISED AND/OR INSPECTED THE WORK DURING CONSTRUCTION OF THE DAMS ALL DIMENSIONS HAVE BEEN FOLLOWED AND ALL MATERIALS USED ARE AS SHOWN IN THE SPECIFICATIONS.

ASST. SUPERINTENDENT

CONSTRUCTION FOREMAN

MINING ENGINEER

JOHNSTOWN COAL & COKE CO.

DAMS BUILT IN 5TH LT. HDG - No 2 MAIN

LOGAN No 4 MINE - BEAVERDALE, PA.

SCALES AS SHOWN MAY - 1943

ANDREW B. CRICHTON
MINING ENGINEER
JOHNSTOWN, PENNA.

SHEET No 1