
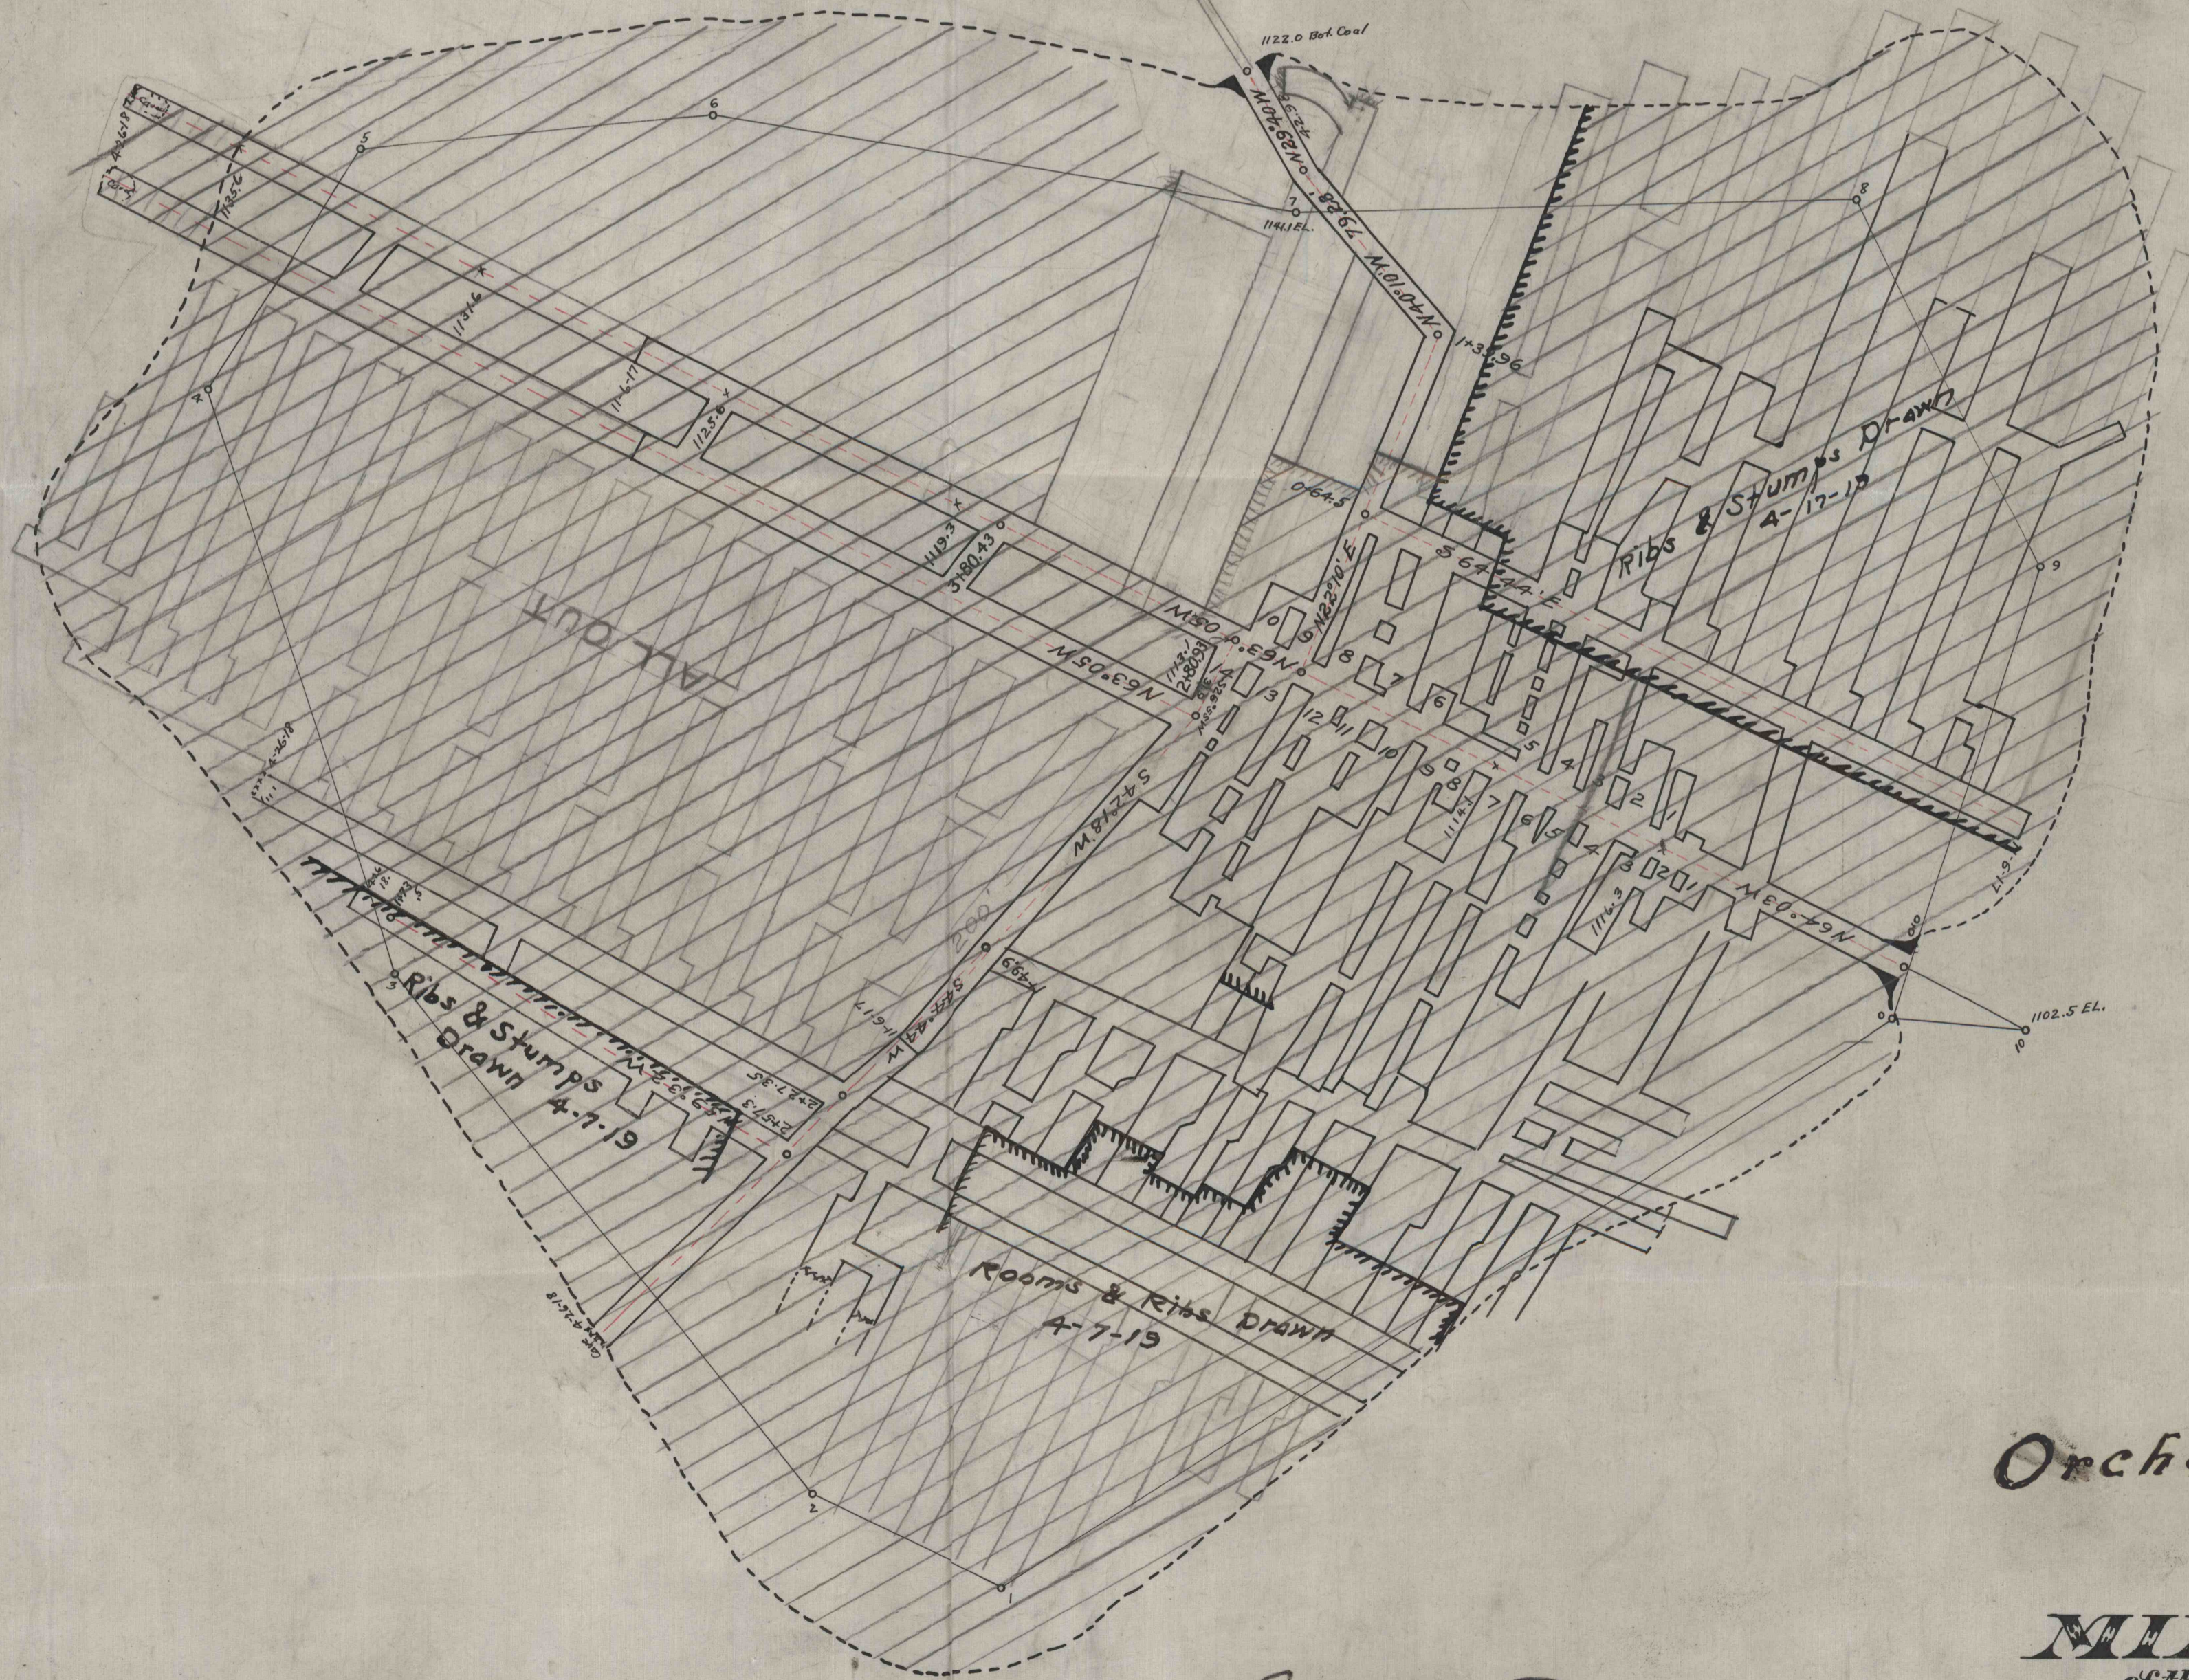
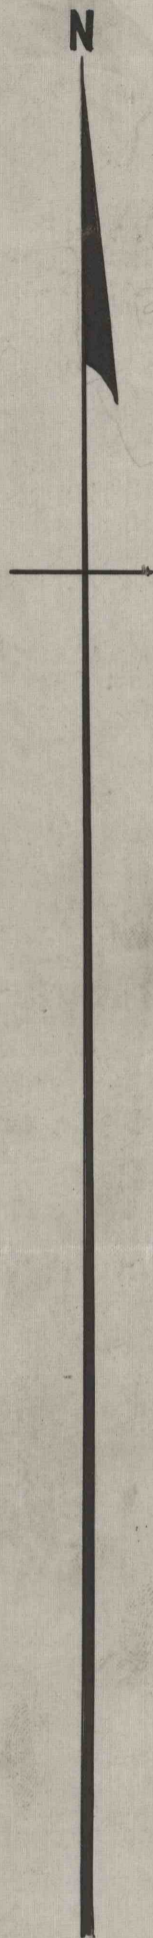



319251

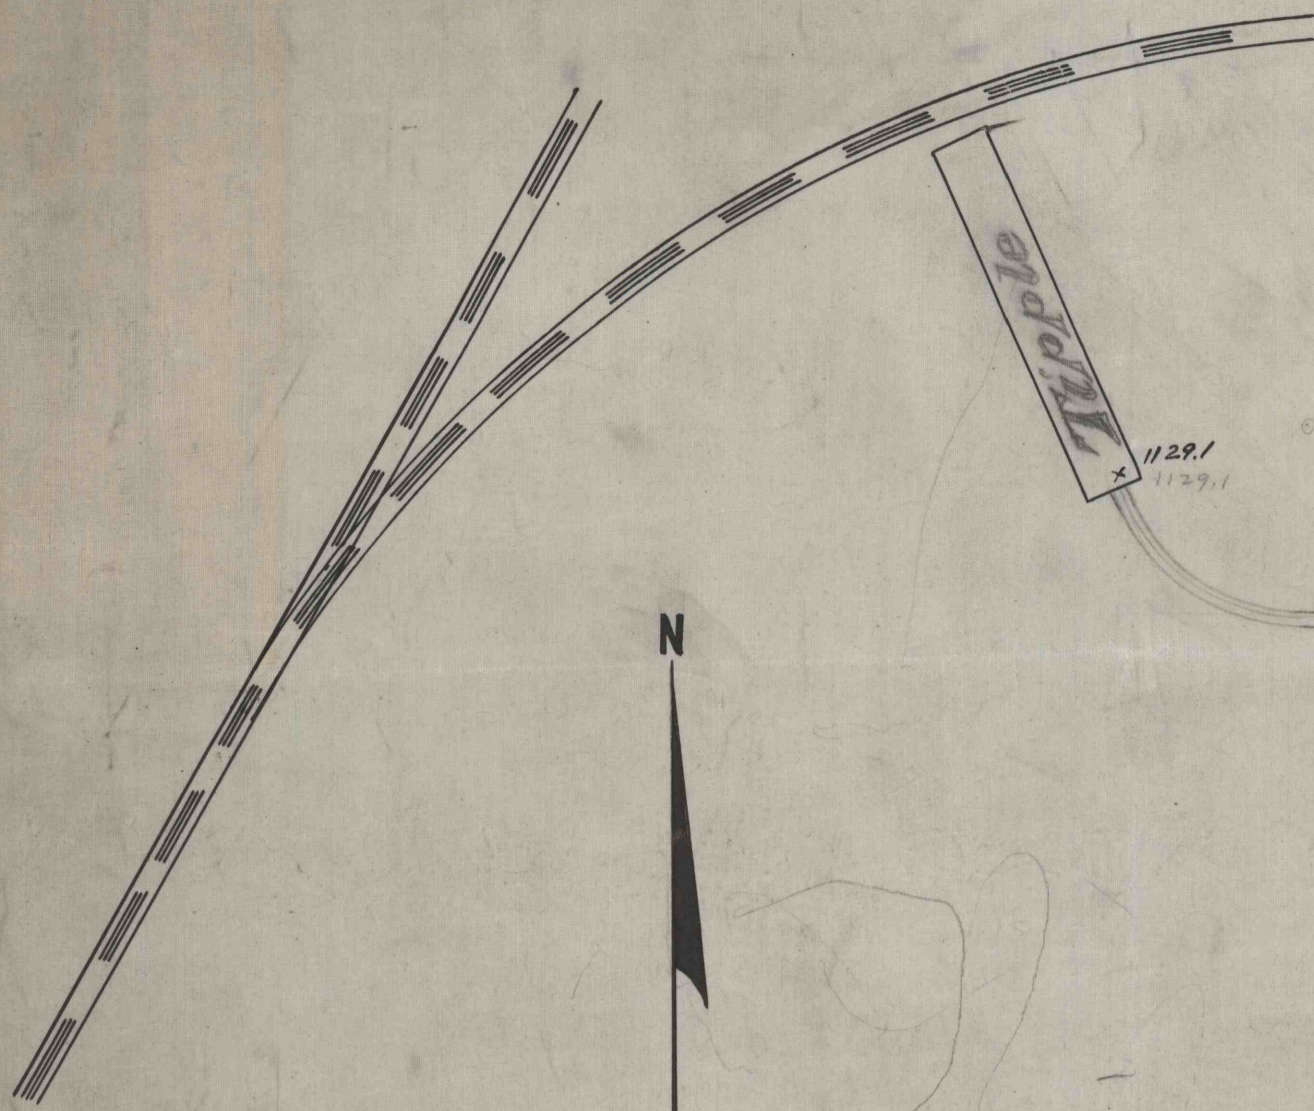

Orchard Hill

George B. TAYLOR ~~ENGINEER~~
of the
Hempfield Twp. Westmoreland Co. Pa.
Scale 1" = 50' 11-10-17.

April 24-1918
April 17-1919

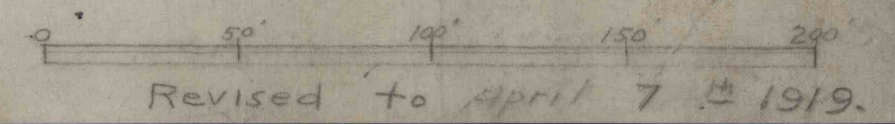

Revised to April 7 1919.

#2000
12-23-99
C.C.