


FIT to Sheet No. 2

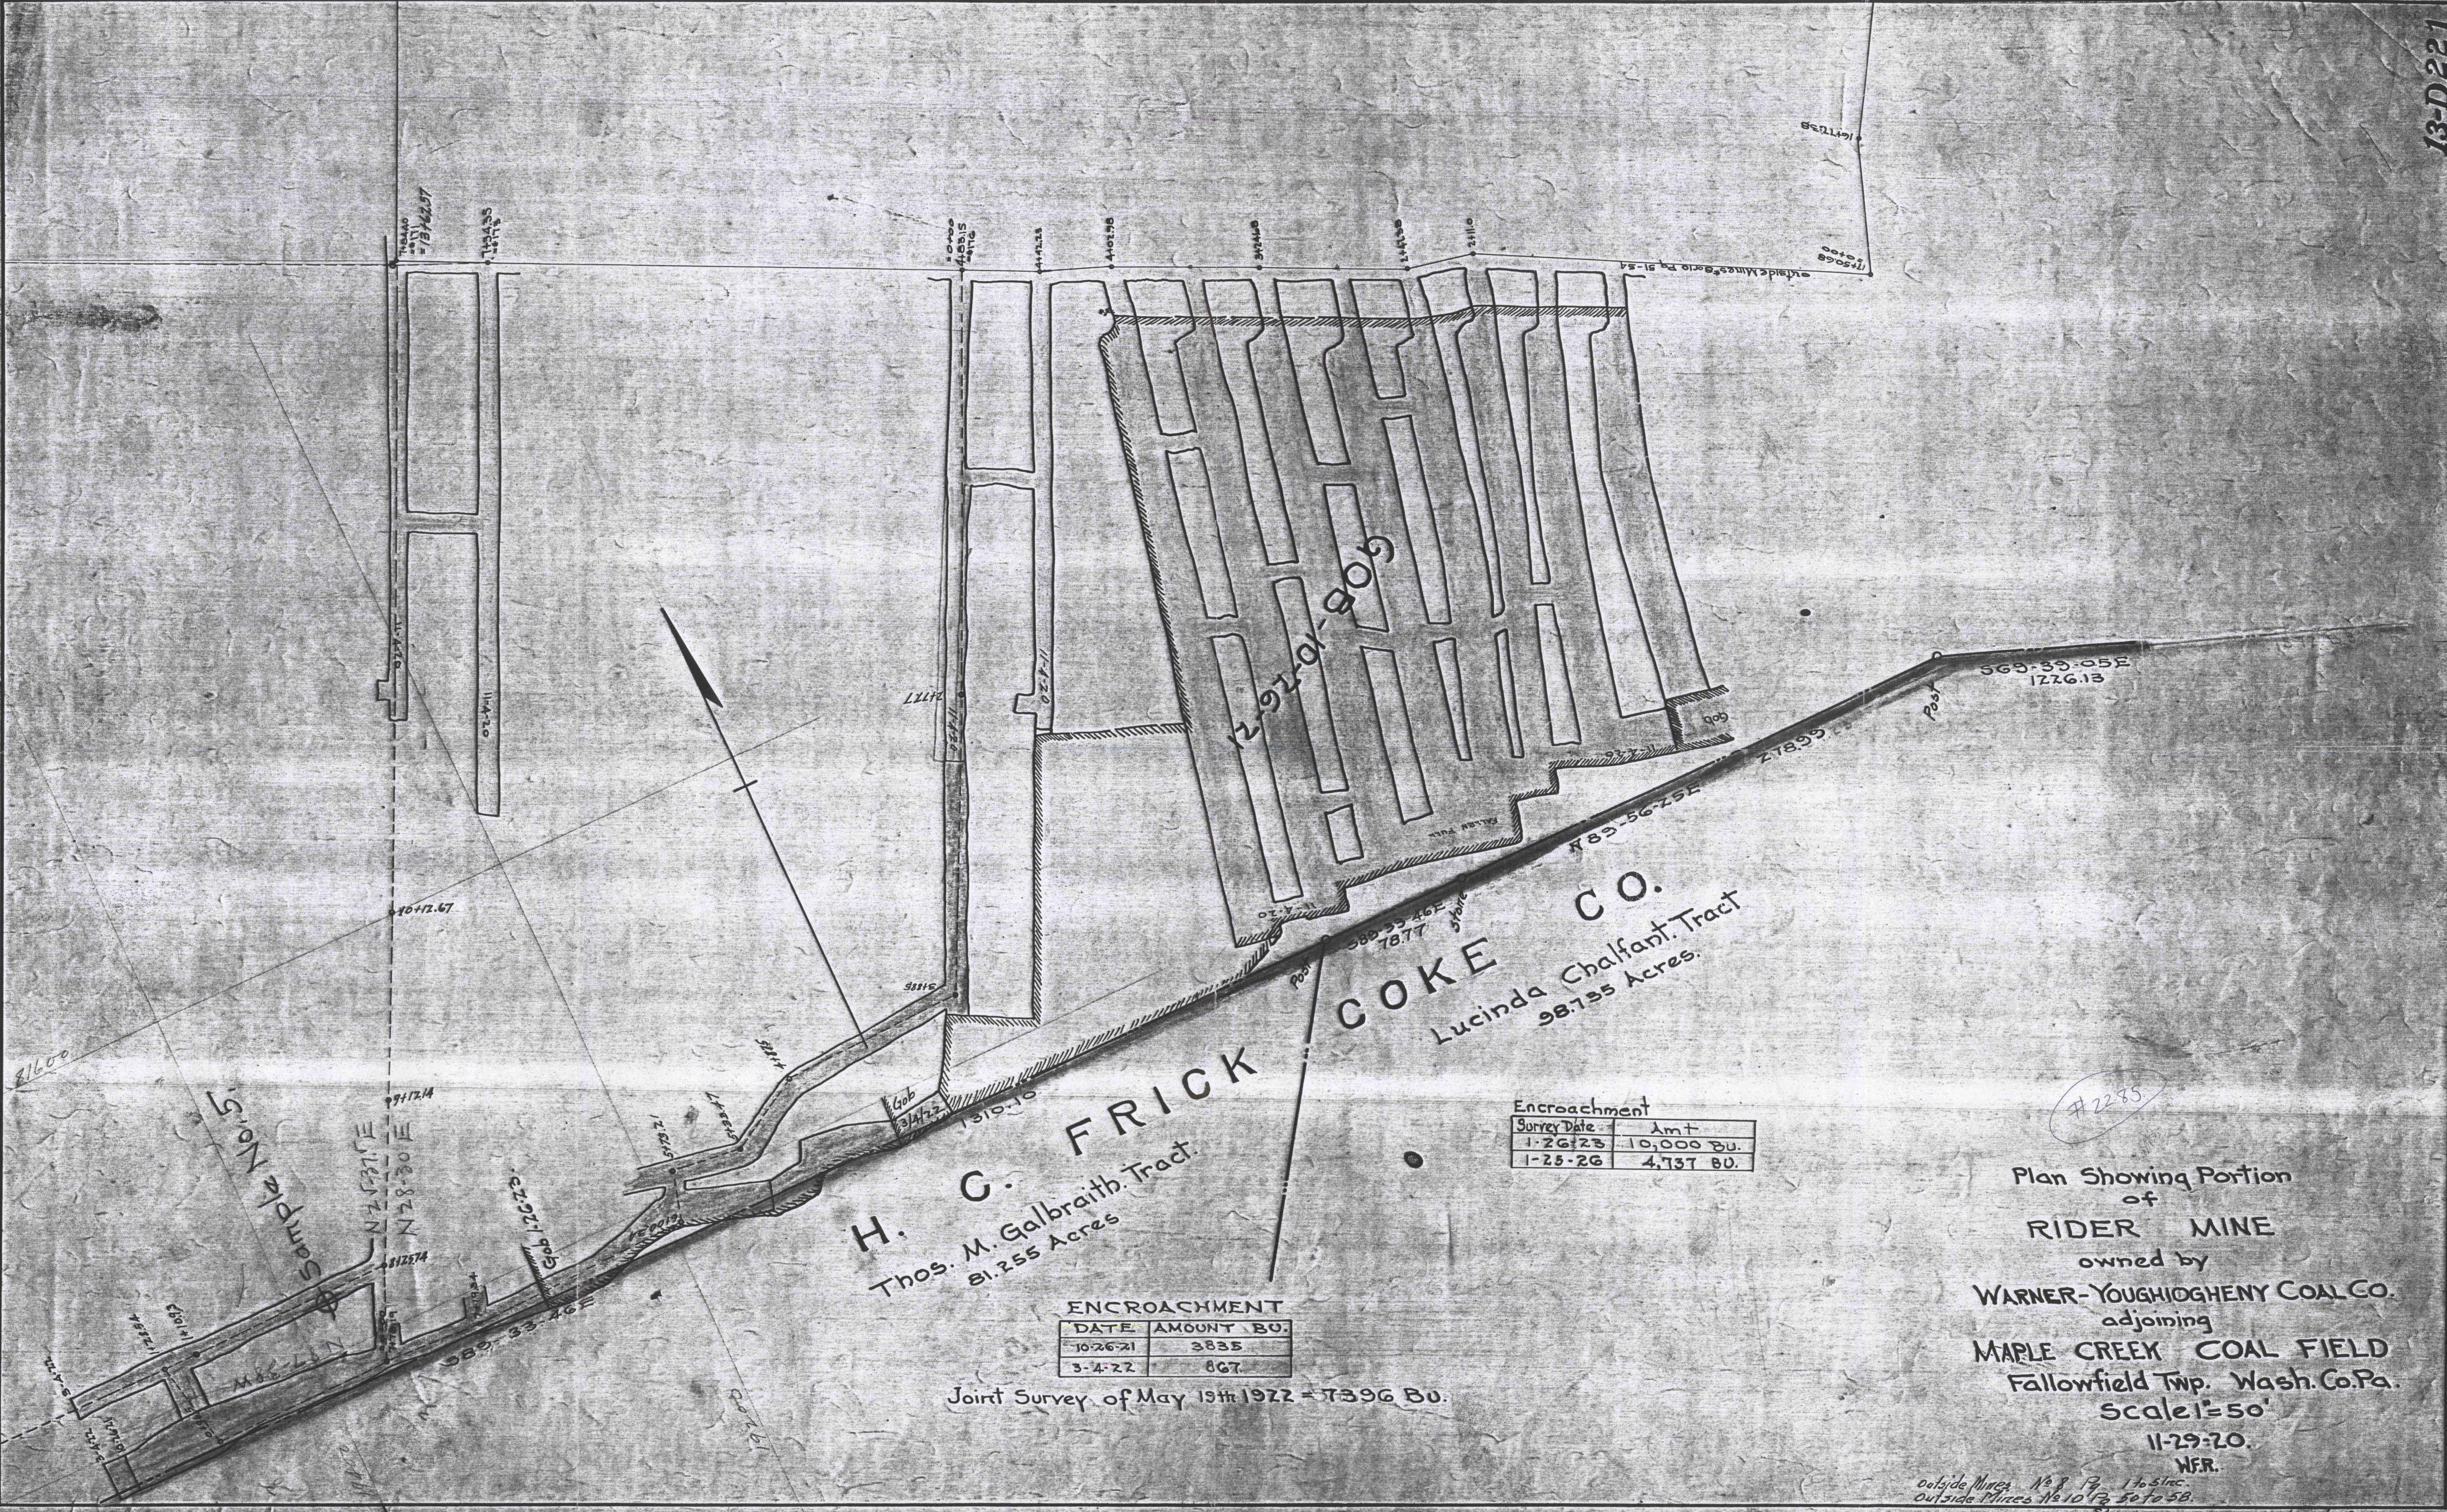

H. C. FRICK
 Thos. M. Galbraith Tract
 81.255 Acres

ENCROACHMENT

DATE	AMOUNT BU.
10-26-21	3835
3-4-22	867

Joint Survey of May 19th 1922 = 7396 Bu.

COKE CO.
 Lucinda Chalfant Tract
 98.185 Acres

ENCROACHMENT

Survey Date	Amt
1-26-23	10,000 Bu.
1-25-26	4,737 Bu.

#2285

Plan Showing Portion
 of
RIDER MINE
 owned by
WARNER-YOUGHIOGHENY COAL CO.
 adjoining
MAPLE CREEK COAL FIELD
 Fallowfield Twp. Wash. Co. Pa.
 Scale 1"=50'

11-29-20.
 W.F.R.

Outside Mines No. 8 P. 1 to 5 Inc.
 Outside Mines No. 10 P. 50 to 58.