


Chas. K. Shaffer
Mine Survey

May 15, 1935
and
October 1, 1935
Scale: 1" = 50'

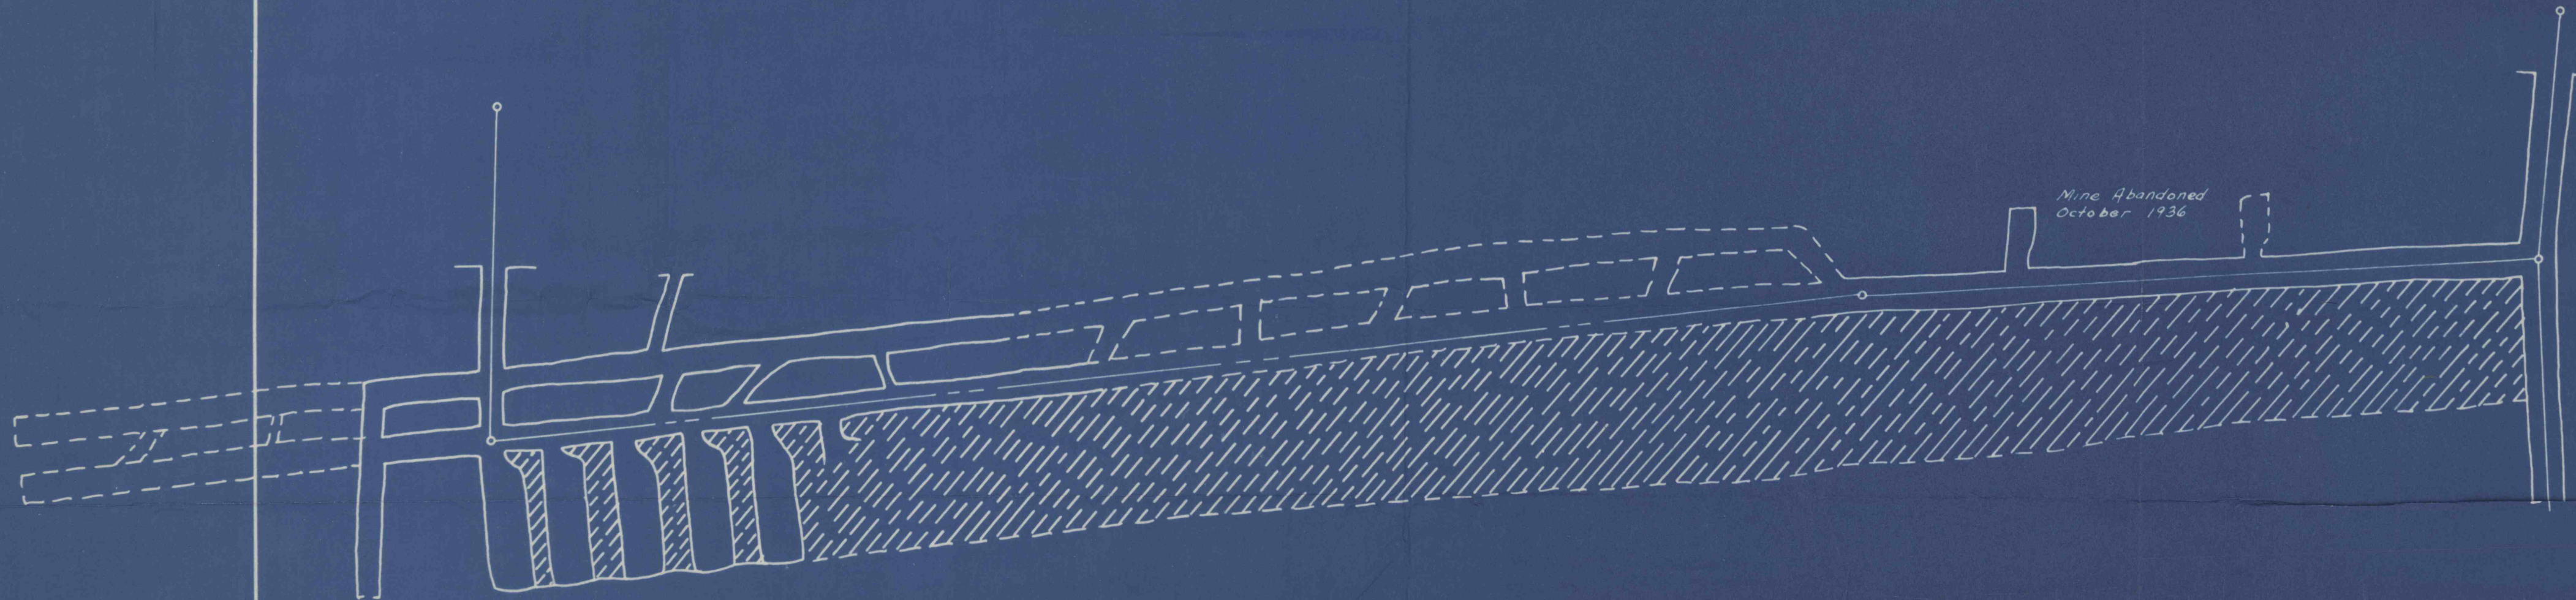

Mine Abandoned
October 1936

C. K. SHAFFER
No. 1 Mine

SHADE TWP SOMERSET CO
Scale: 1" = 50'

SHAFFER COAL CO.

Situate in Shade Township
Somerset County Pennsylvania

James M. Cable Surveyor
Berlin
Penna

Note: This is a copy of a blue print
made from the original tracing.
Survey in duplicate filed from
information from Operator Chas. K. Shaffer

Irwin Buckwalter

Asst. Div. Draftsman The B.V.C.M. Co.