


BORLAND COCHRAN

LANE

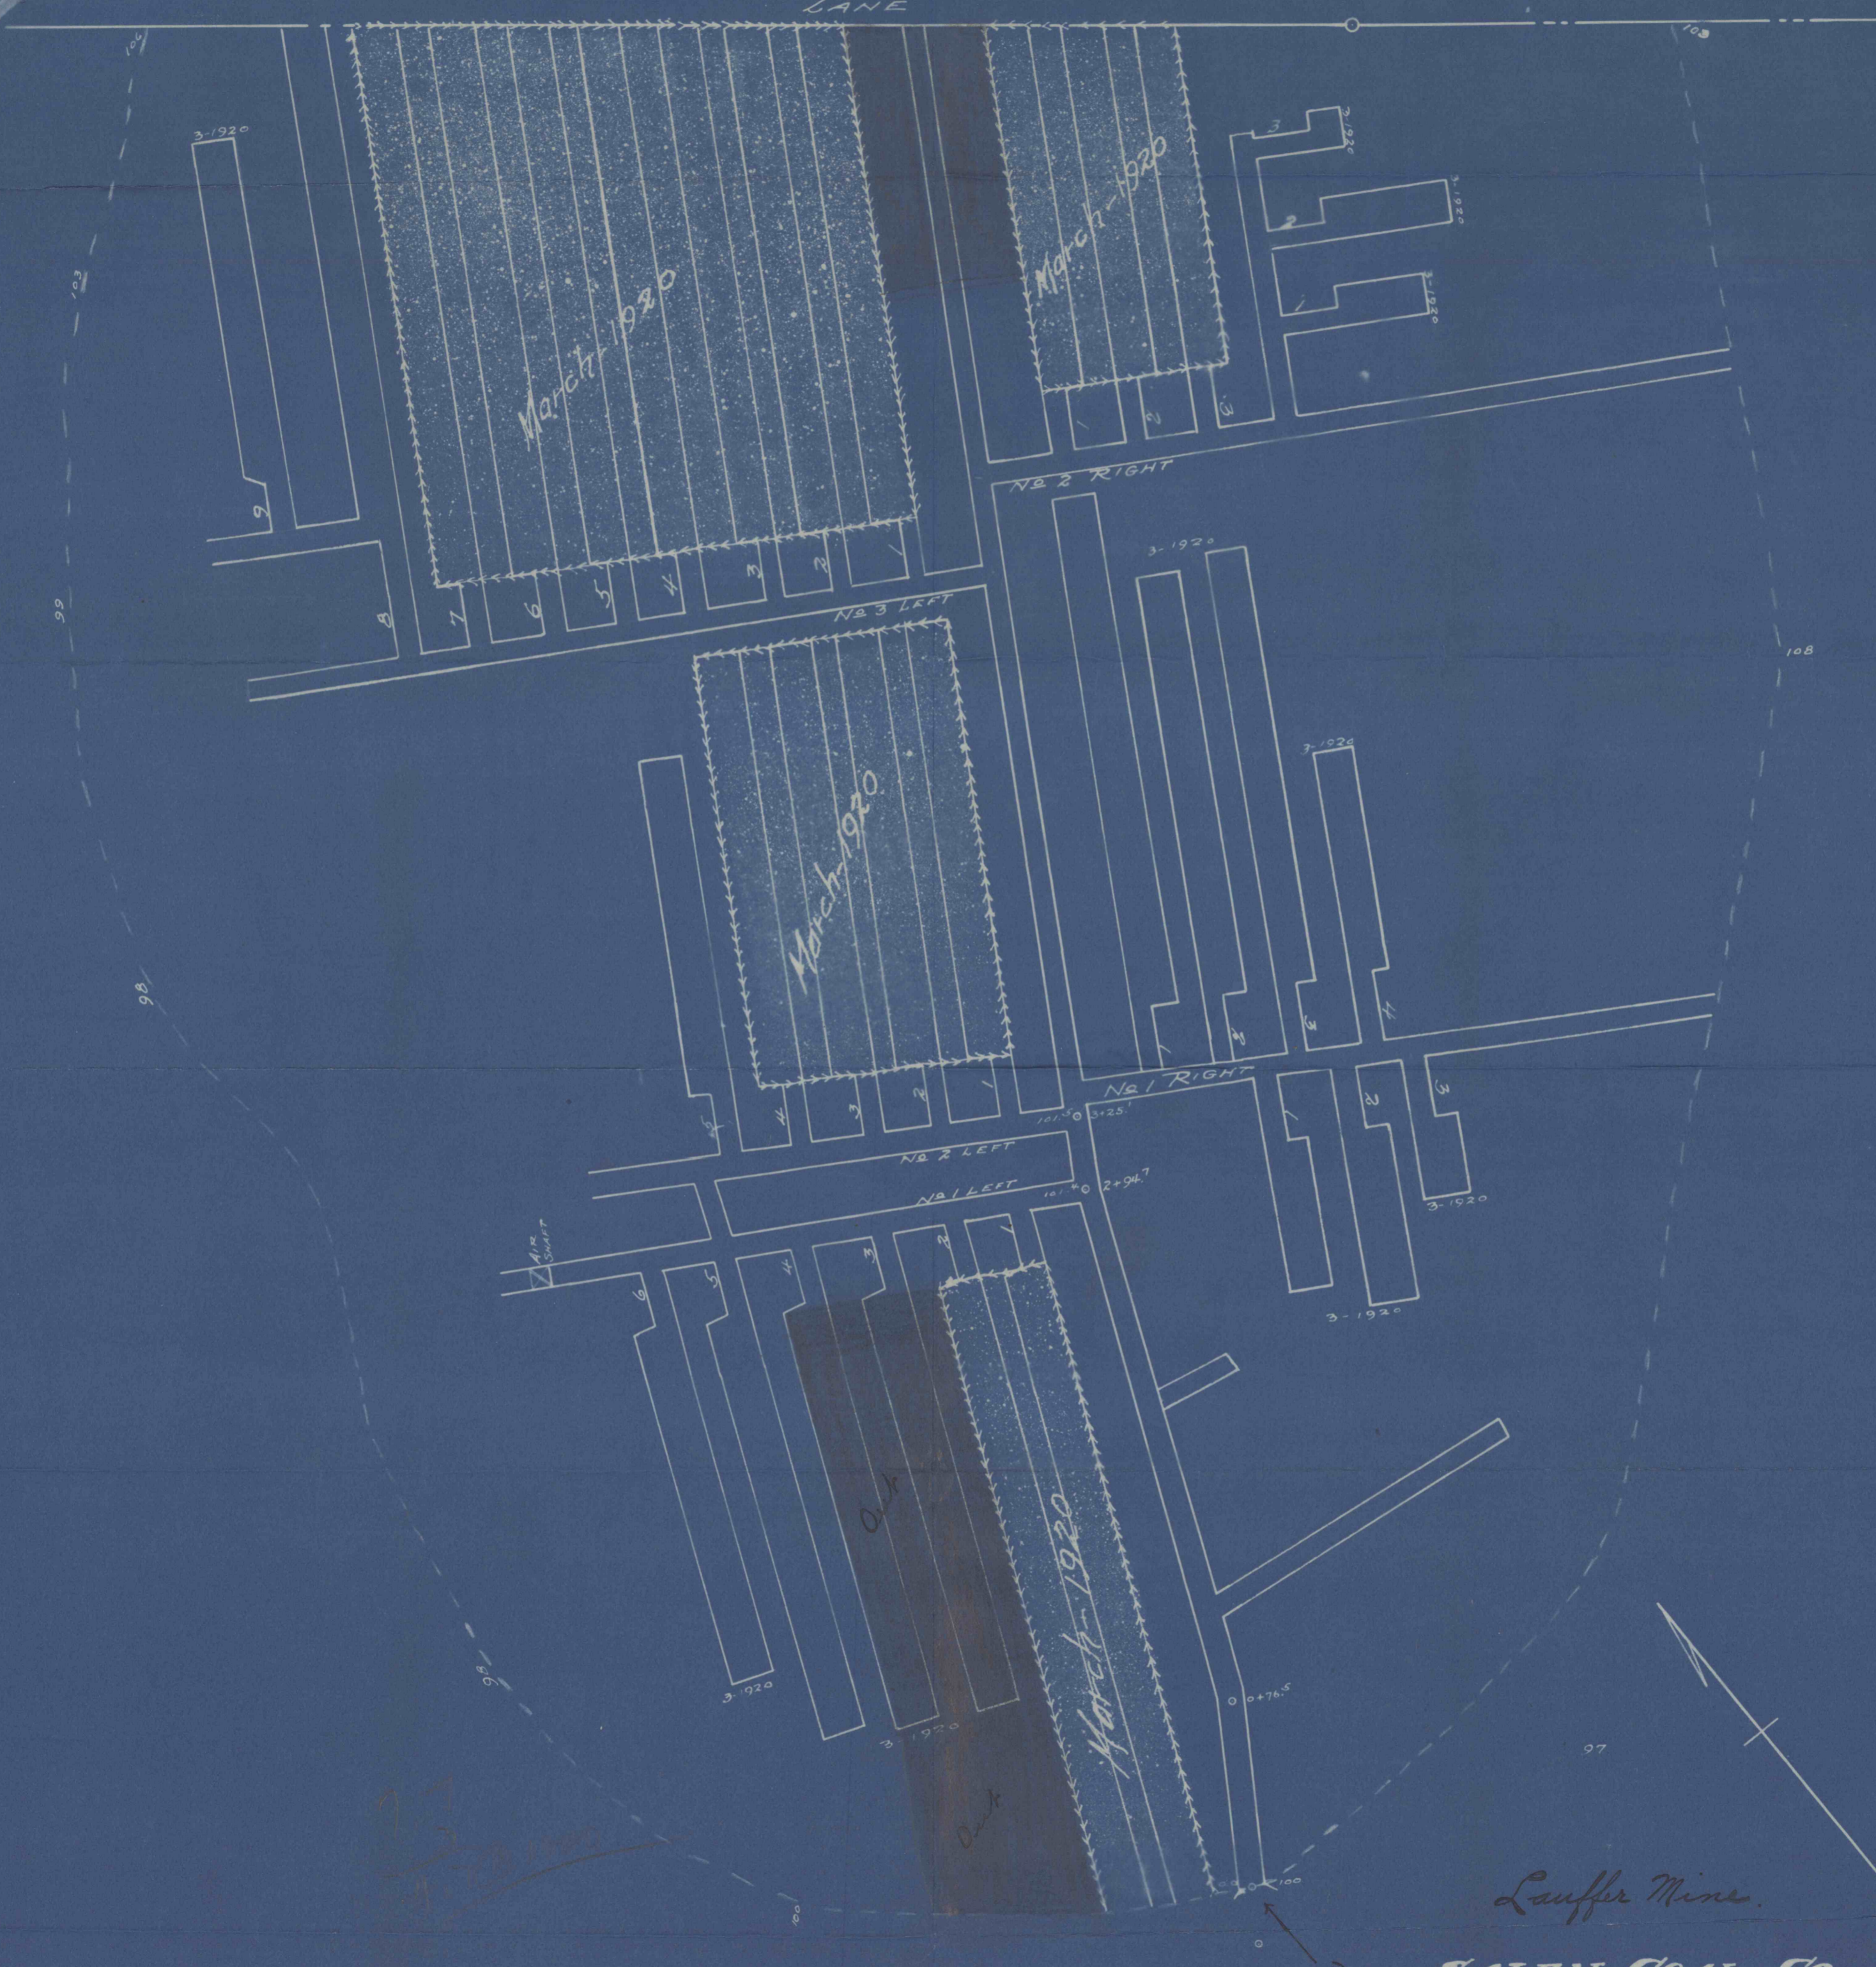

Laufer Mine.

SALEM COAL CO.
Salem Township
DELMONT, PA.

SCALE 1" = 50'

R. G. GILL, ENGR., GREENSBURG, PA.