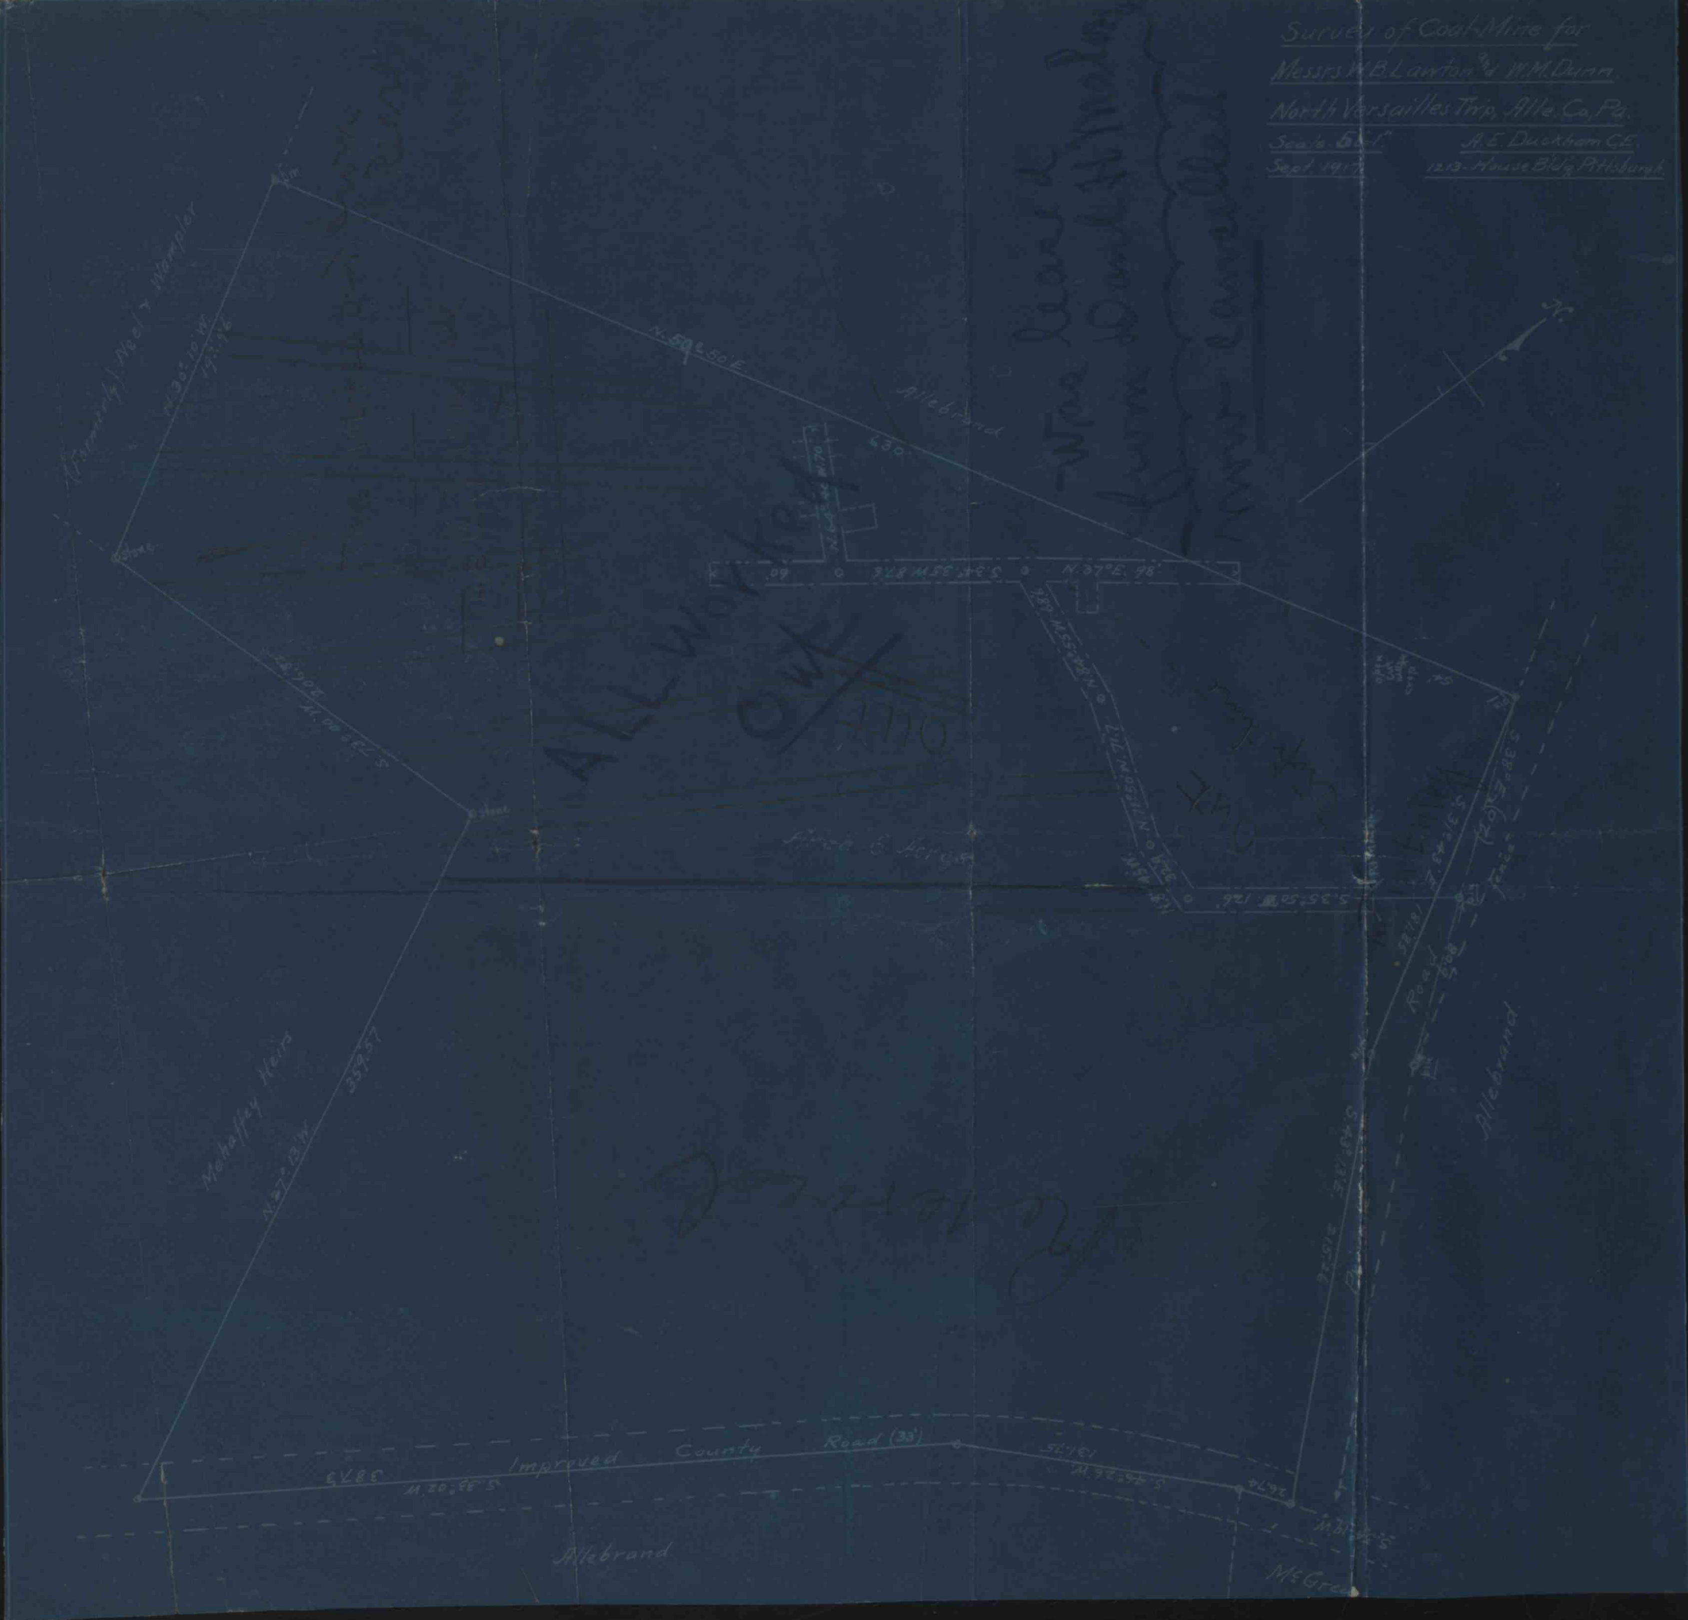

Survey of Coal Mine for
Messrs W.B. Lawton and W.M. Dunn
North Versailles Twp, Alle. Co. Pa.
A.E. Duckham C.E.
Sept. 1917
1213 - House Bldg Pittsburgh
N.50°50'E.
Allebrand
630
N.37°E. 98'
Neel & Wampler
Mehaffey Heirs
359.57
Improved County Road (33')
Allebrand
Road
Allebrand
ALL Worked Out