Morris-Connellsville Fuel Co.
Georges Twp.
Fayette County.

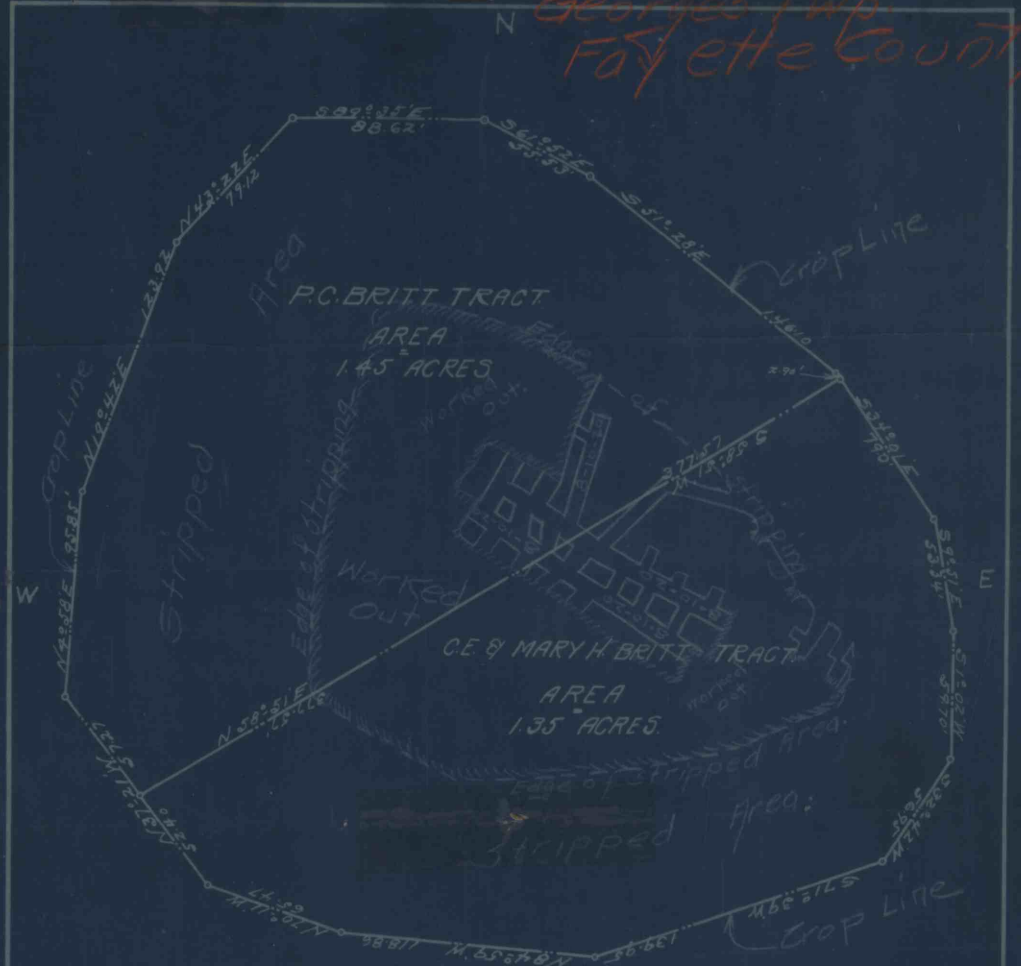

This Knob of Coal is located about 1¼ miles from Smithfield toward Fairchance on Morgantown Road and about 1300 ft S.E. of Road.

scale 1"=50'

6

1-5-40