


HEIRS OF J.H. ELKIN

N 83°39'30" W
1991.8'

FINAL MINE MAP
 SNYDER & COLEMAN COAL CO.
 PORTER TWP./JEFFERSON CO
 SEPT. 1957
 DEC. 1958
 REGIS E SMELKO
 SCALE 1" = 50'

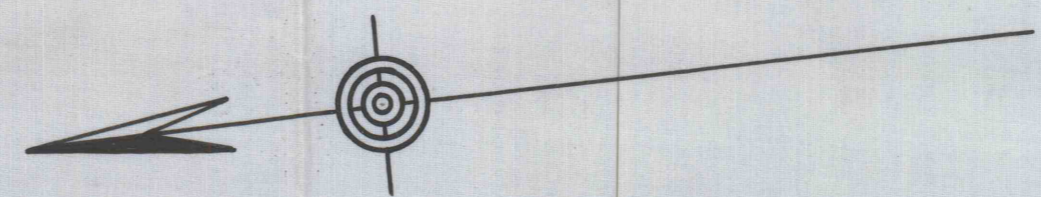

3/19/58

J.L.S.