


Map Of
 Russell H. Snyder Mine
 Porter Township Jefferson
 County Pa. Dist. 12
 Old Mines - 40 yrs.

Russell H. & Elzade P. Snyder
 Porter Twp. Jefferson Co.
 17 Acres
 Sect. 6 1955 Lewis E. Smetko
 Scale 1"=50'

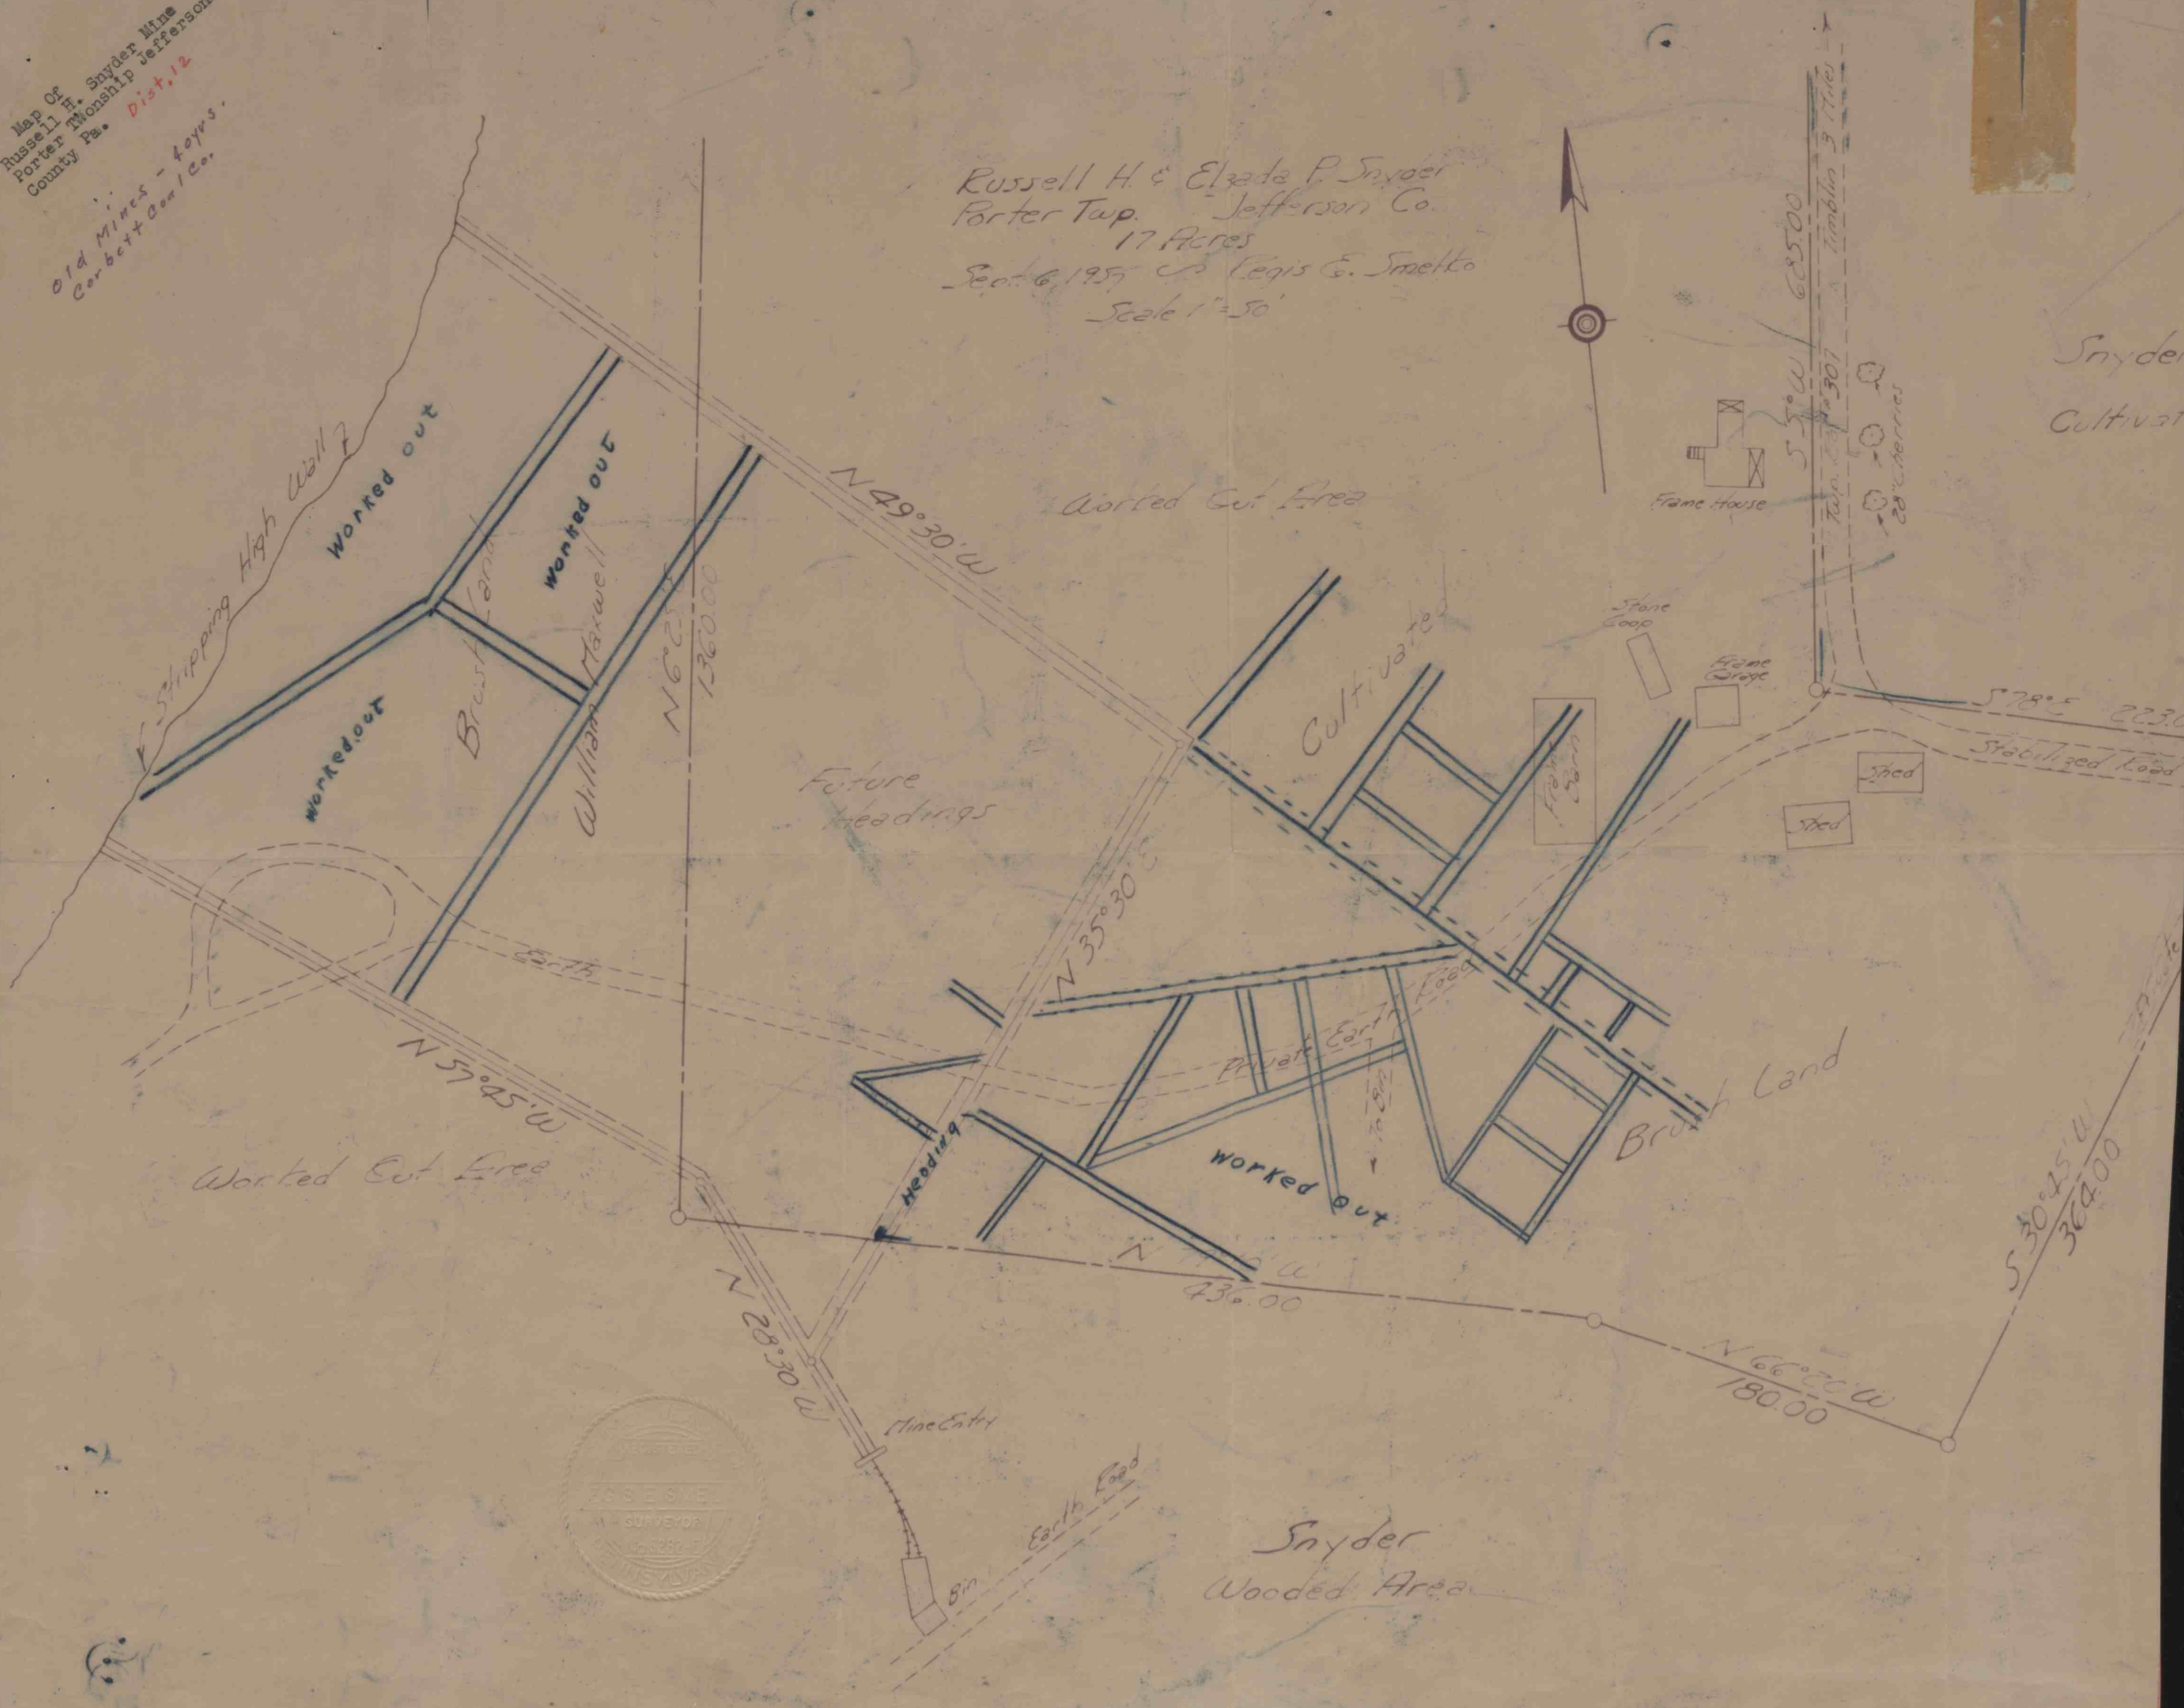

Snyder
 Cultivate

Snyder
 Wooded Area