


WORKED OUT.

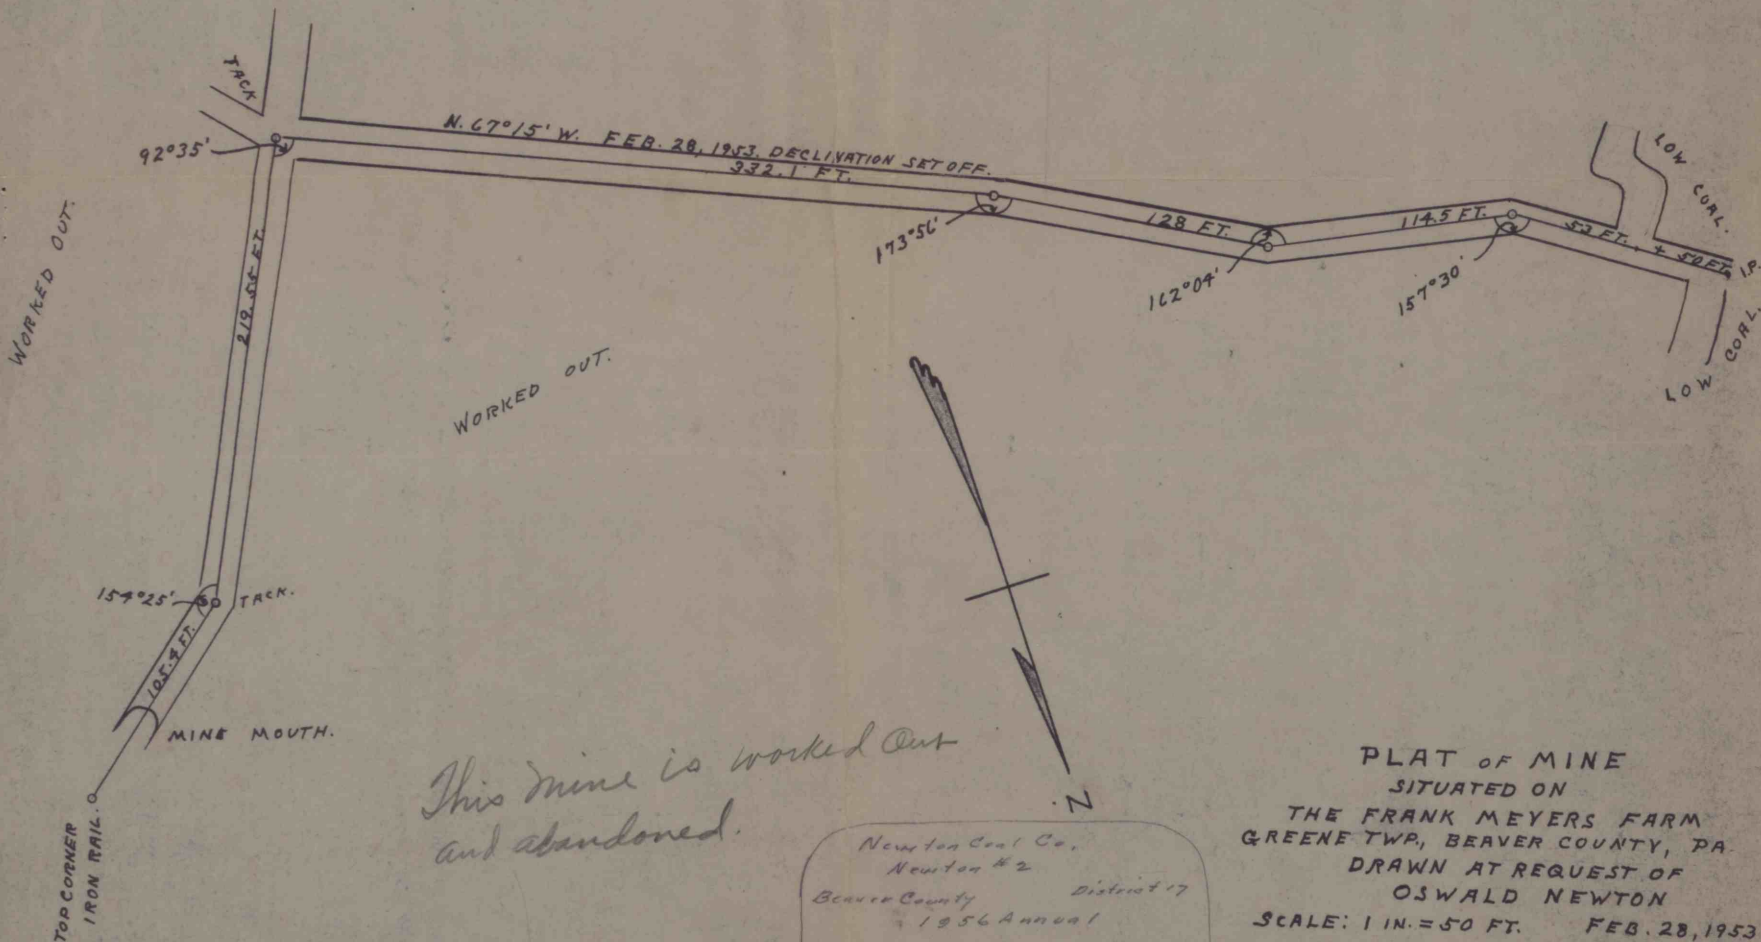

*This mine is worked out
and abandoned.*

Newton Coal Co.
 Newton #2
 Beaver County District 17
 1956 Annual

PENNSYLVANIA
 DEPARTMENT OF MINES
 AND MINERAL INDUSTRIES
 HARRISBURG, PENNA.
 OCT 29 1957

PLAT OF MINE
 SITUATED ON
 THE FRANK MEYERS FARM
 GREENE TWP, BEAVER COUNTY, PA.
 DRAWN AT REQUEST OF
 OSWALD NEWTON
 SCALE: 1 IN. = 50 FT. FEB. 28, 1953.
 W. CAIN