


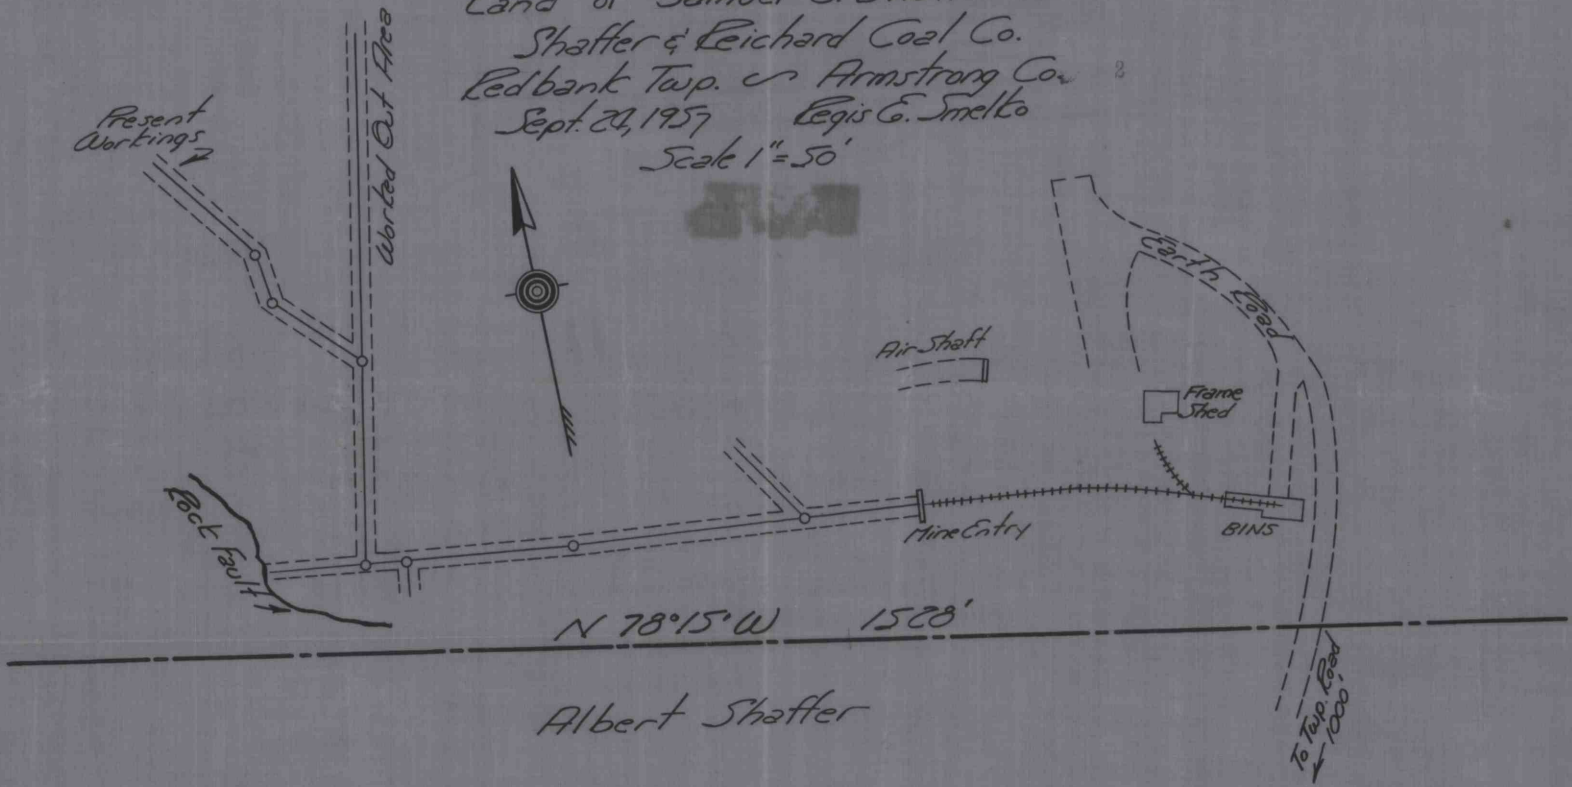

Land of Samuel C. Shaffer Heirs
 Shaffer & Reichard Coal Co.
 Redbank Twp. in Armstrong Co. Pa.
 Sept. 24, 1957 Legis. E. Smelto
 Scale 1" = 50'



DEP
 #
 32114