


00 004
DETWILER Solid Coal No OPERATING MINES
3 00 52N

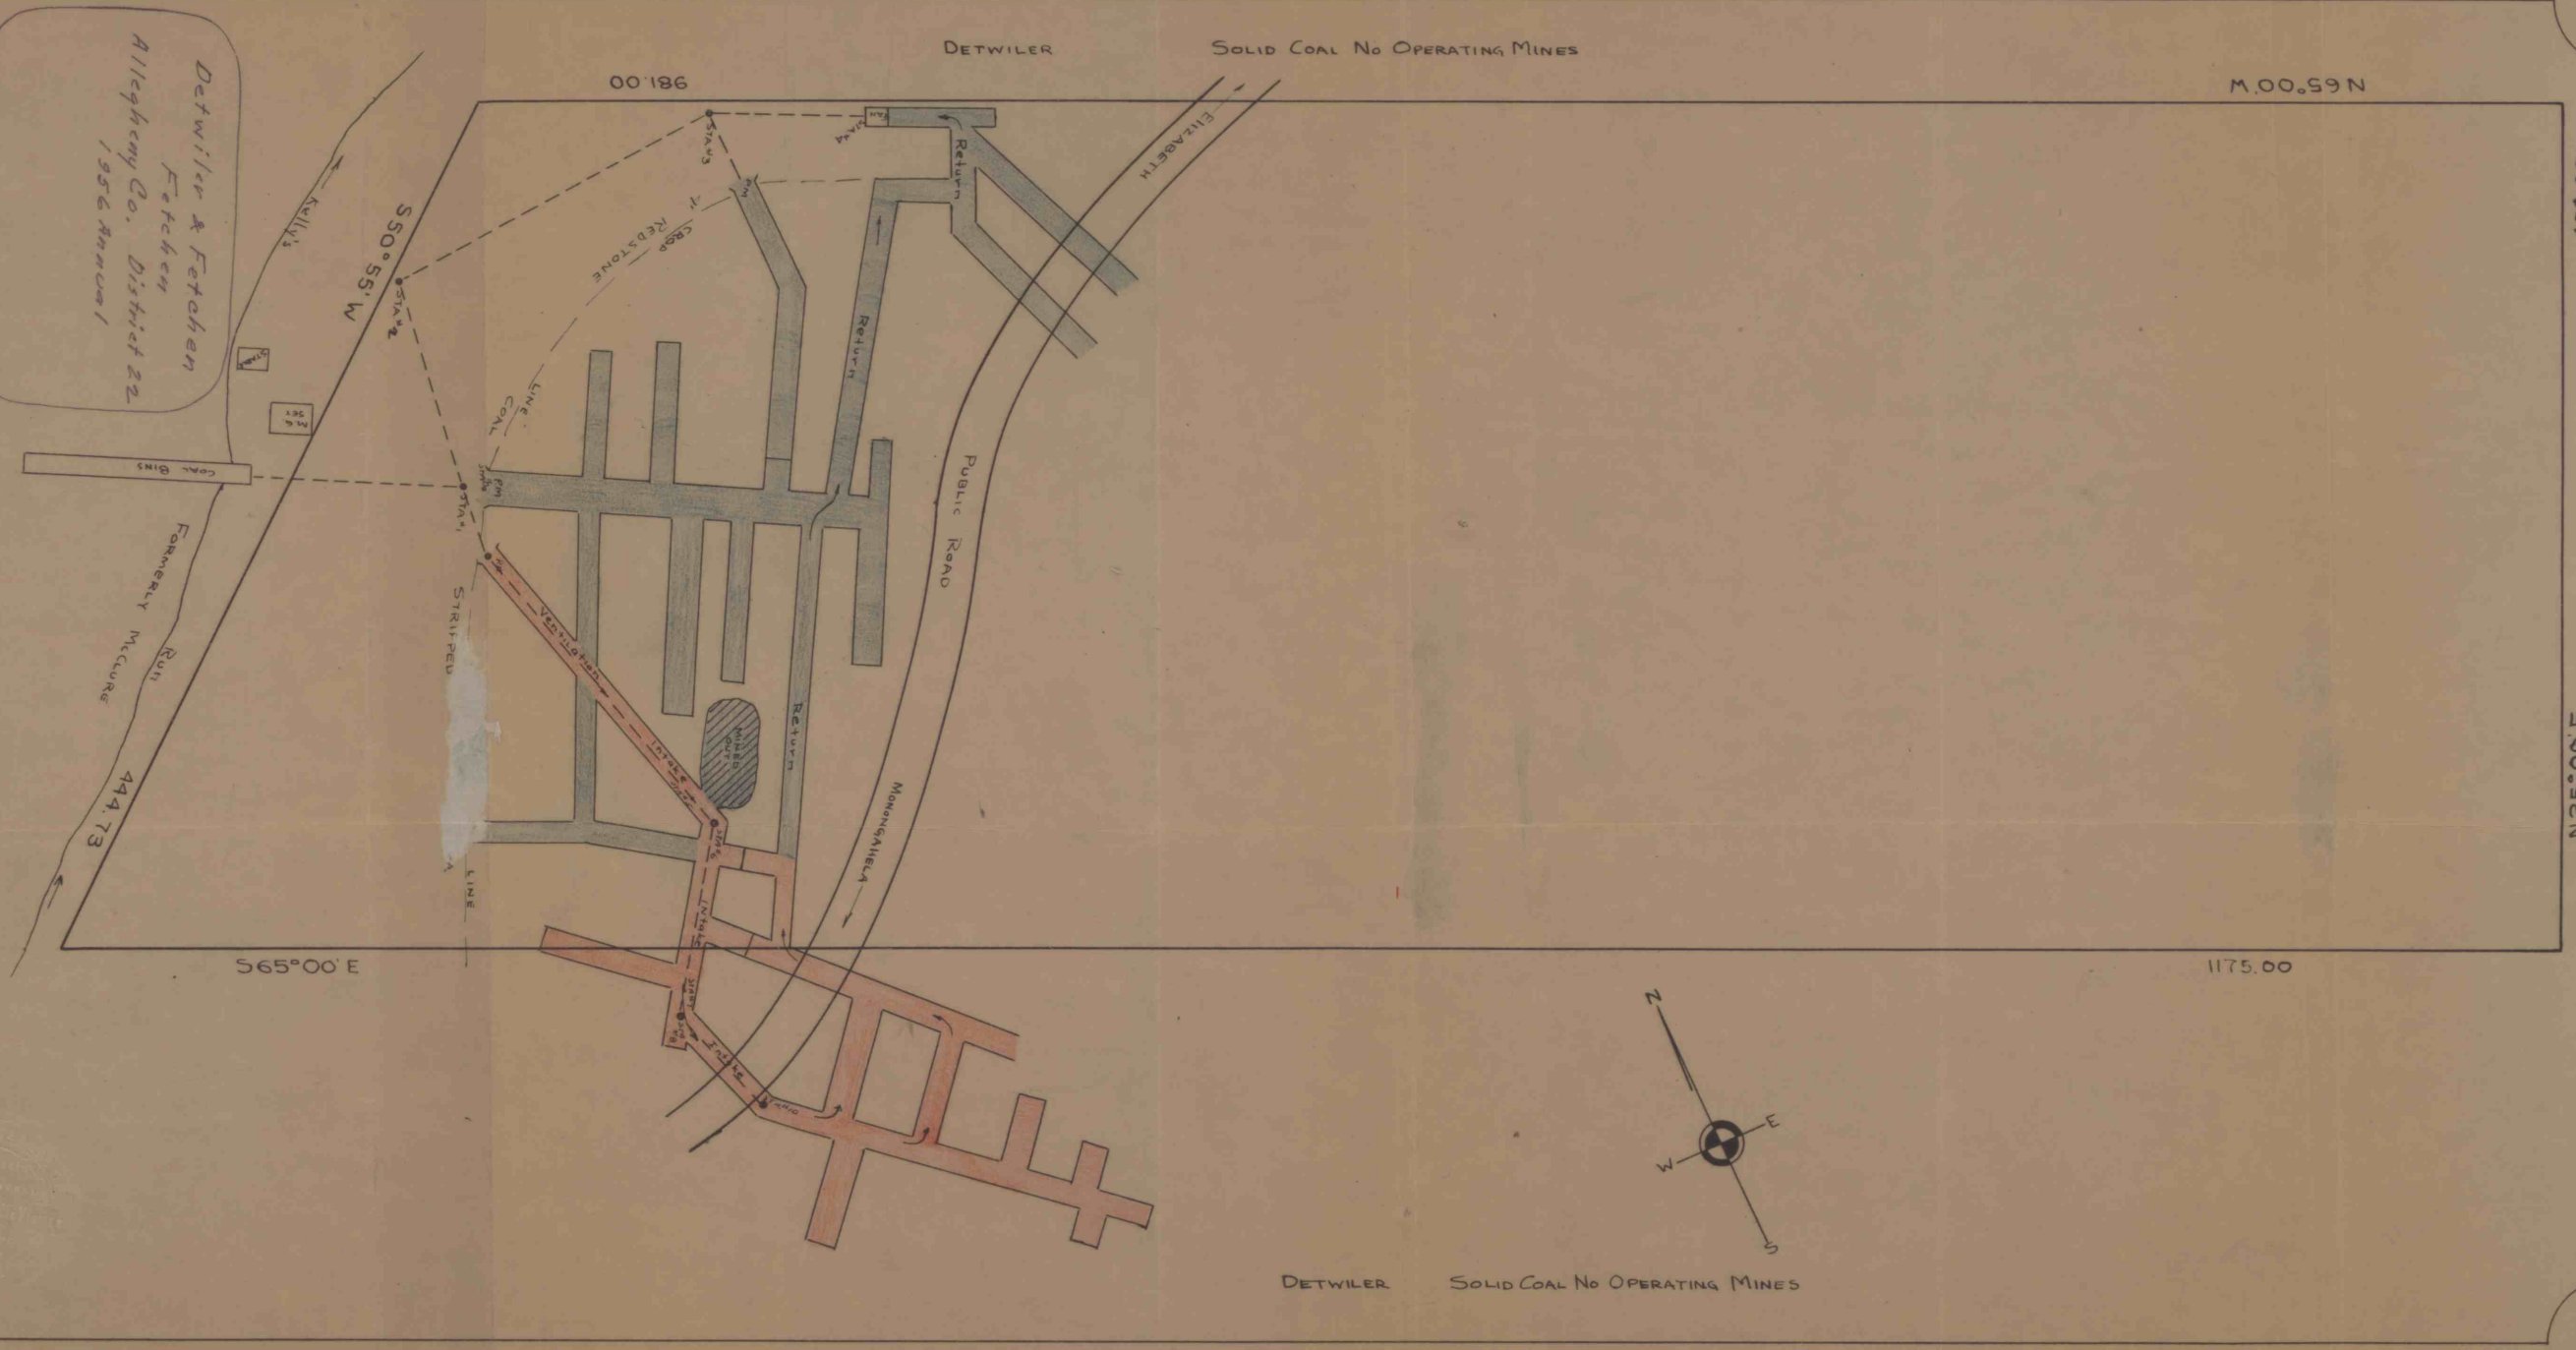

*Detwiler & Fetchen
Fetchen
Allegheny Co. District 22
1956 Annual*

PLAN SHOWING FETCHEN MINE
WORKINGS, COAL BINS, ETC.
OWNED BY

PETE FETCHEN
BUNOLA ALLEGHENY CO, PENNA. 1. 22
SCALE 1"=50' OCT. 1, 1957
ALEX L. McVICKER, REG. PROF. ENGR. 8225
R. HANNA, DEL.

Blue Old Workings Not Active
Red New Workings Active



DETWILER Solid Coal No OPERATING MINES