


Map Showing
Deep Mine workings
of
SMEAL & BOCK

West Decatur, Pa.
May 5, 1932
and Jan. 1935
and C. 1931

Boggs TWP
Clearfield Co.
Dist. 8

Scale

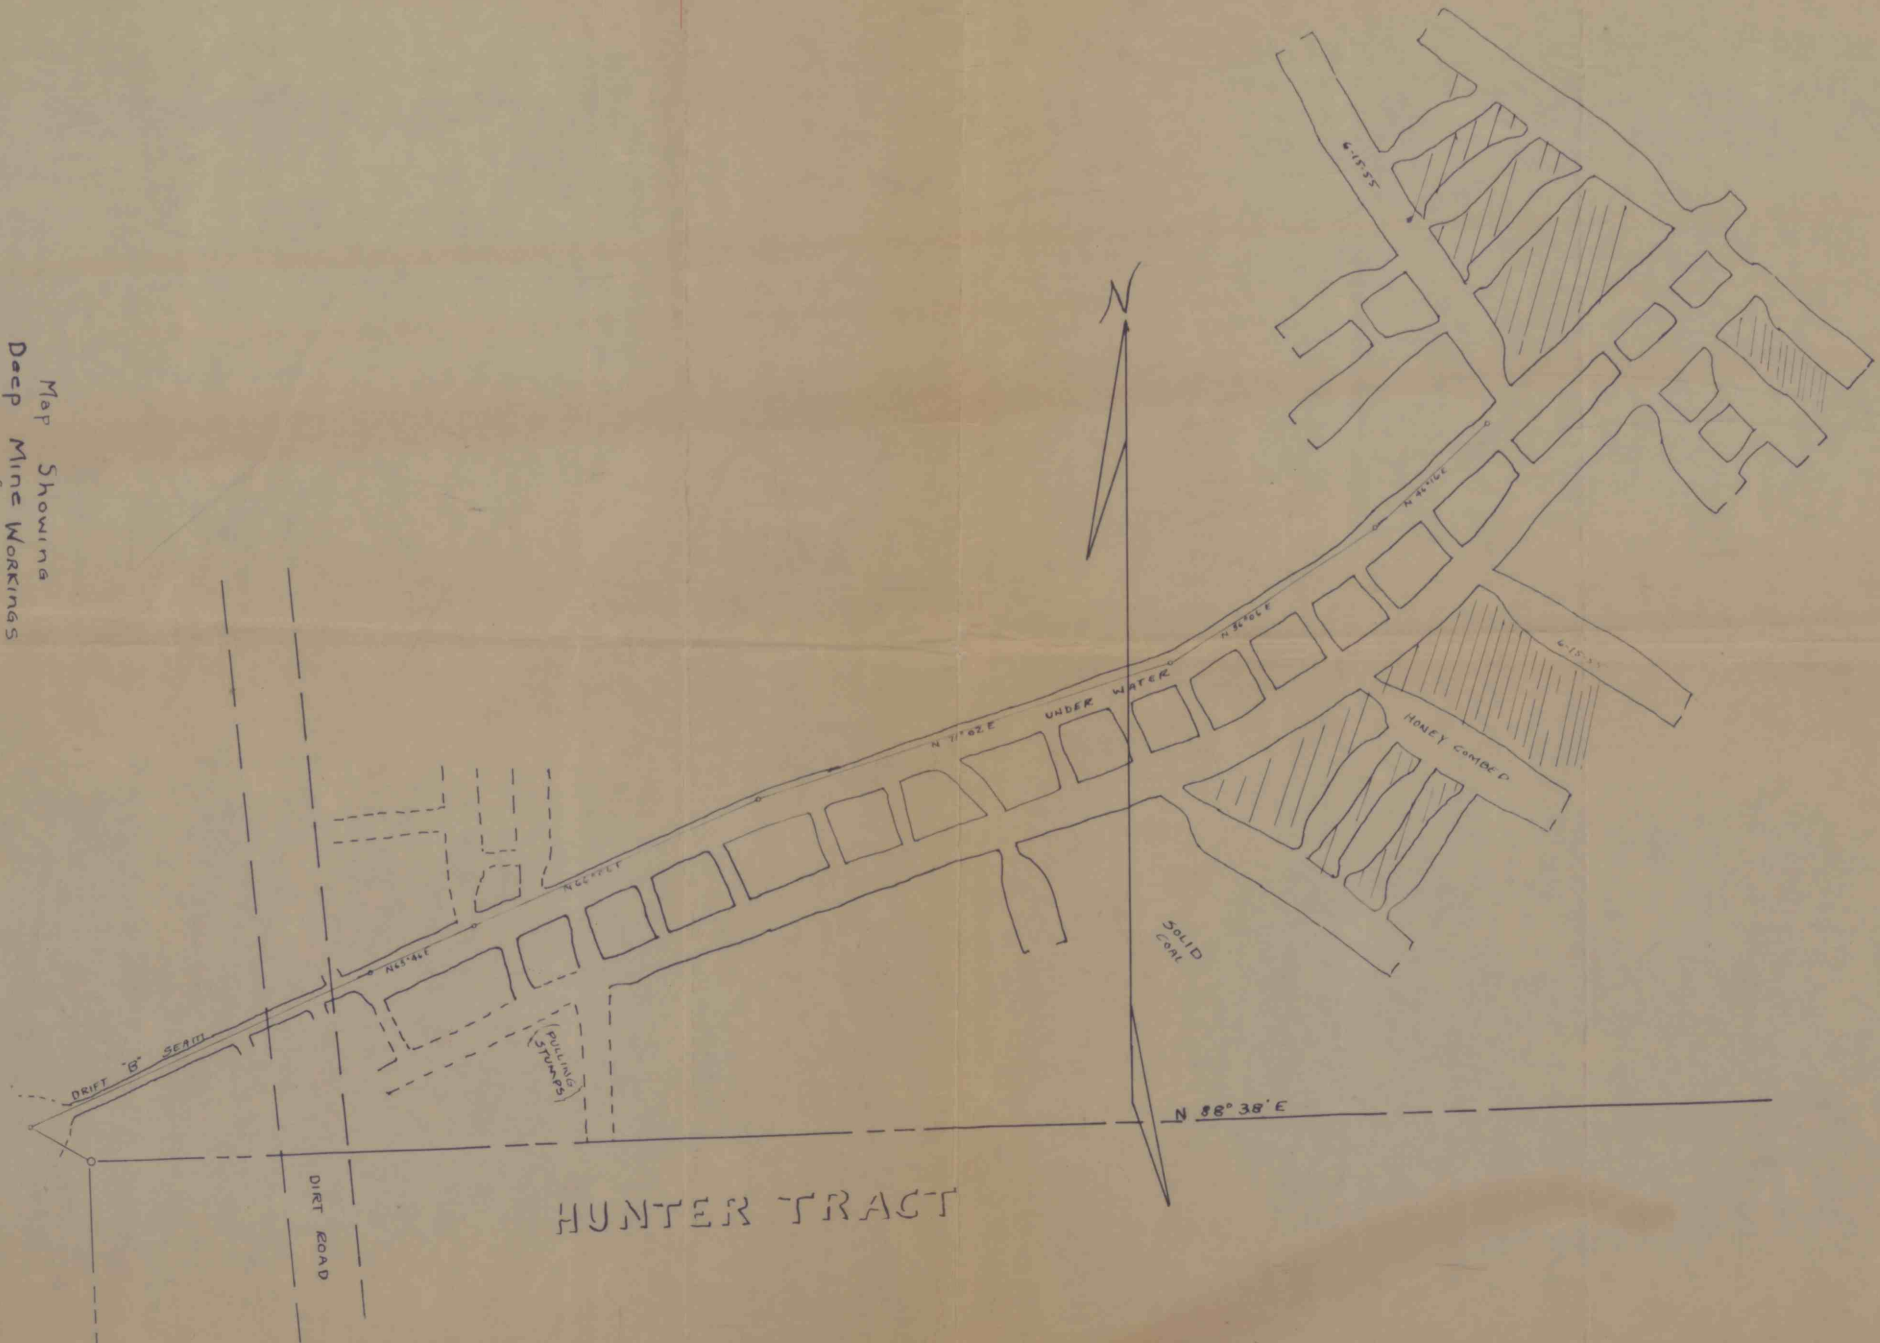

HUNTER TRACT