


CEMETERY

LUTHERAN AND PRESBYTERIAN CONGREGATION

(FORMERLY)
GEN. W. HAWKEY

(FORMERLY)
H. LAINE ESTATE

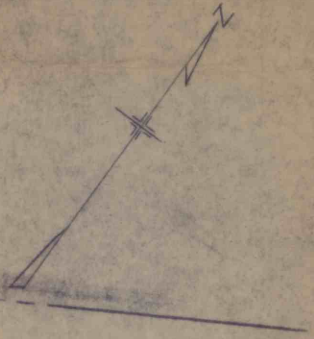

S 30° 44' 30" E

478.50'

5-13-66

5-18-66

S 58° W

5-18-66

COAL STRIPPED

TIPPLE

GERALD F. RAUGHT FARM

MAP SHOWING
RAUGHT MINE
SITUATED IN

FRANKLIN TWP WESTMONTGOMERY CO, PA.
SCALE 1" = 50'
DEC. 30/1963
MAYNARD & SONS, Scranton, Pa. S. No. 483 B

DWG No H-57