


LION MINING CO.  
GROVE NO. 1 MINE  
MINE SEAL LOCATION MAP  
SCALE: 1" = 50'  
CONTOUR INTERVAL: 5 FEET

SEAL LOCATION



1960 UPPER KITTANNING  
COAL CONTOUR

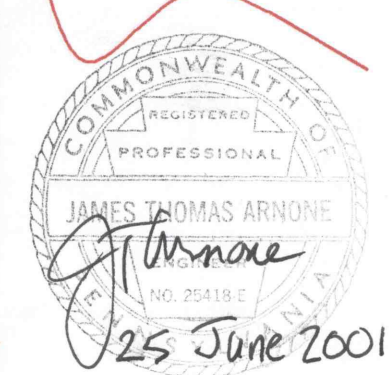