



LEGEND

LANCASHIRE NO. 24B SEAM
A-26" HDG. & ROOMS
POSTS NOT DRAWN TO SCALE
SCALE: 1"=50'
WORKINGS AS OF 4-16-1969

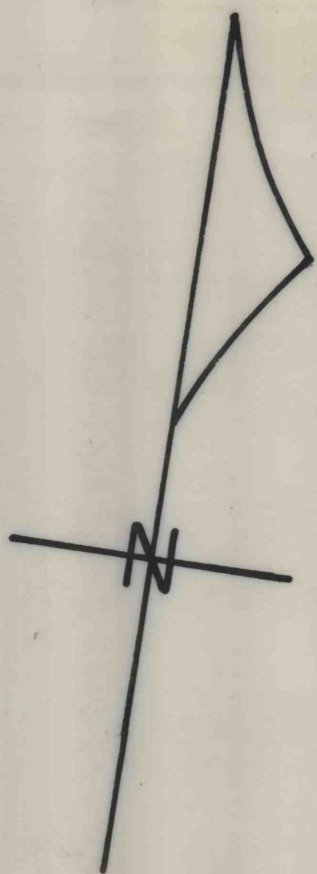

"A-24" R-2 RIB LINE

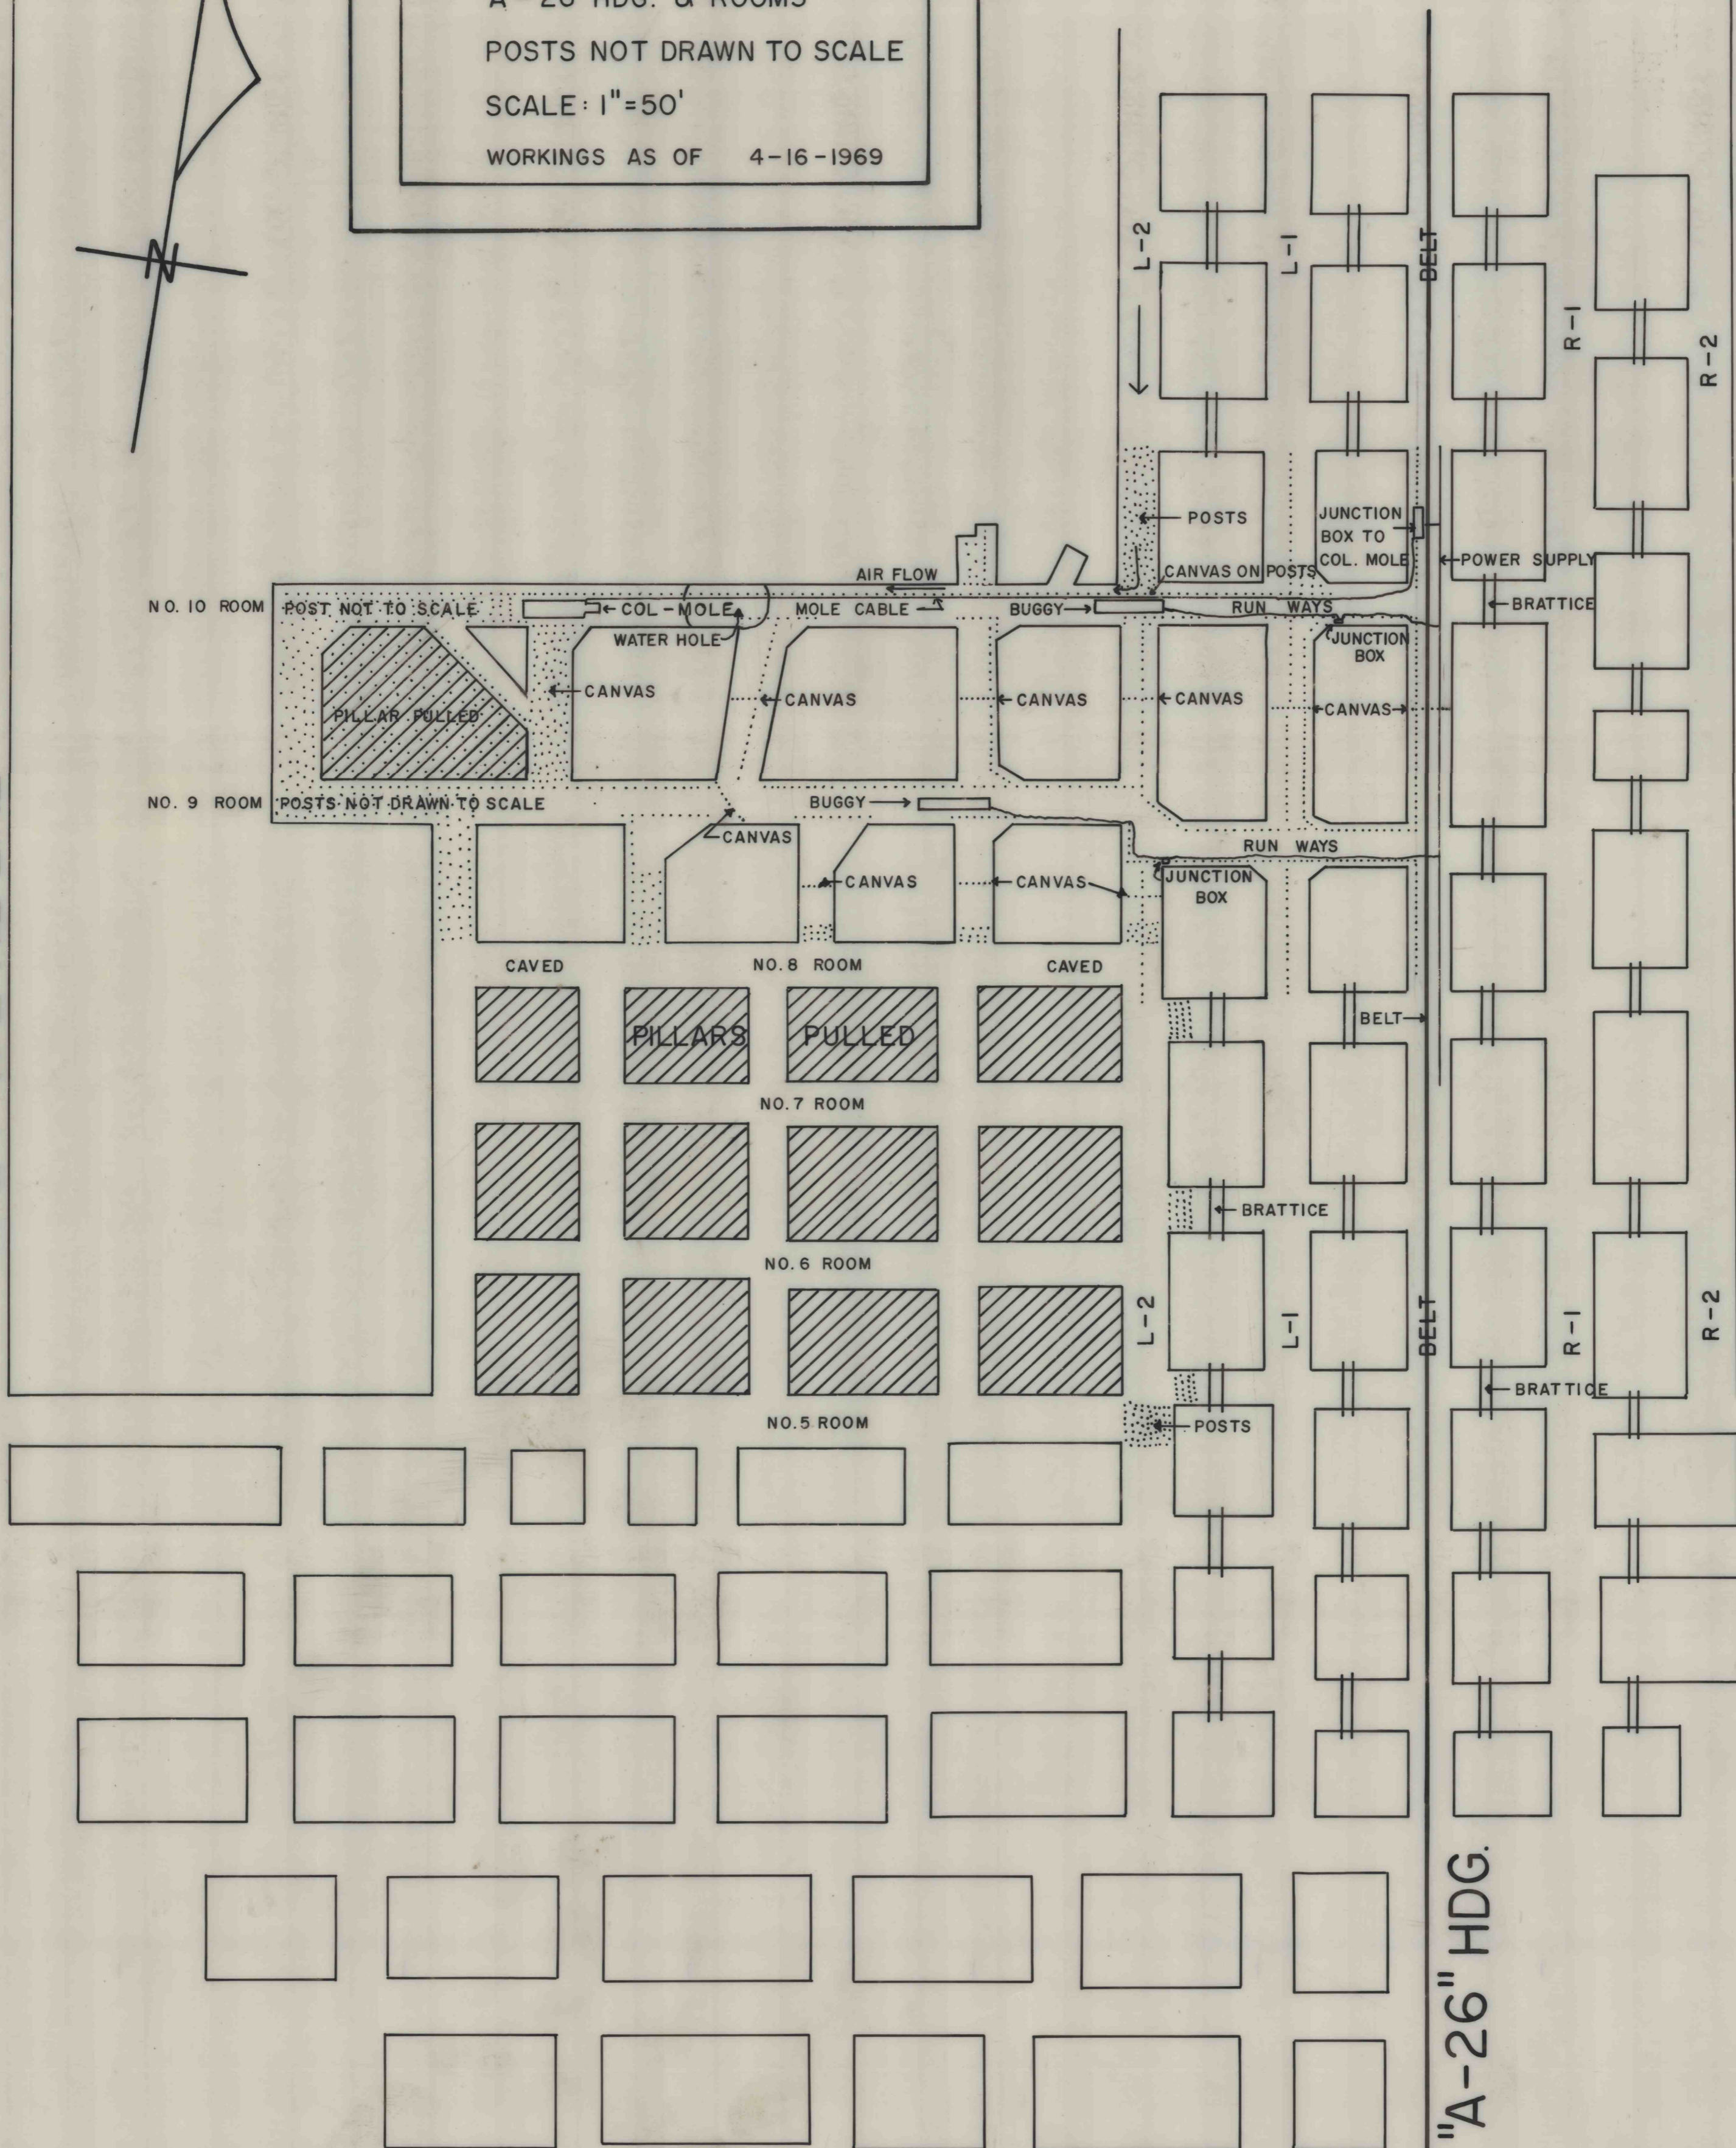

"A-26" HDG.