


4158

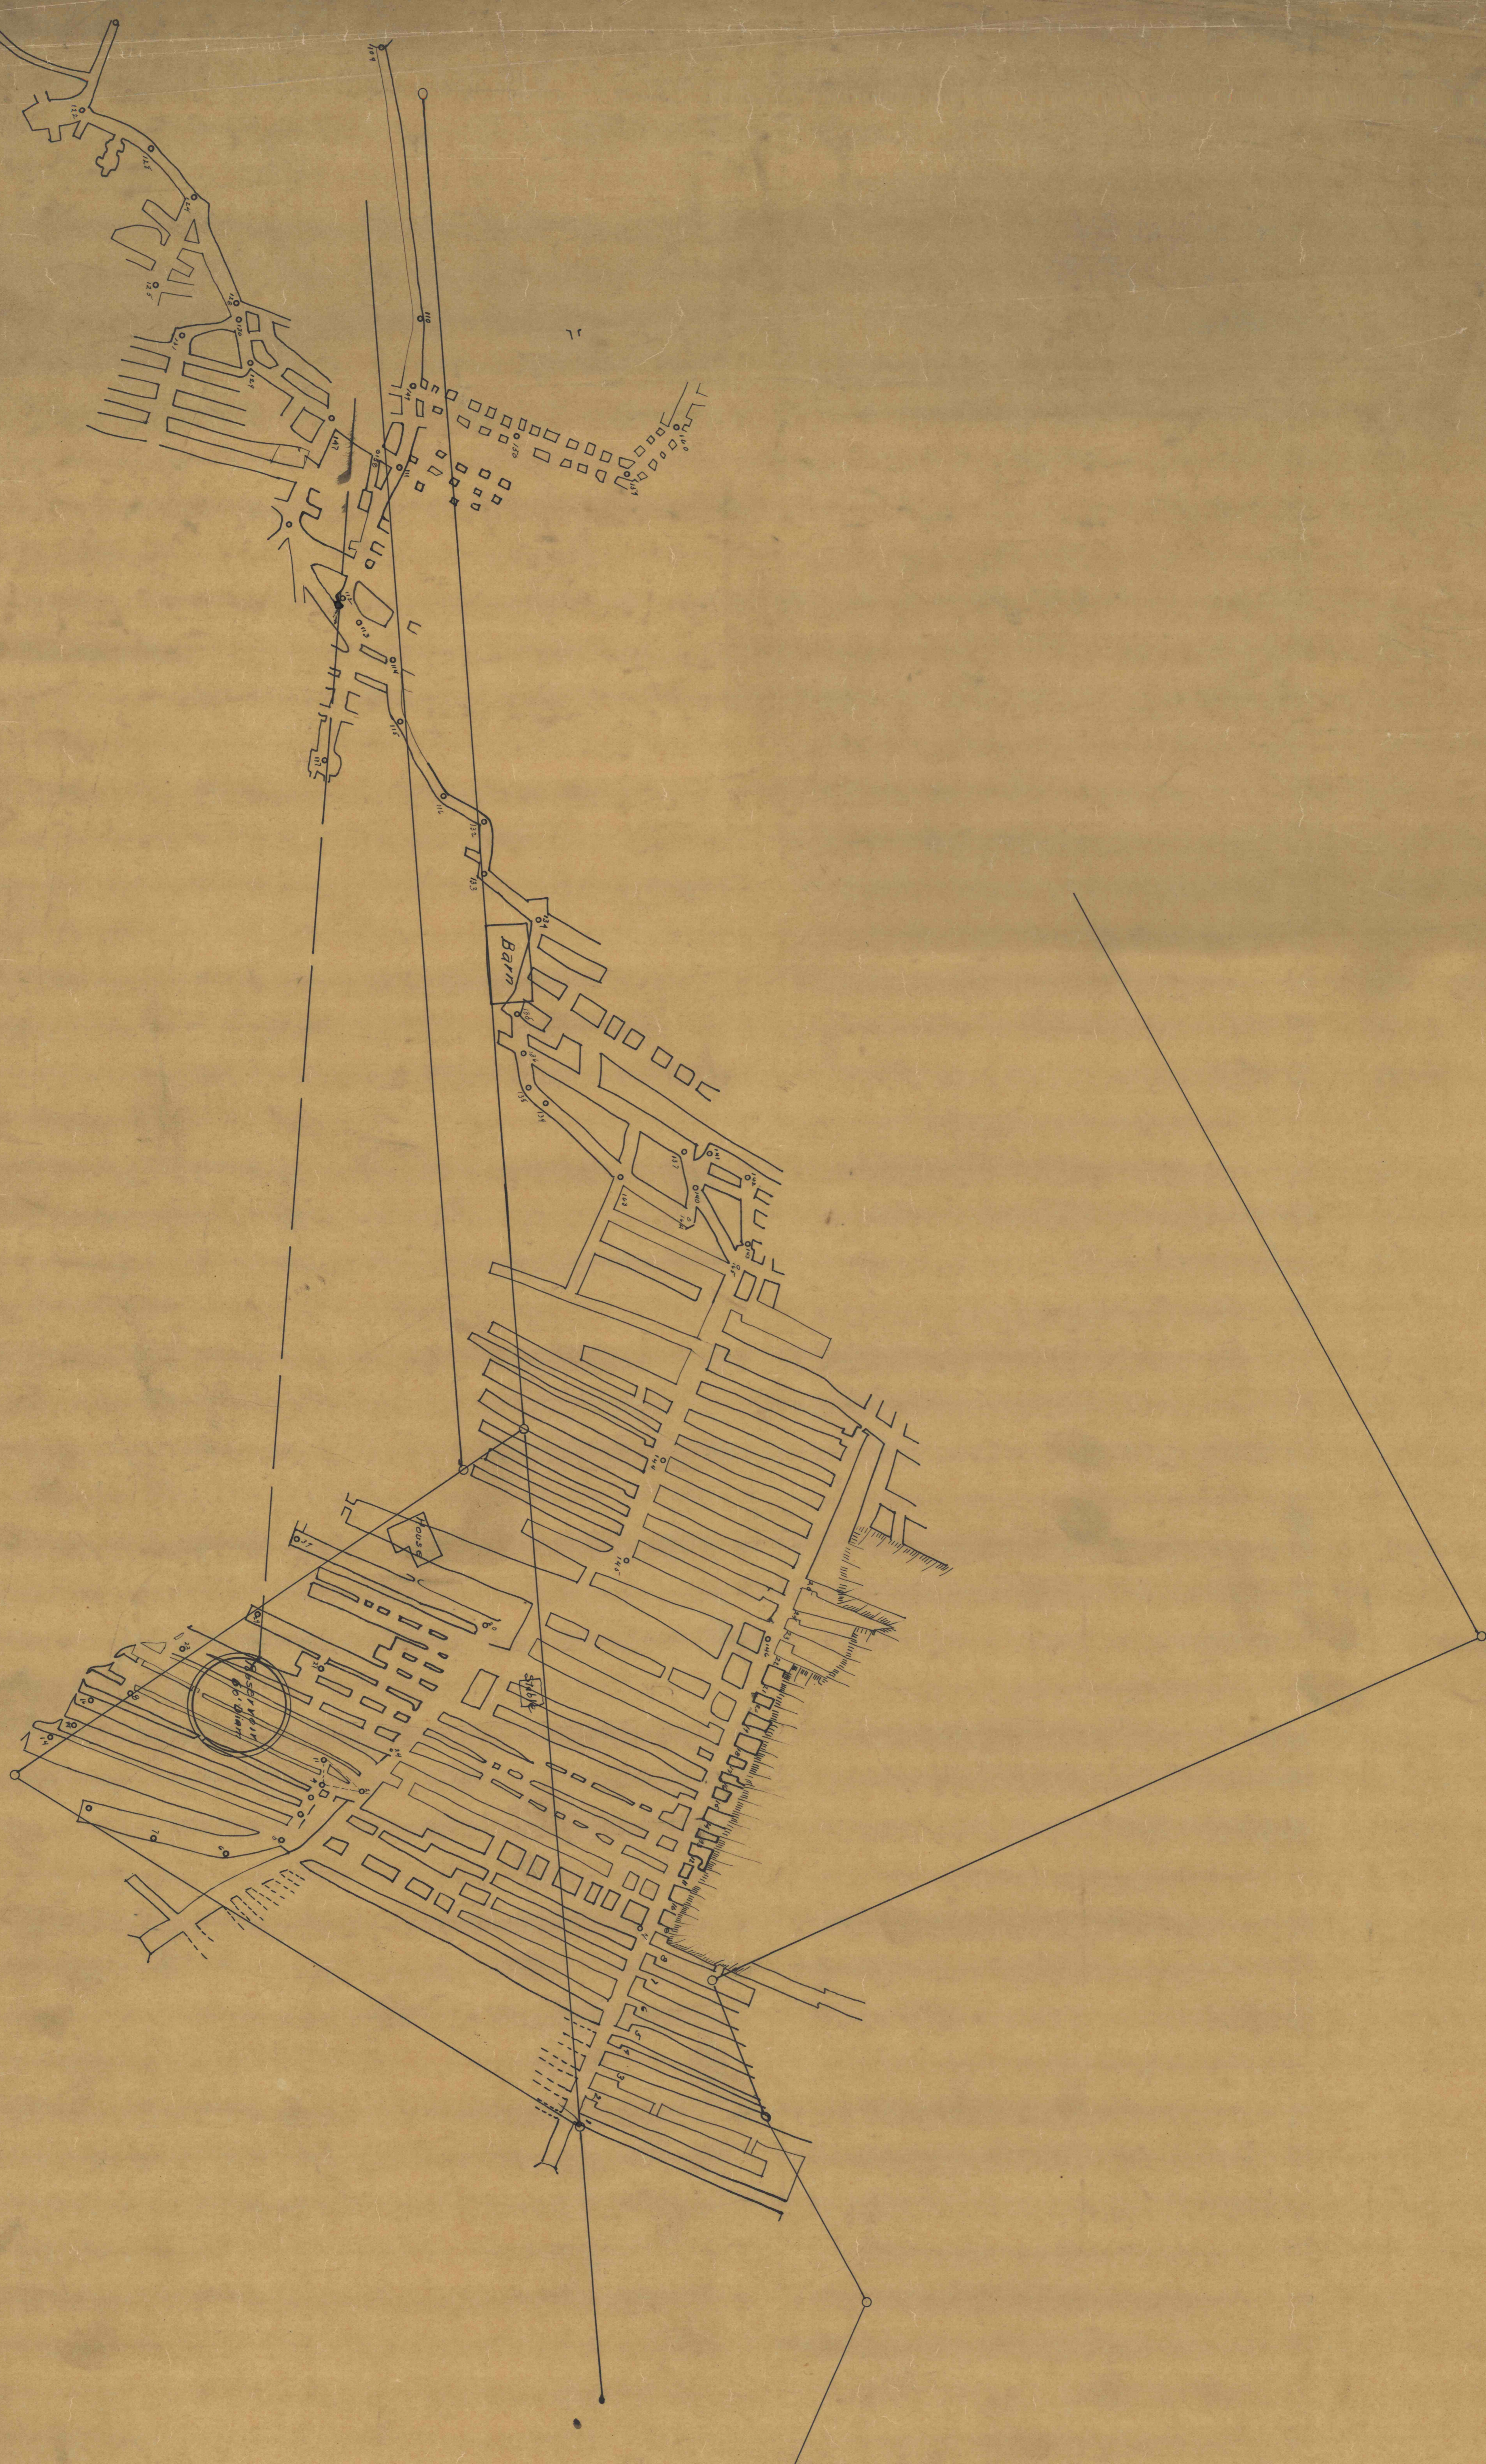

BLAIRSVILLE BOROUGH.
MINE WORKINGS UNDER RESERVOIR.
SCALE 1"=50'

Blair 6023