


SURFACE - ANDERSON BOYER
COAL - BESSEMER COKE CO

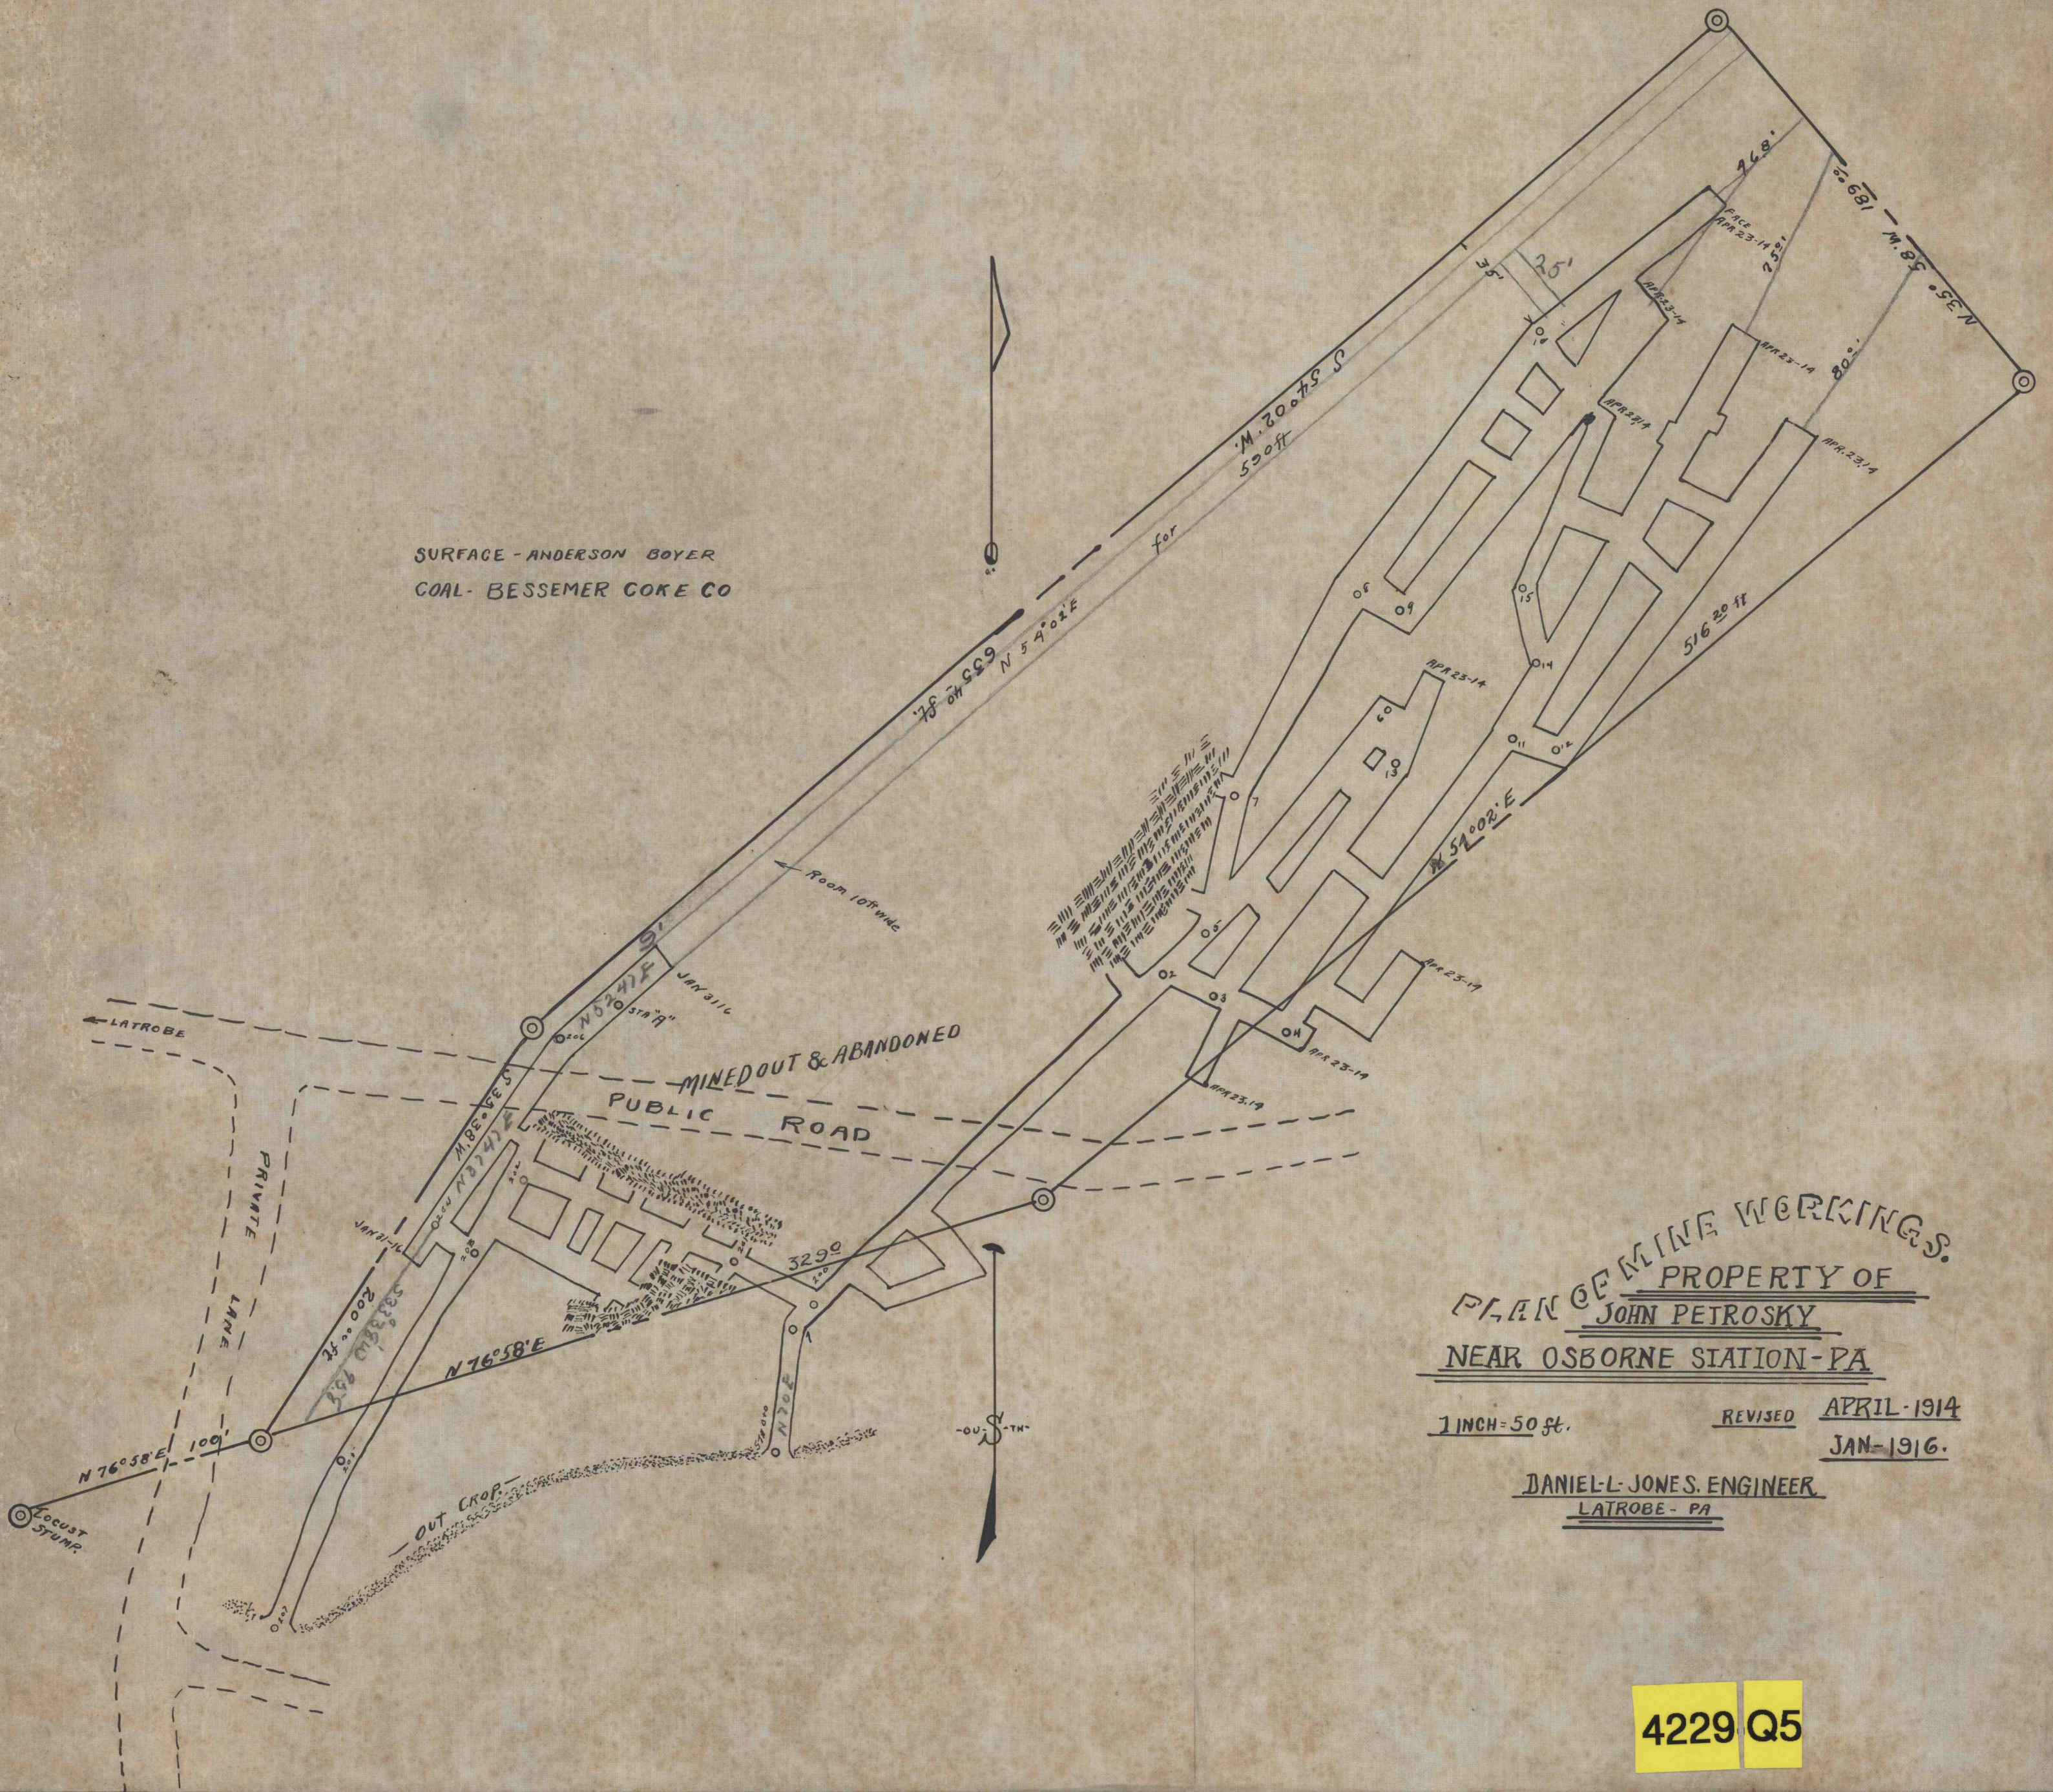

PLAN OF MINE WORKINGS.
PROPERTY OF
JOHN PETROSKY
NEAR OSBORNE STATION - PA

1 INCH = 50 ft.

REVISED APRIL - 1914
JAN - 1916.

DANIEL L. JONES, ENGINEER
LATROBE - PA

4229 Q5