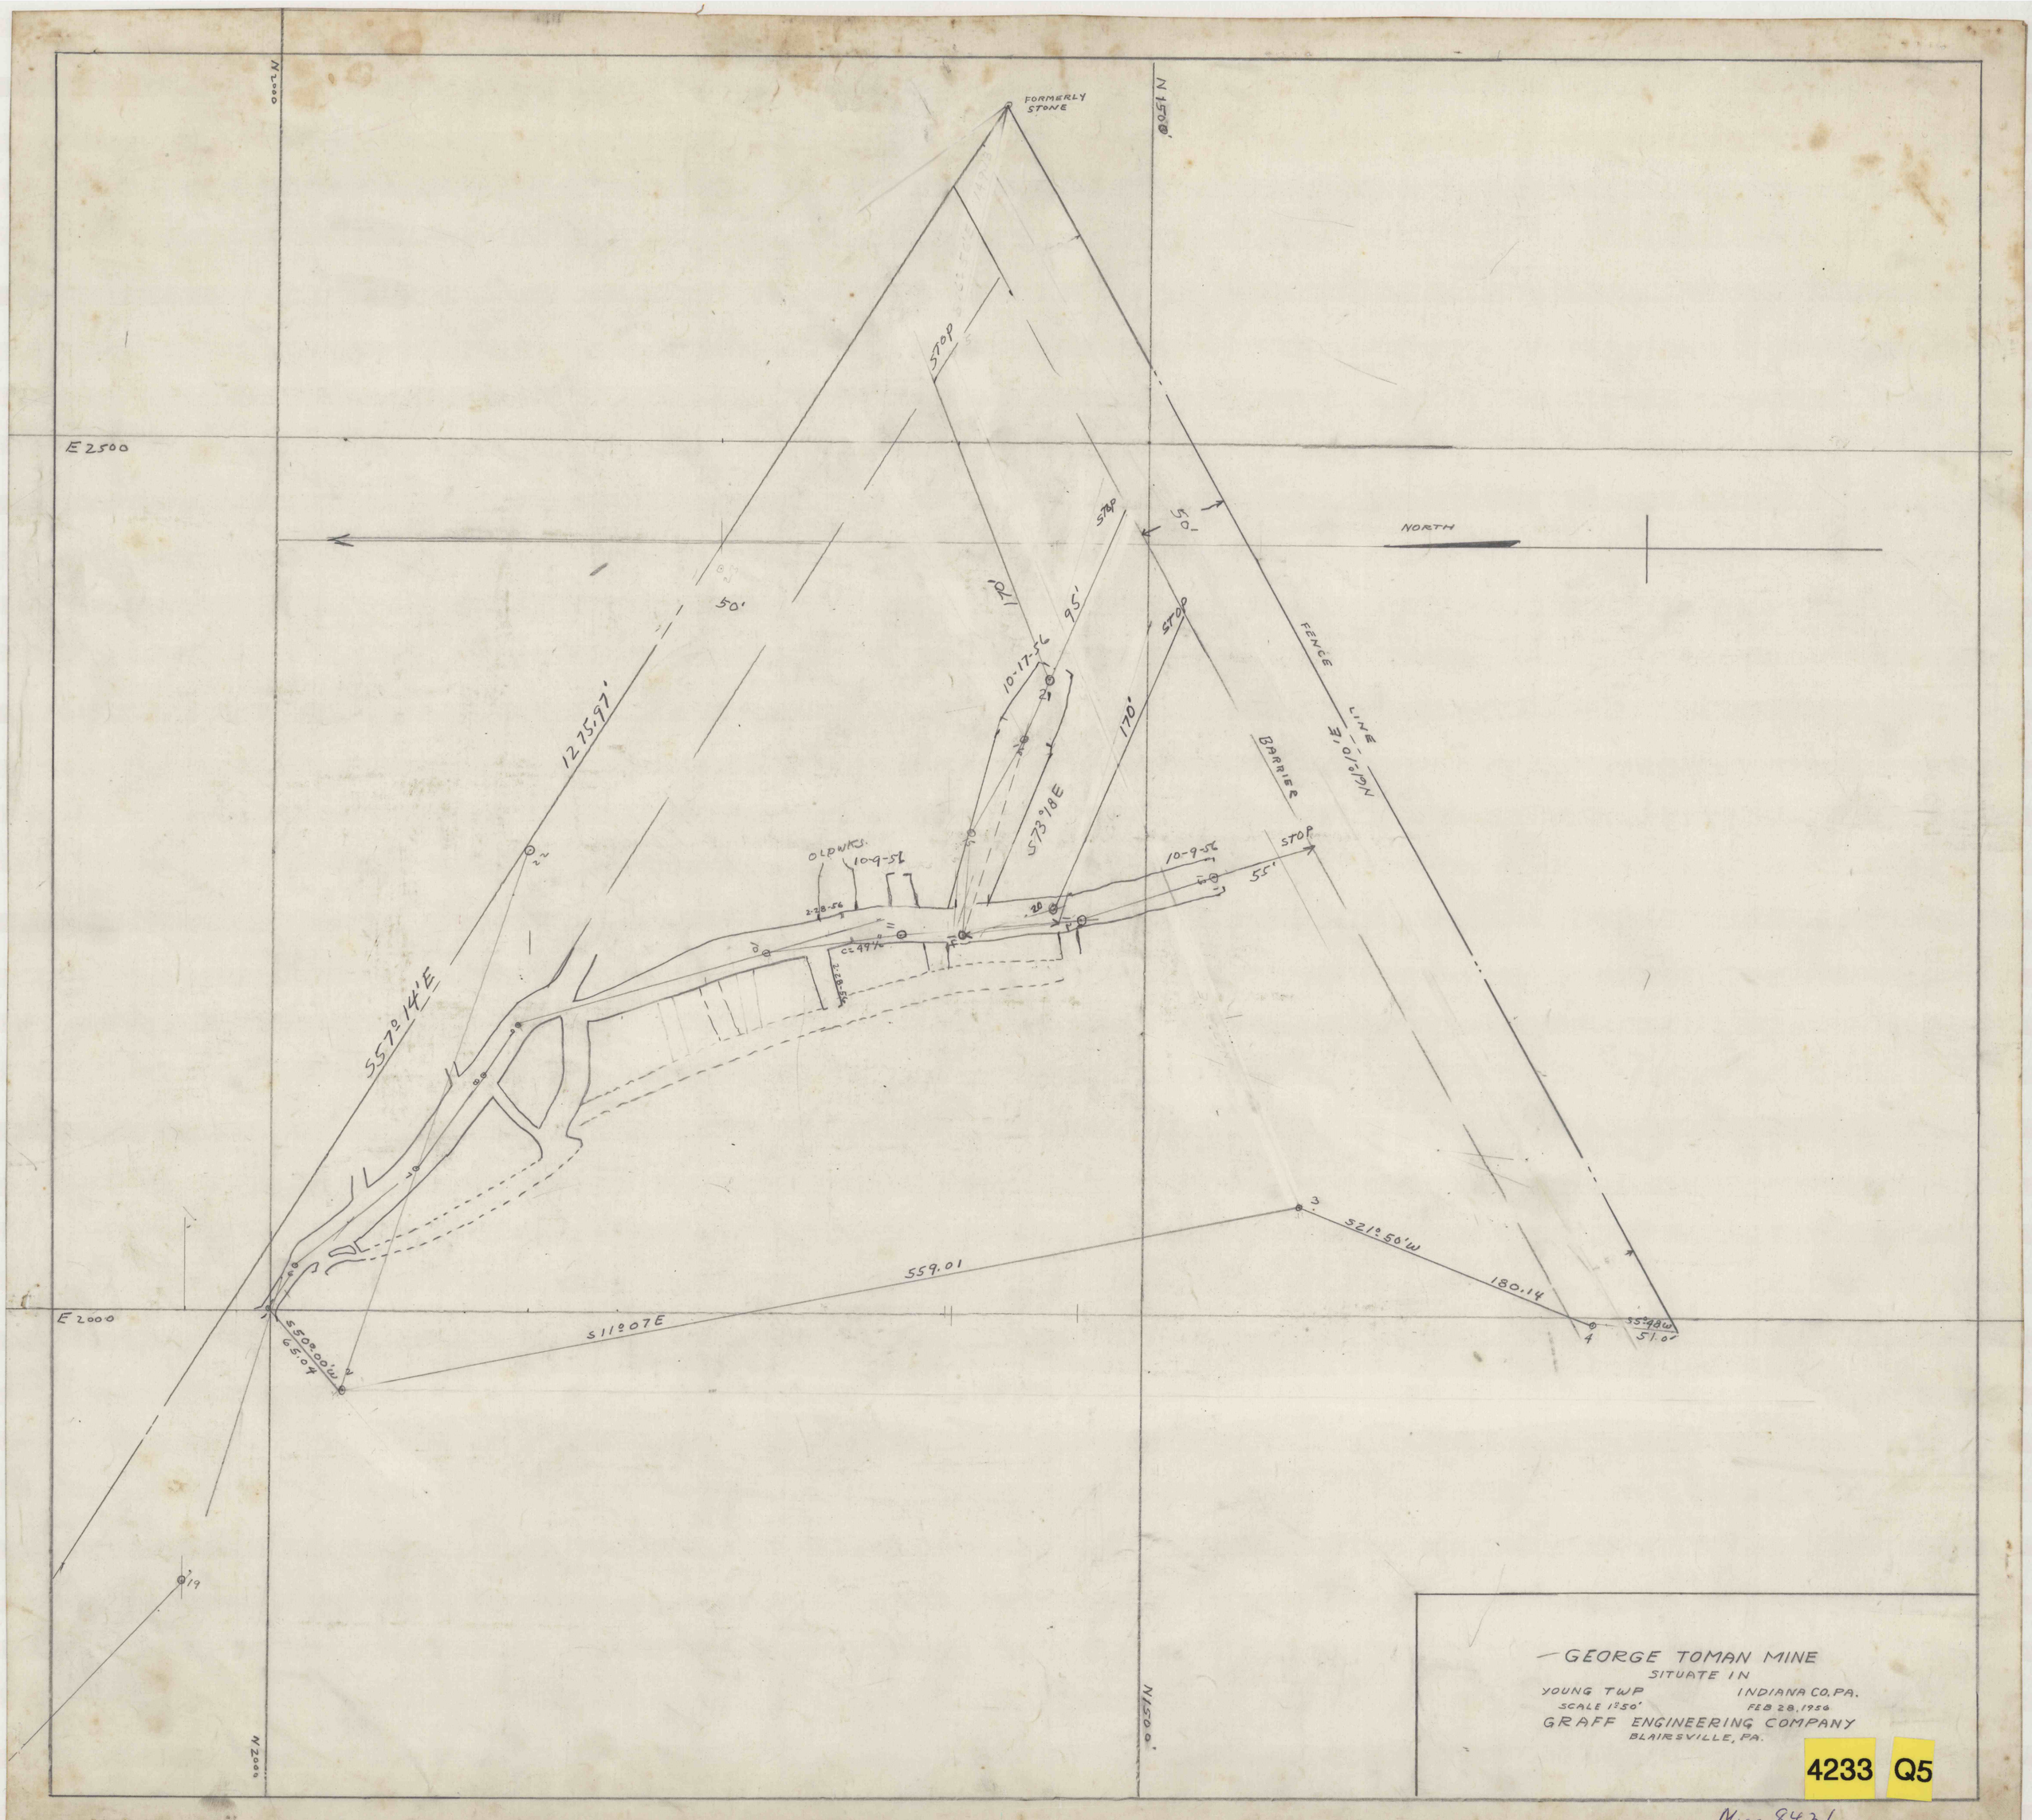

GEORGE TOMAN MINE
SITUATE IN
YOUNG TWP INDIANA CO. PA.
SCALE 1"=50' FEB 28, 1956
GRAFF ENGINEERING COMPANY
BLAIRSVILLE, PA.

4233 Q5

Misc 8436