


Mining Co  
Westmoreland

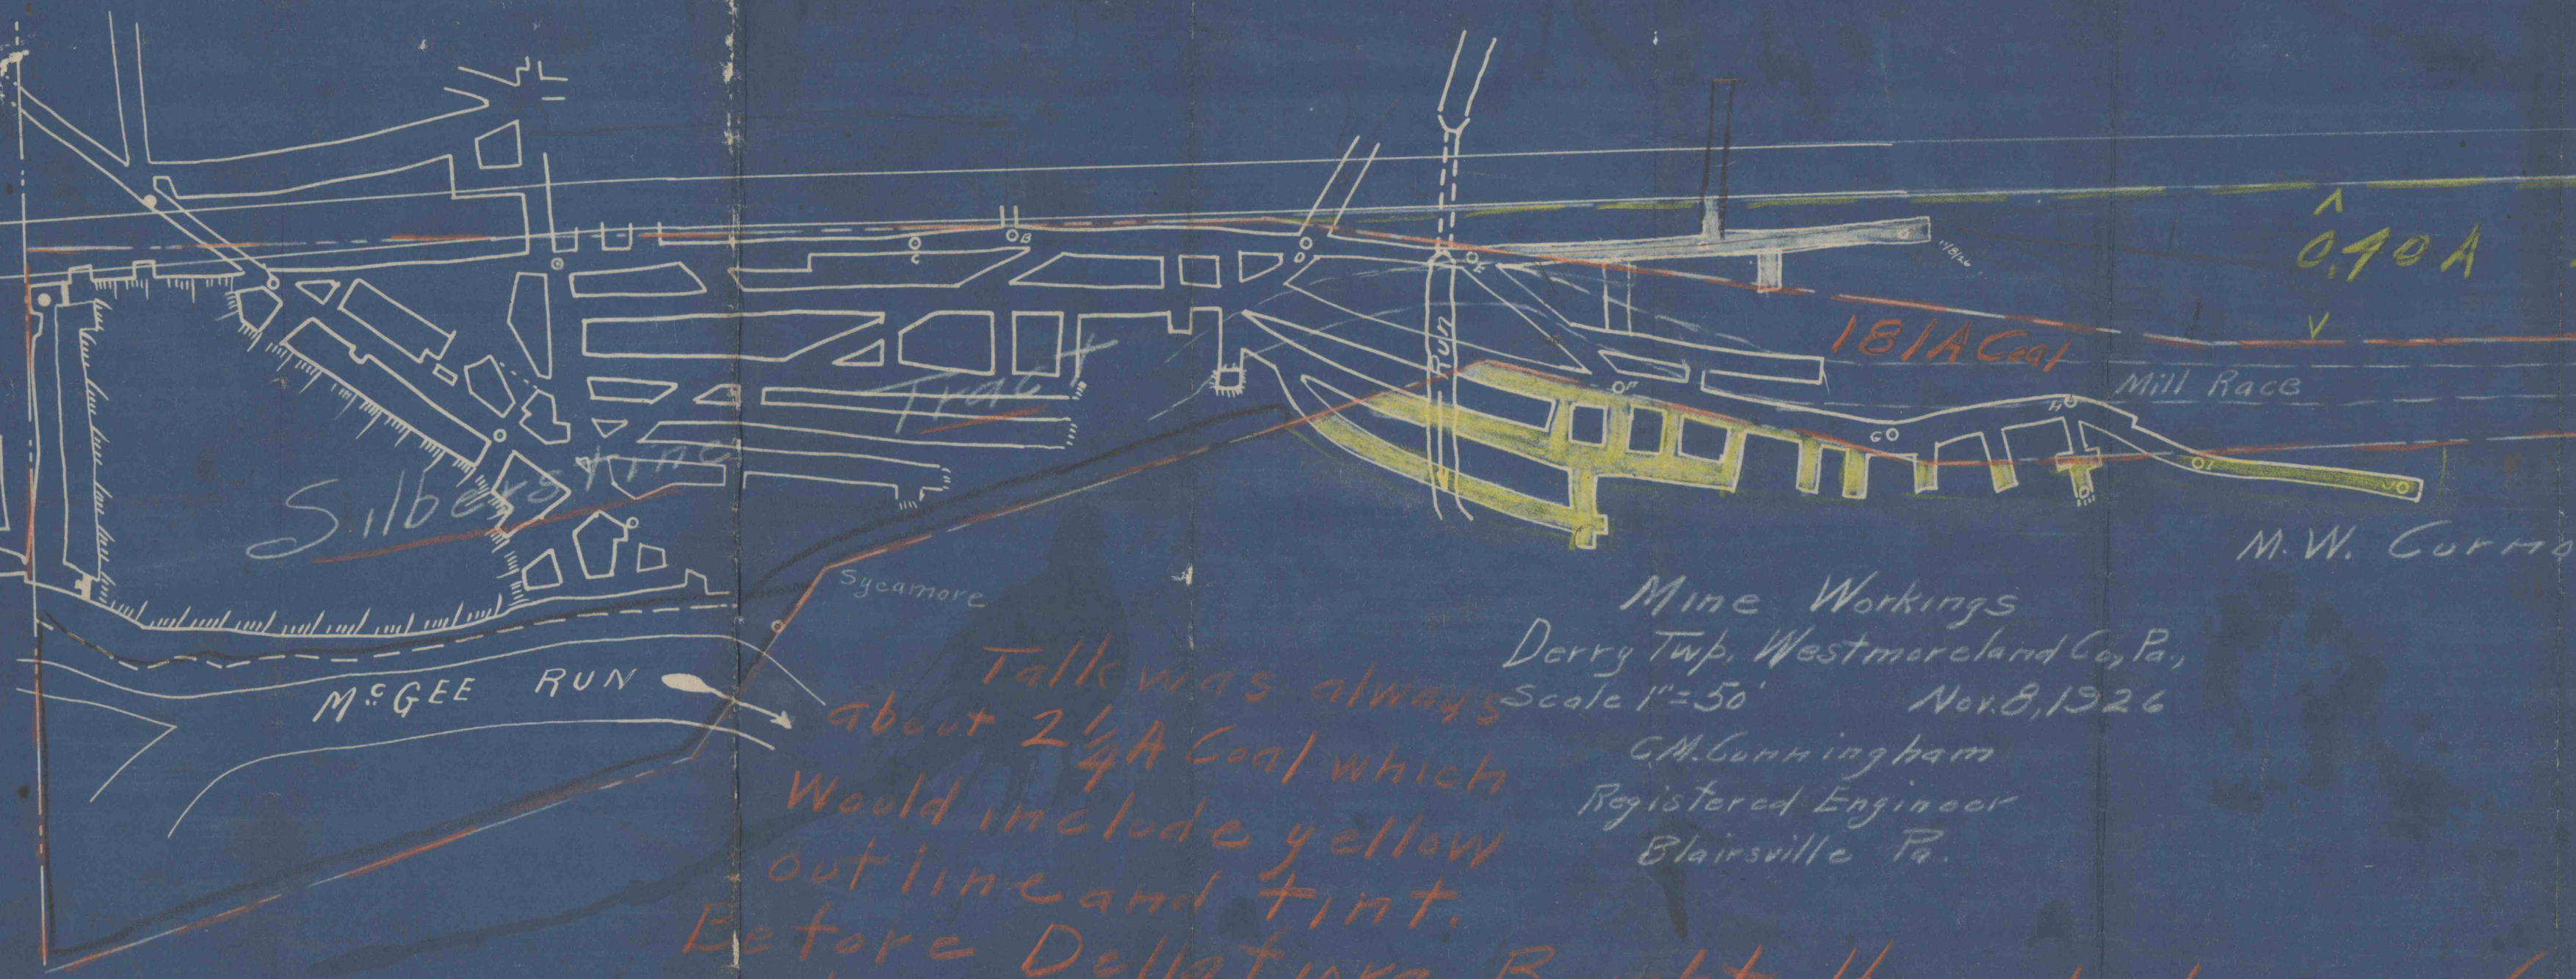

Silber

0.70 A

M.W. Currow

Red Oak

18 1/4 A Coal

Mill Race

M.W. Currow - Henderson Tract.

Mine Workings  
Derry Twp. Westmoreland Co, Pa.  
Scale 1"=50' Nov. 8, 1926  
G.M. Cunningham  
Registered Engineer  
Blairsville Pa.

Talk was always  
about 2 1/4 A Coal which  
would include yellow  
outline and tint.  
Before Dellatoro Bought He asked me if there was  
road

if there was 2 1/4 A below road

WC0408-5-2