


+X 2000

+X 1500

+X 1298.33
+Y 1000.00

+X 1000

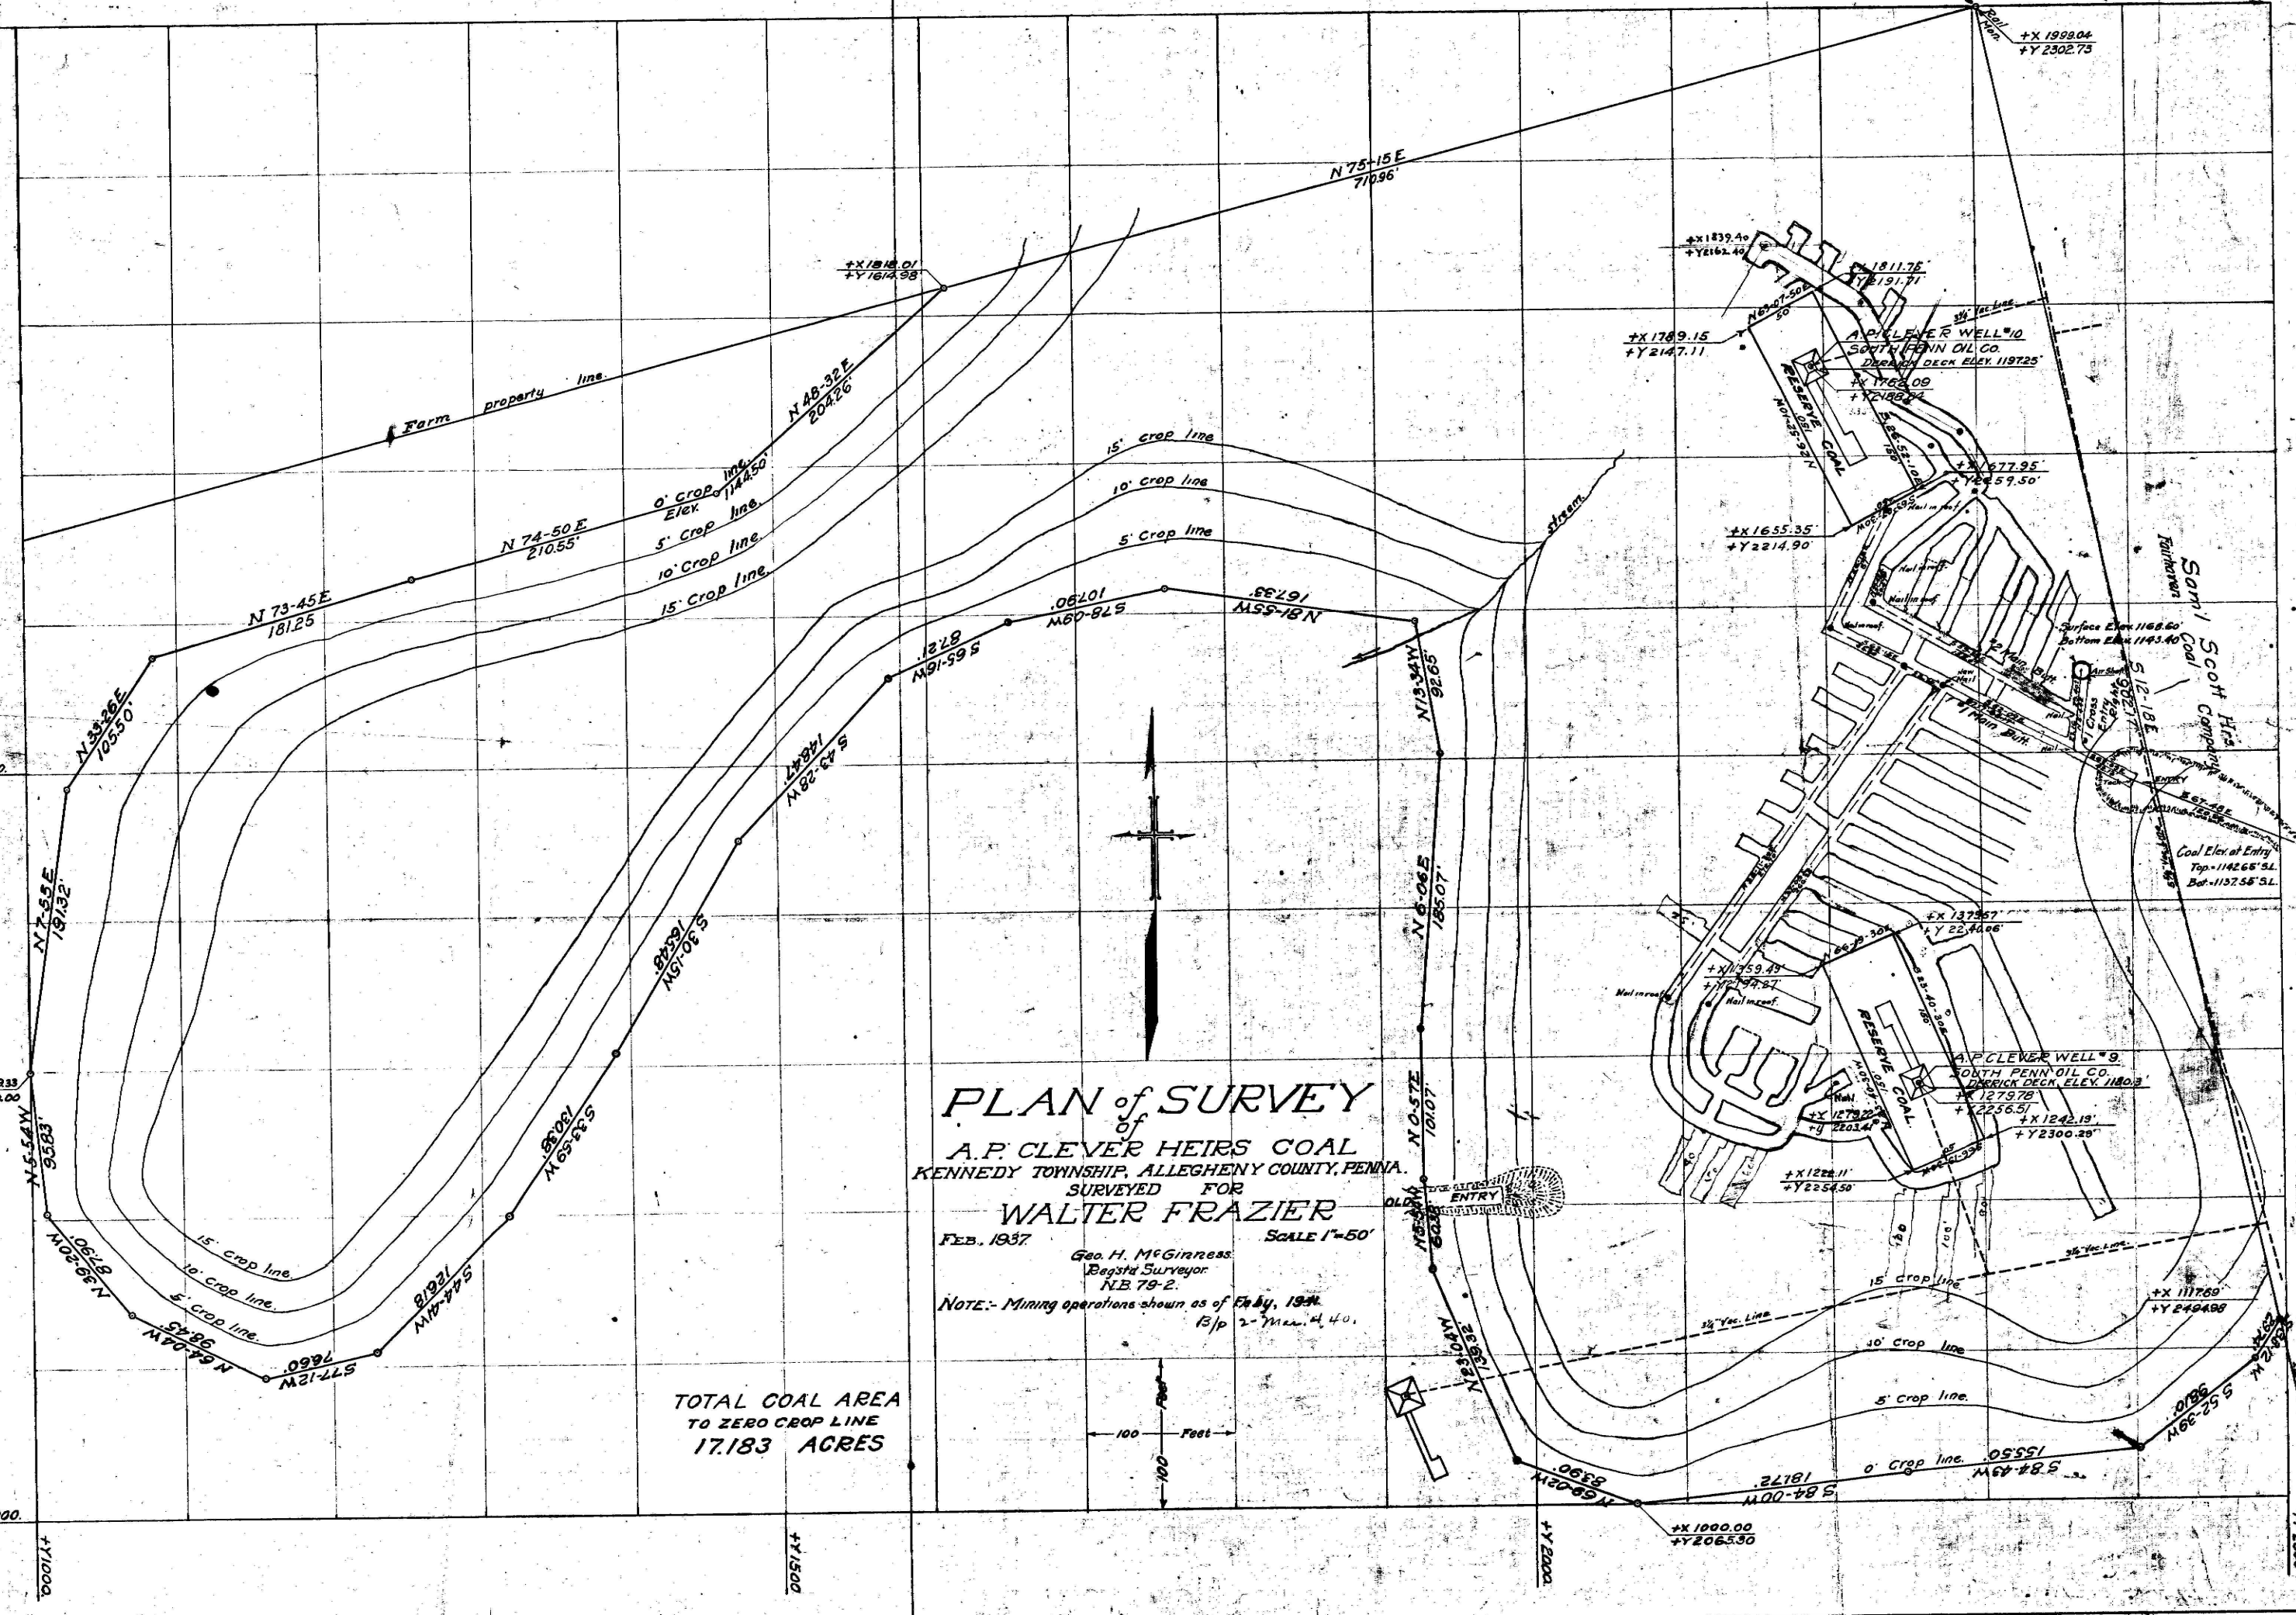

A. H. Hutton
S. L. A. S.

Sea Level Elev. 1222.75'
80-10' Cover on Coal

+X 1998.04
+Y 2302.75

+X 1789.15
+Y 2147.11

+X 1655.35
+Y 2214.90

+X 1375.57
+Y 2244.66

+X 1279.78
+Y 2256.51

+X 1242.19
+Y 2300.25

+X 1176.69
+Y 2494.98







+Y 2500

PLAN of SURVEY

A.P. CLEVER HEIRS COAL
KENNEDY TOWNSHIP, ALLEGHENY COUNTY, PENNA.
SURVEYED FOR
WALTER FRAZIER

FEB. 1937

Geo. H. McGinness
Registered Surveyor
No. 79-2

SCALE 1"=50'

NOTE:- Mining operations shown as of Feb. 1934
B/p 2-11-34, 40.

TOTAL COAL AREA
TO ZERO CROP LINE
17.183 ACRES

