


JOSEPH S. WORK EST.

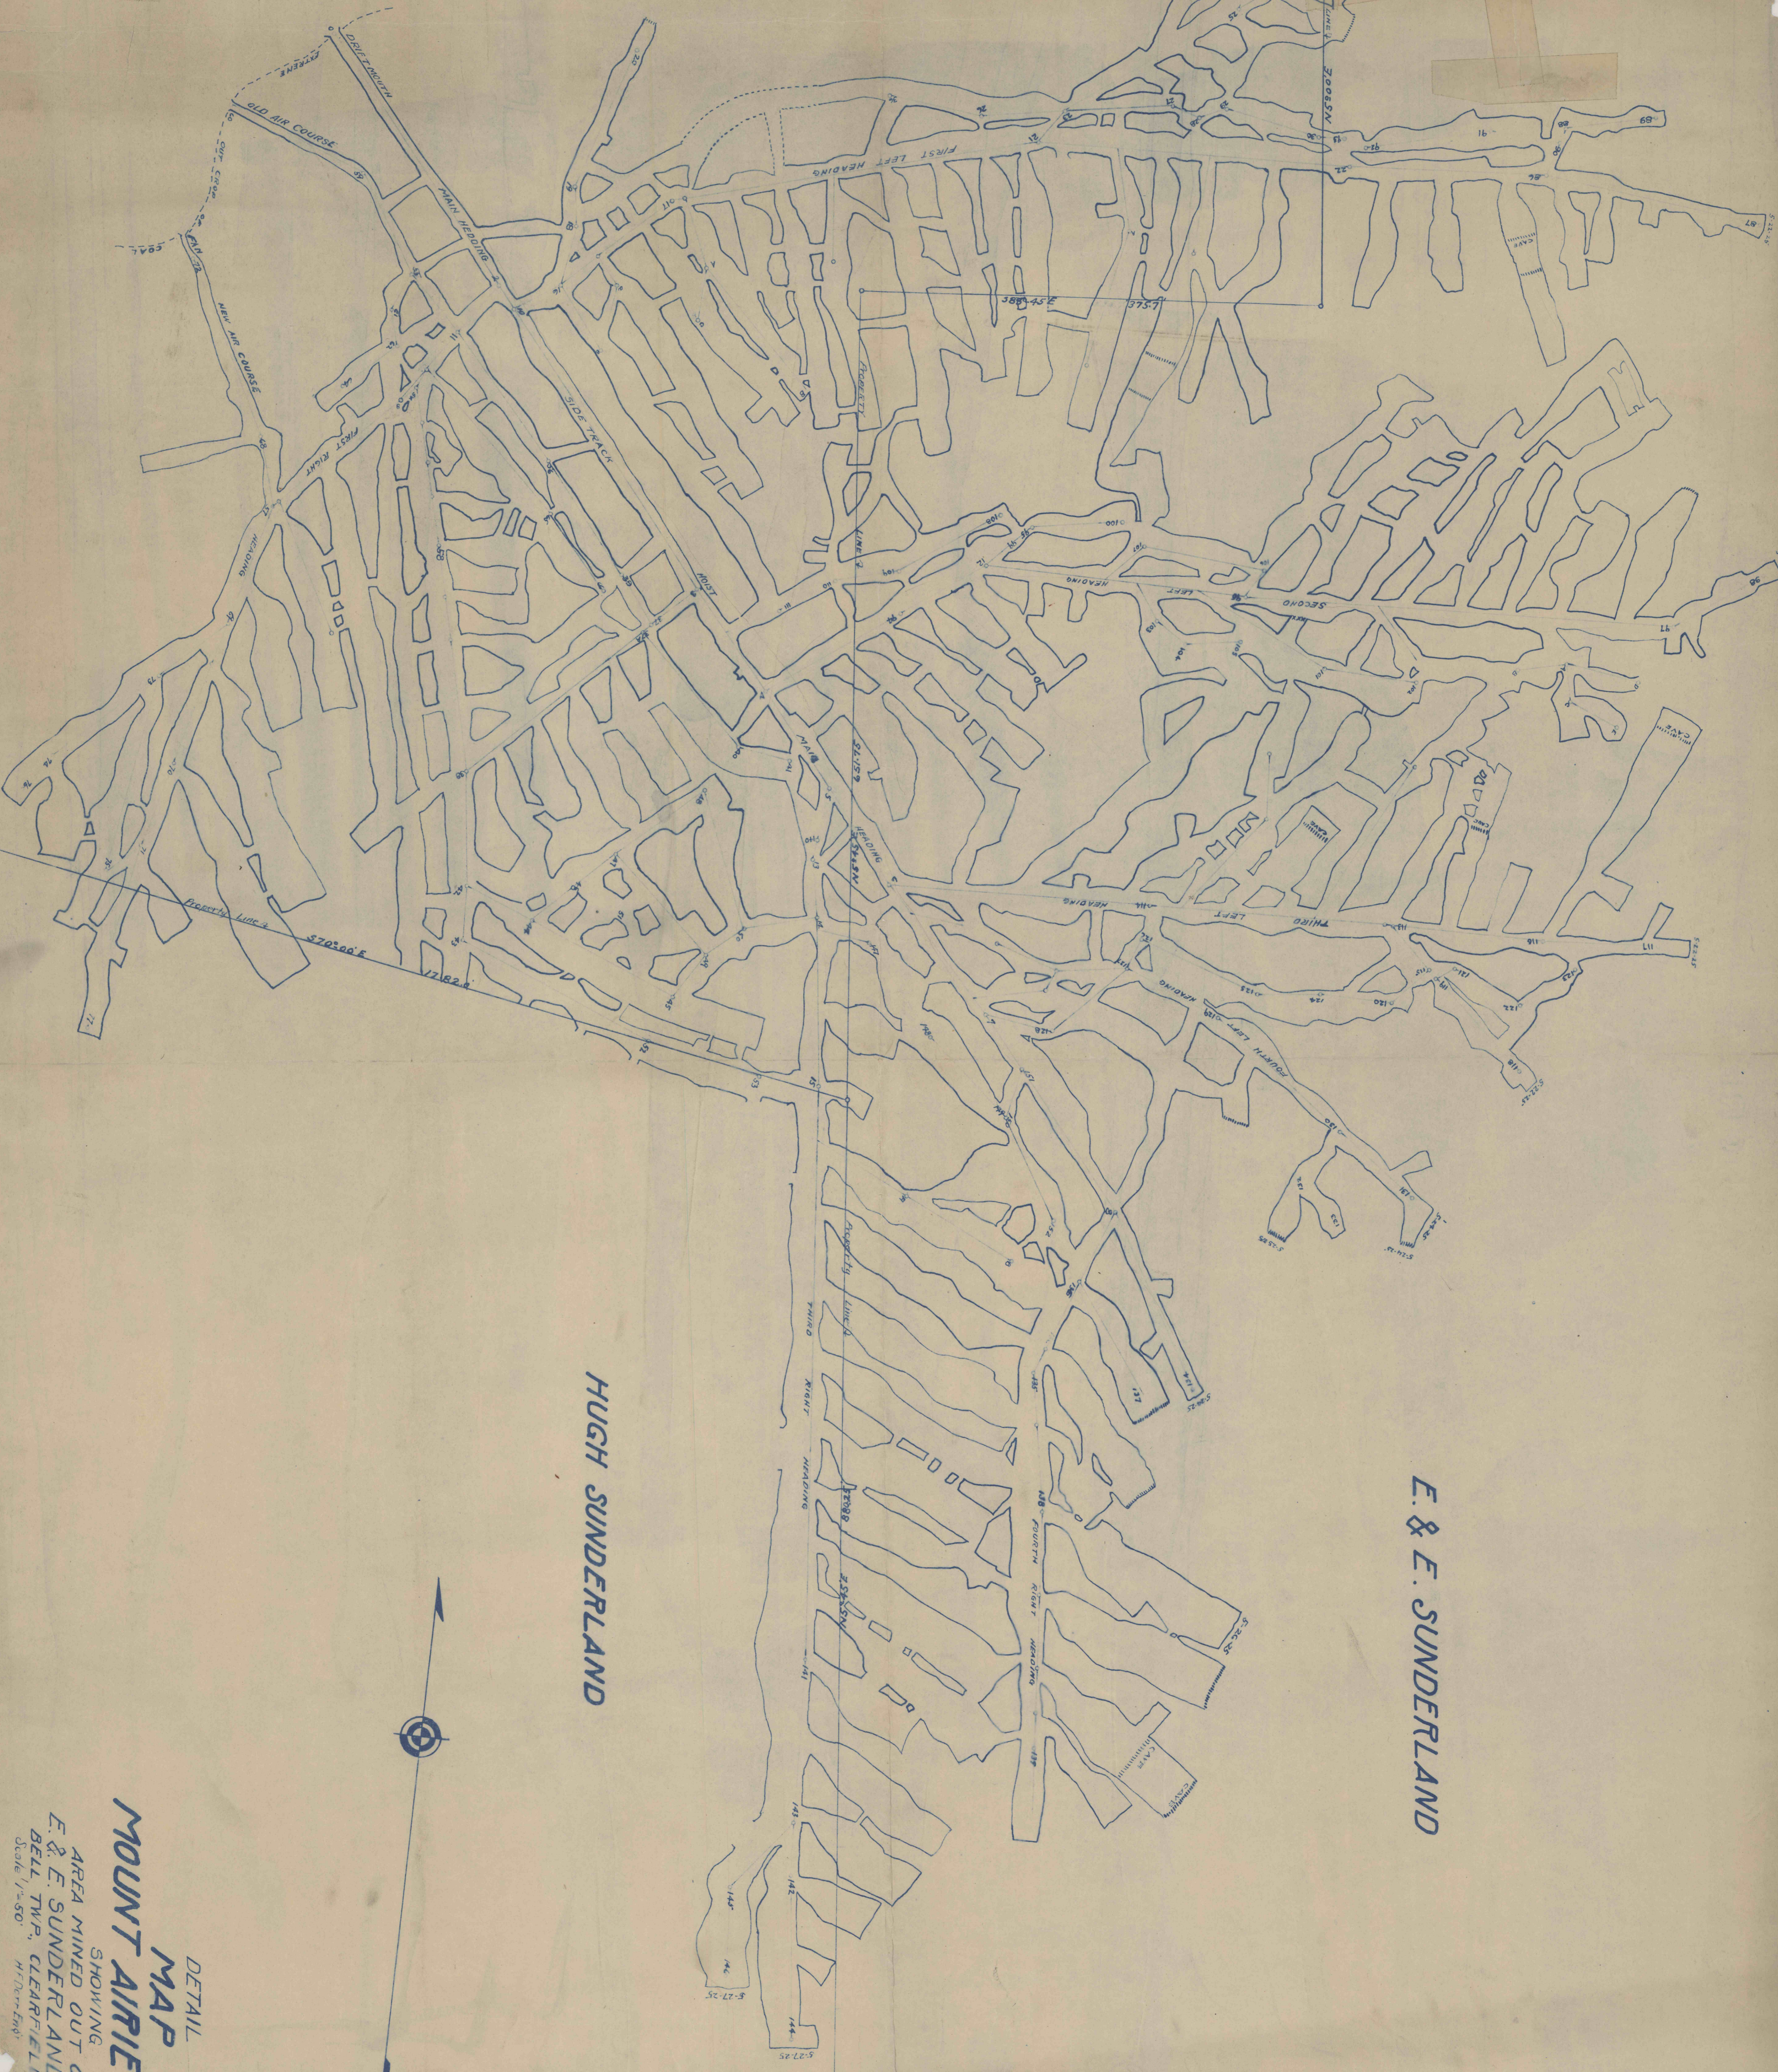

HUGH SUNDERLAND

E. & E. SUNDERLAND

TIMOTHY SUNDERLAND

DETAIL MAP MOUNT AIRIE MINE

SHOWING AREA MINED OUT ON THE E. & E. SUNDERLAND TRACT

BELL TWP. CLEARFIELD CO. PA. Scale 1"=50'