



JOSEPH S. WORK EST.

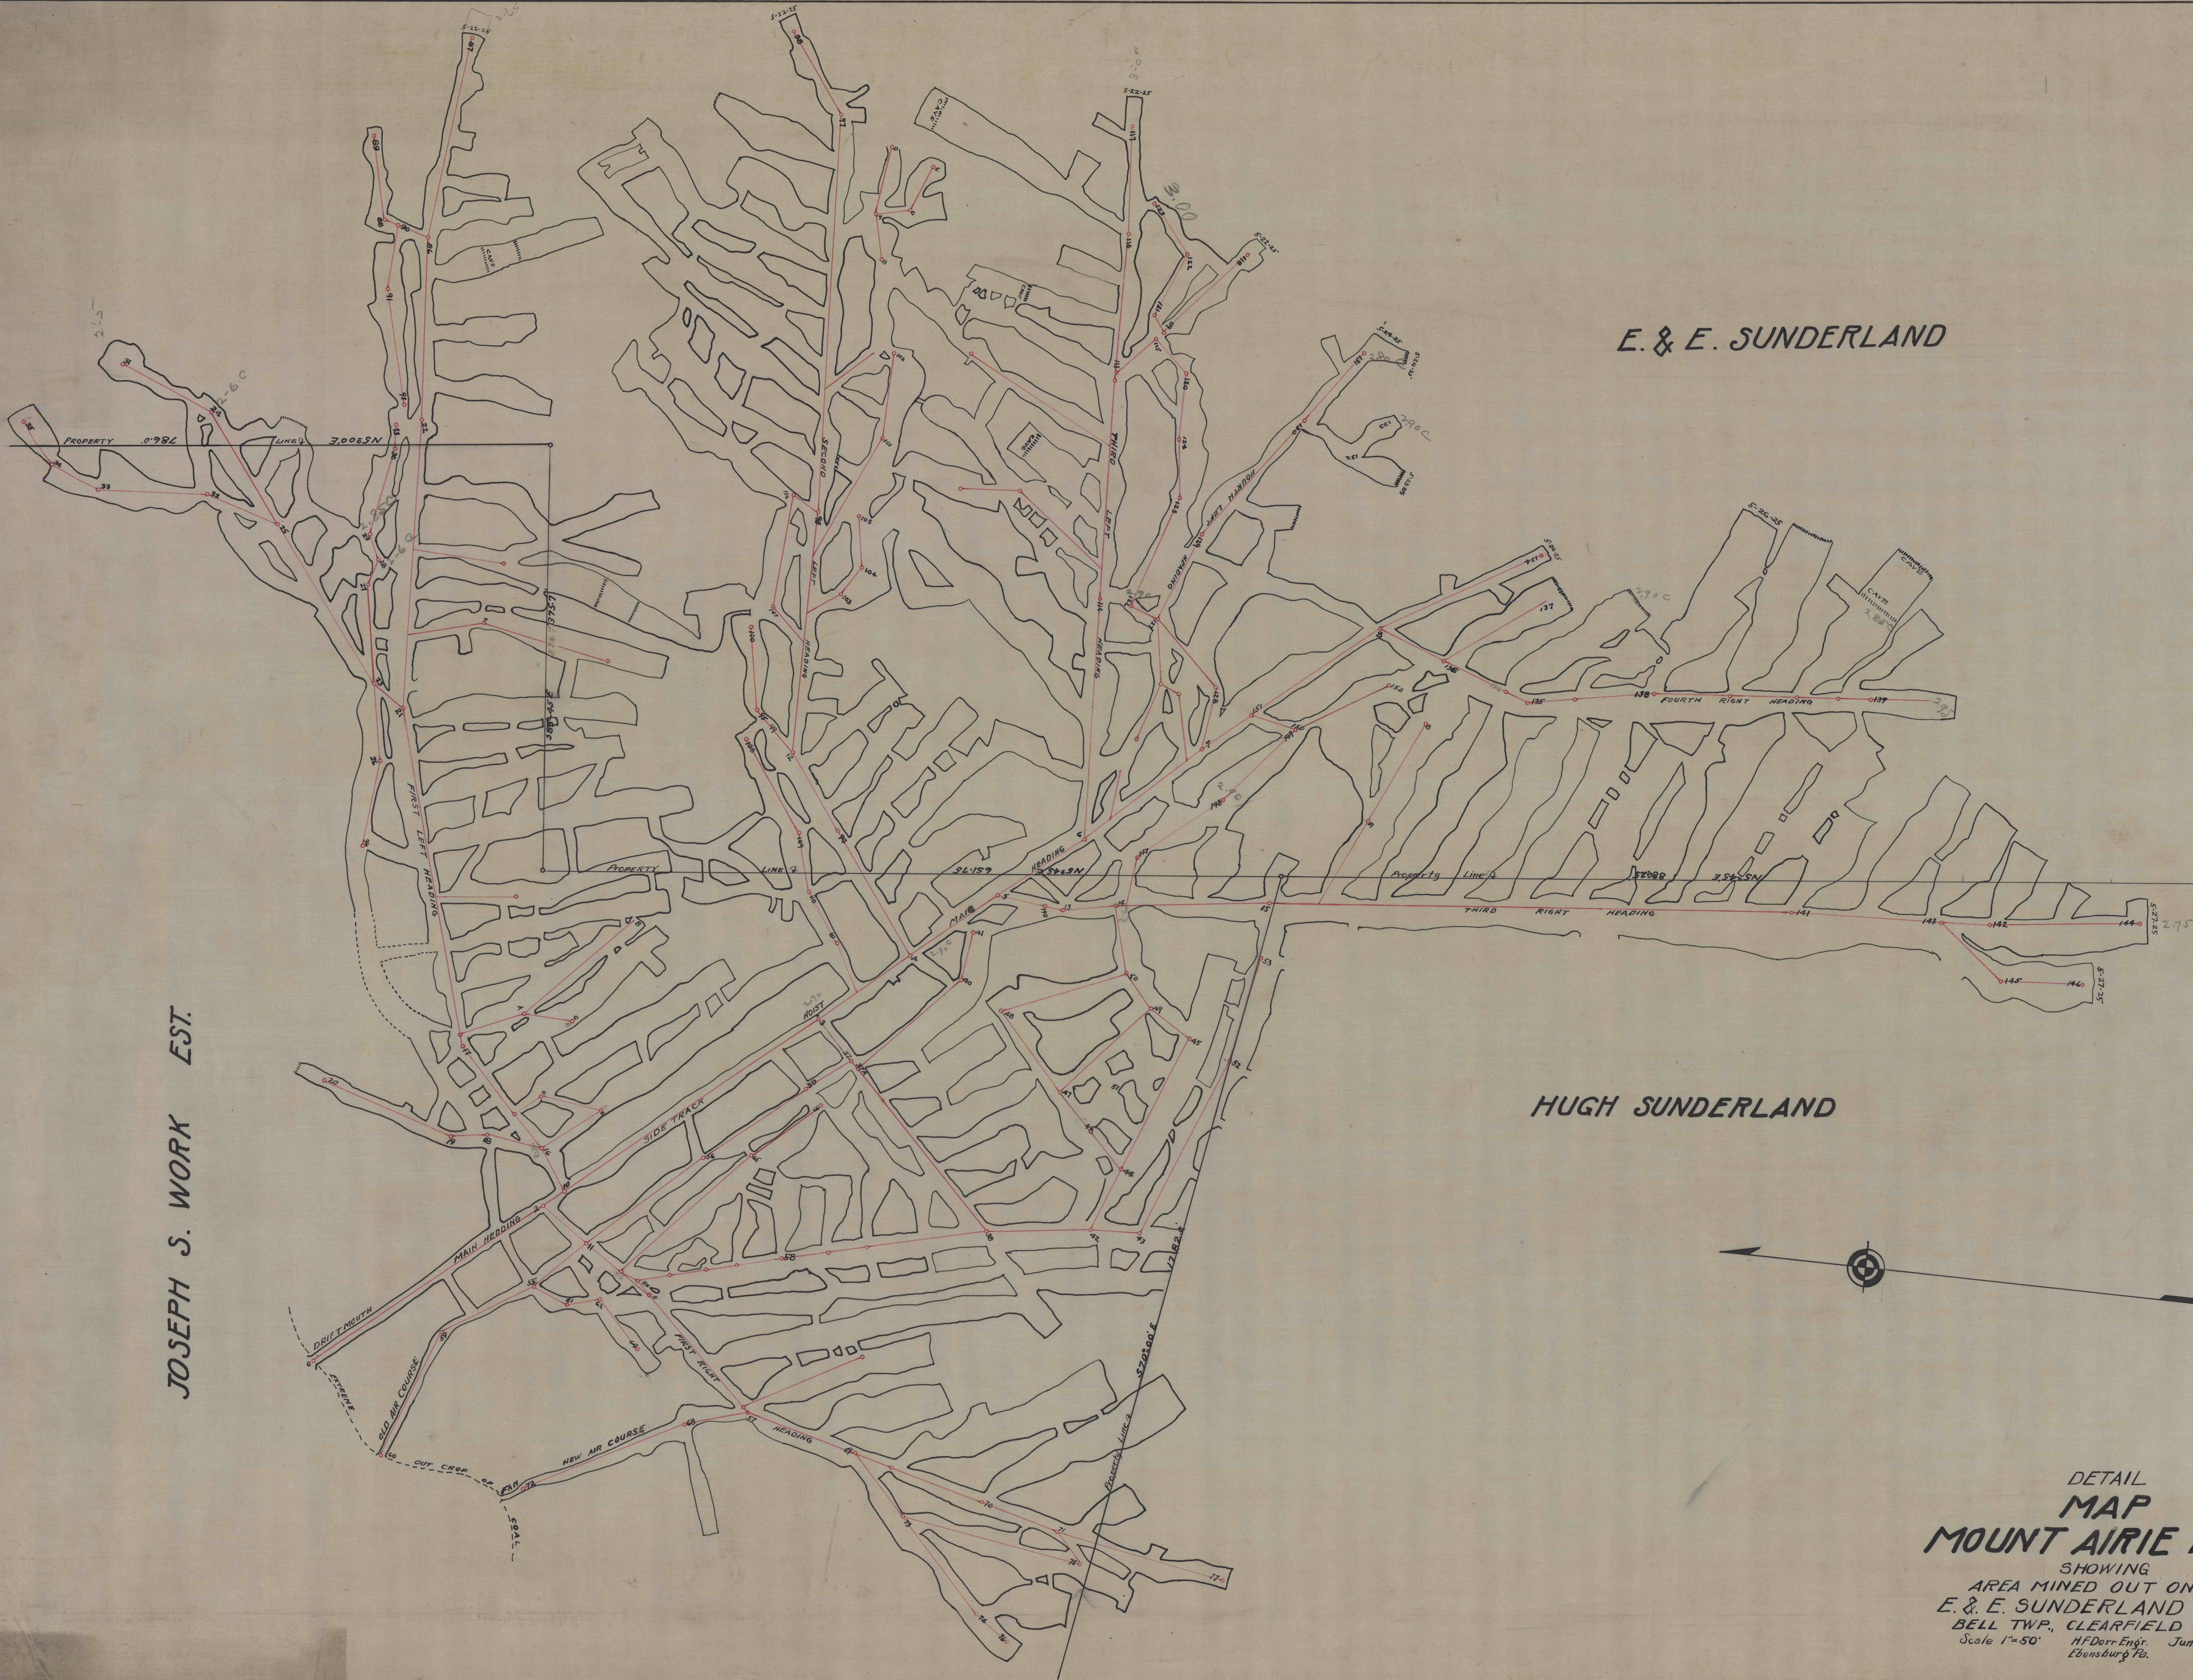

E. & E. SUNDERLAND

TIMOTHY SUNDERLAND

HUGH SUNDERLAND

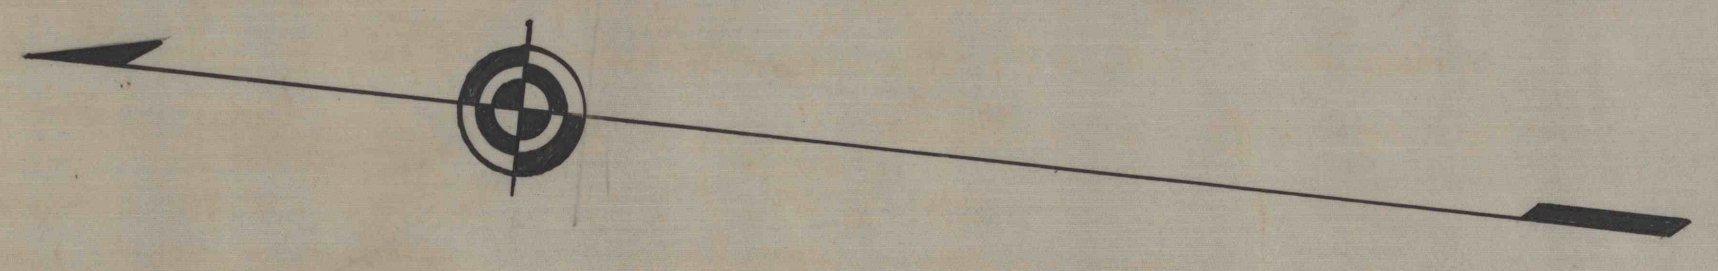

DETAIL  
MAP  
MOUNT AIRIE MINE  
SHOWING  
AREA MINED OUT ON THE  
E. & E. SUNDERLAND TRACT  
BELL TWP., CLEARFIELD CO. PA.  
Scale 1"=50' HFDorr Engr. June 16-1925  
Ebensburg Pa.