

**PLAN  
OF  
HAYS COAL CO. MINE,**

Situated in Hays Boro, Allegheny County Pa.



SCALE 1 IN. = 50 FT.

OCTOBER, 1919.

F.L. HILL  
ENG.

UNMINED COAL TINTED RED JUNE, 1, 1920 - 0.25 ACRE.

**PITTSBURGH SEAM**

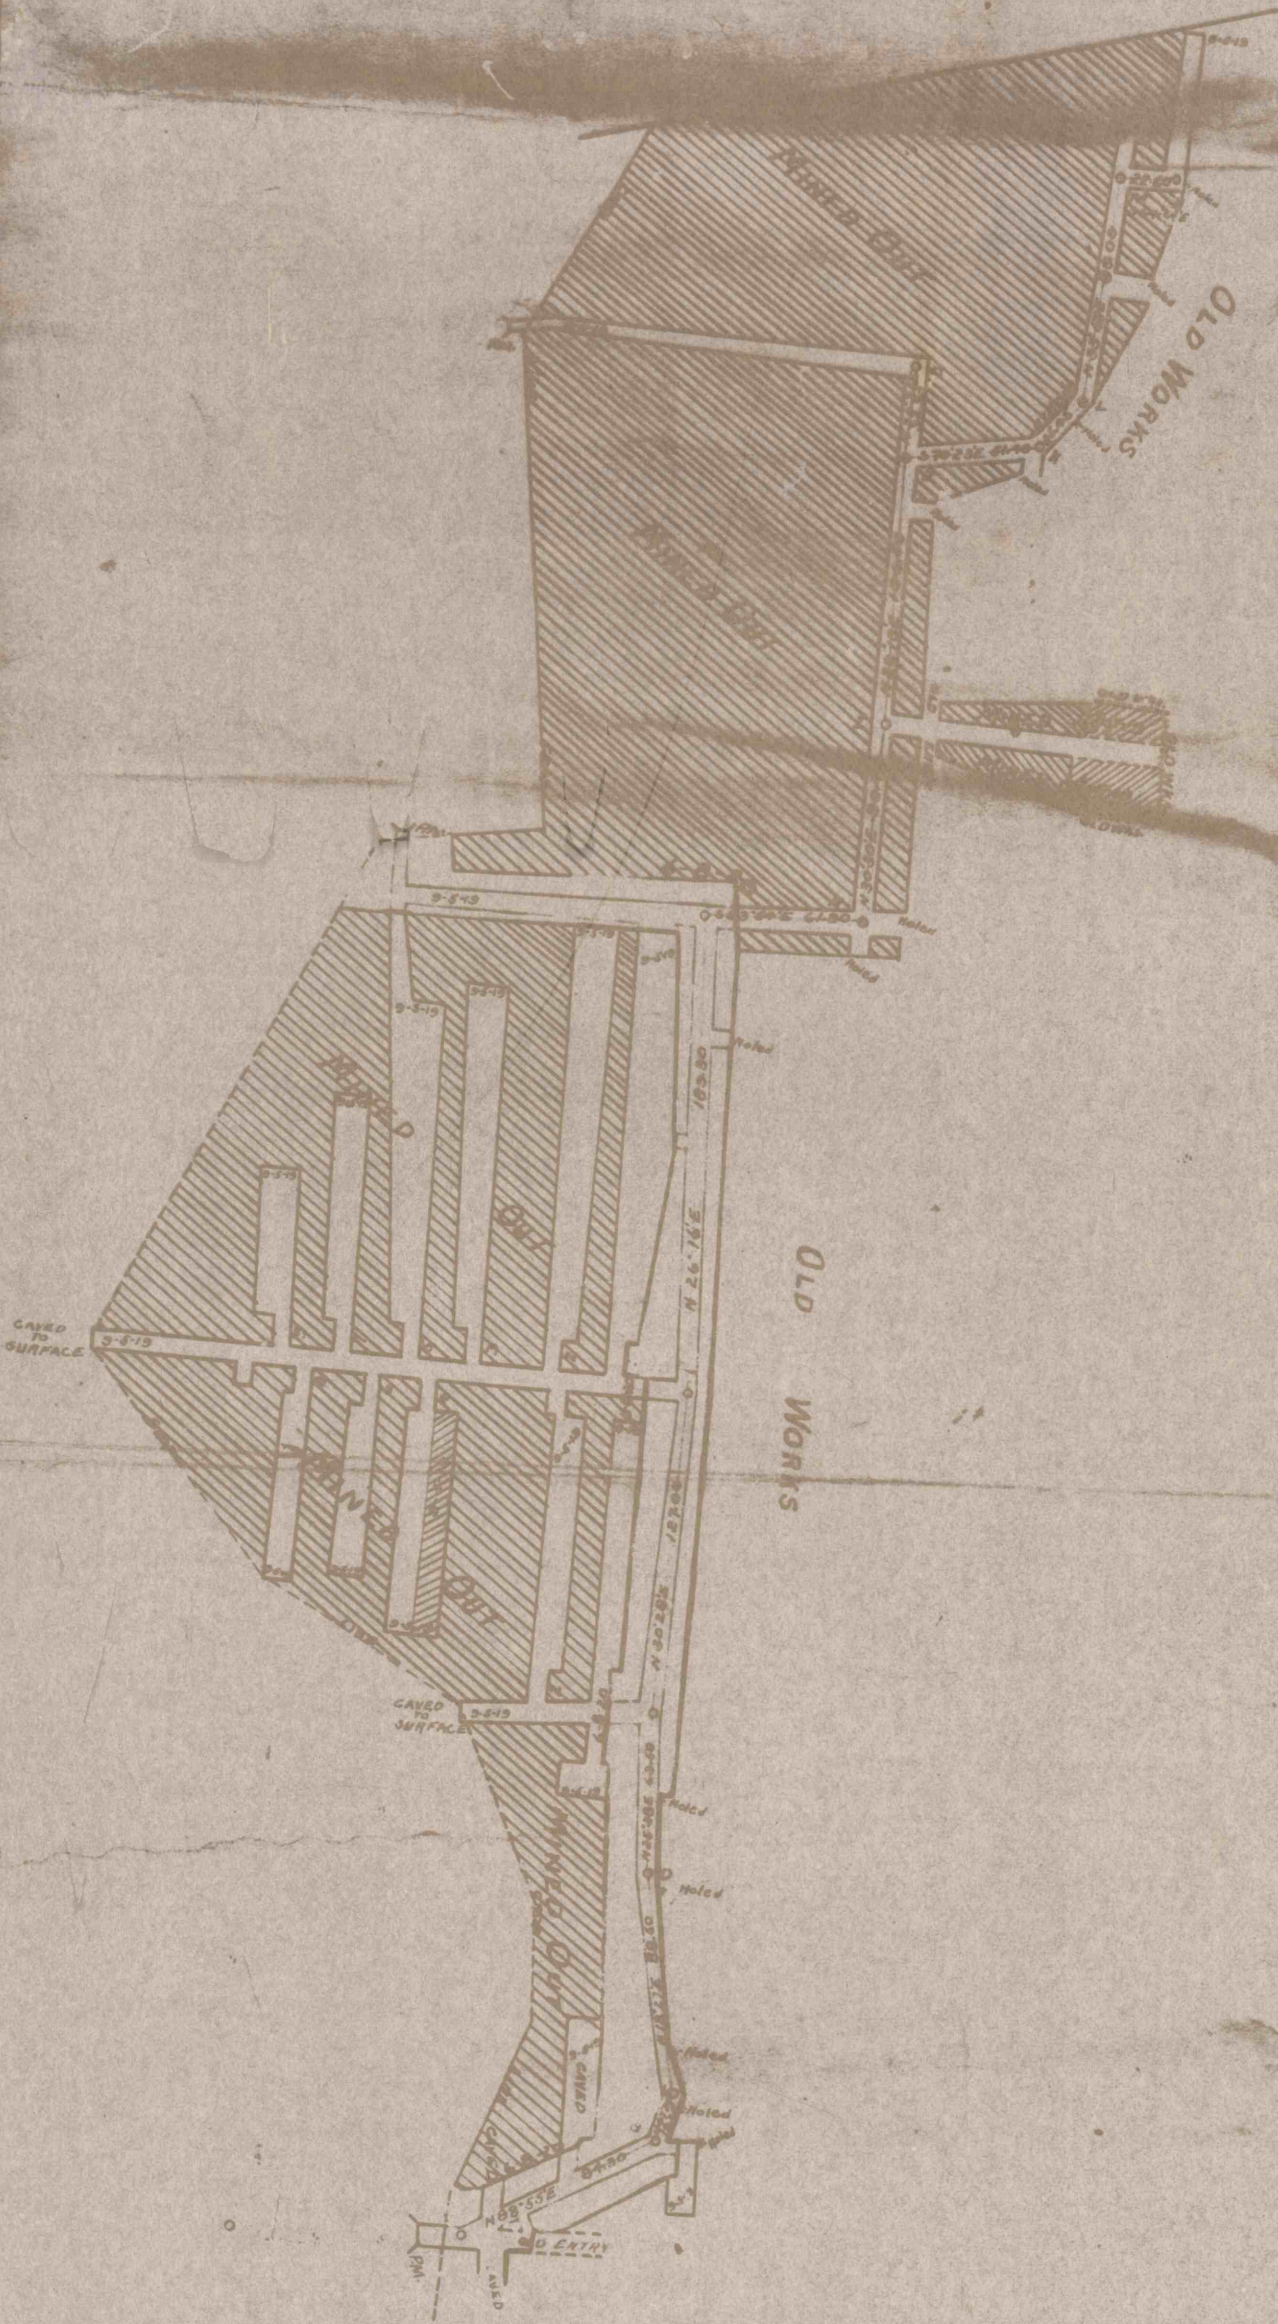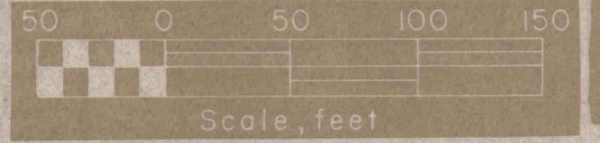

103006

156

22X

302390