

SHAN, SEC. 12
NR. 265

FT. TO 274

E 21000

FT. TO 251


E 22000

E 23000

FT. TO 250

E 24000


E 25000

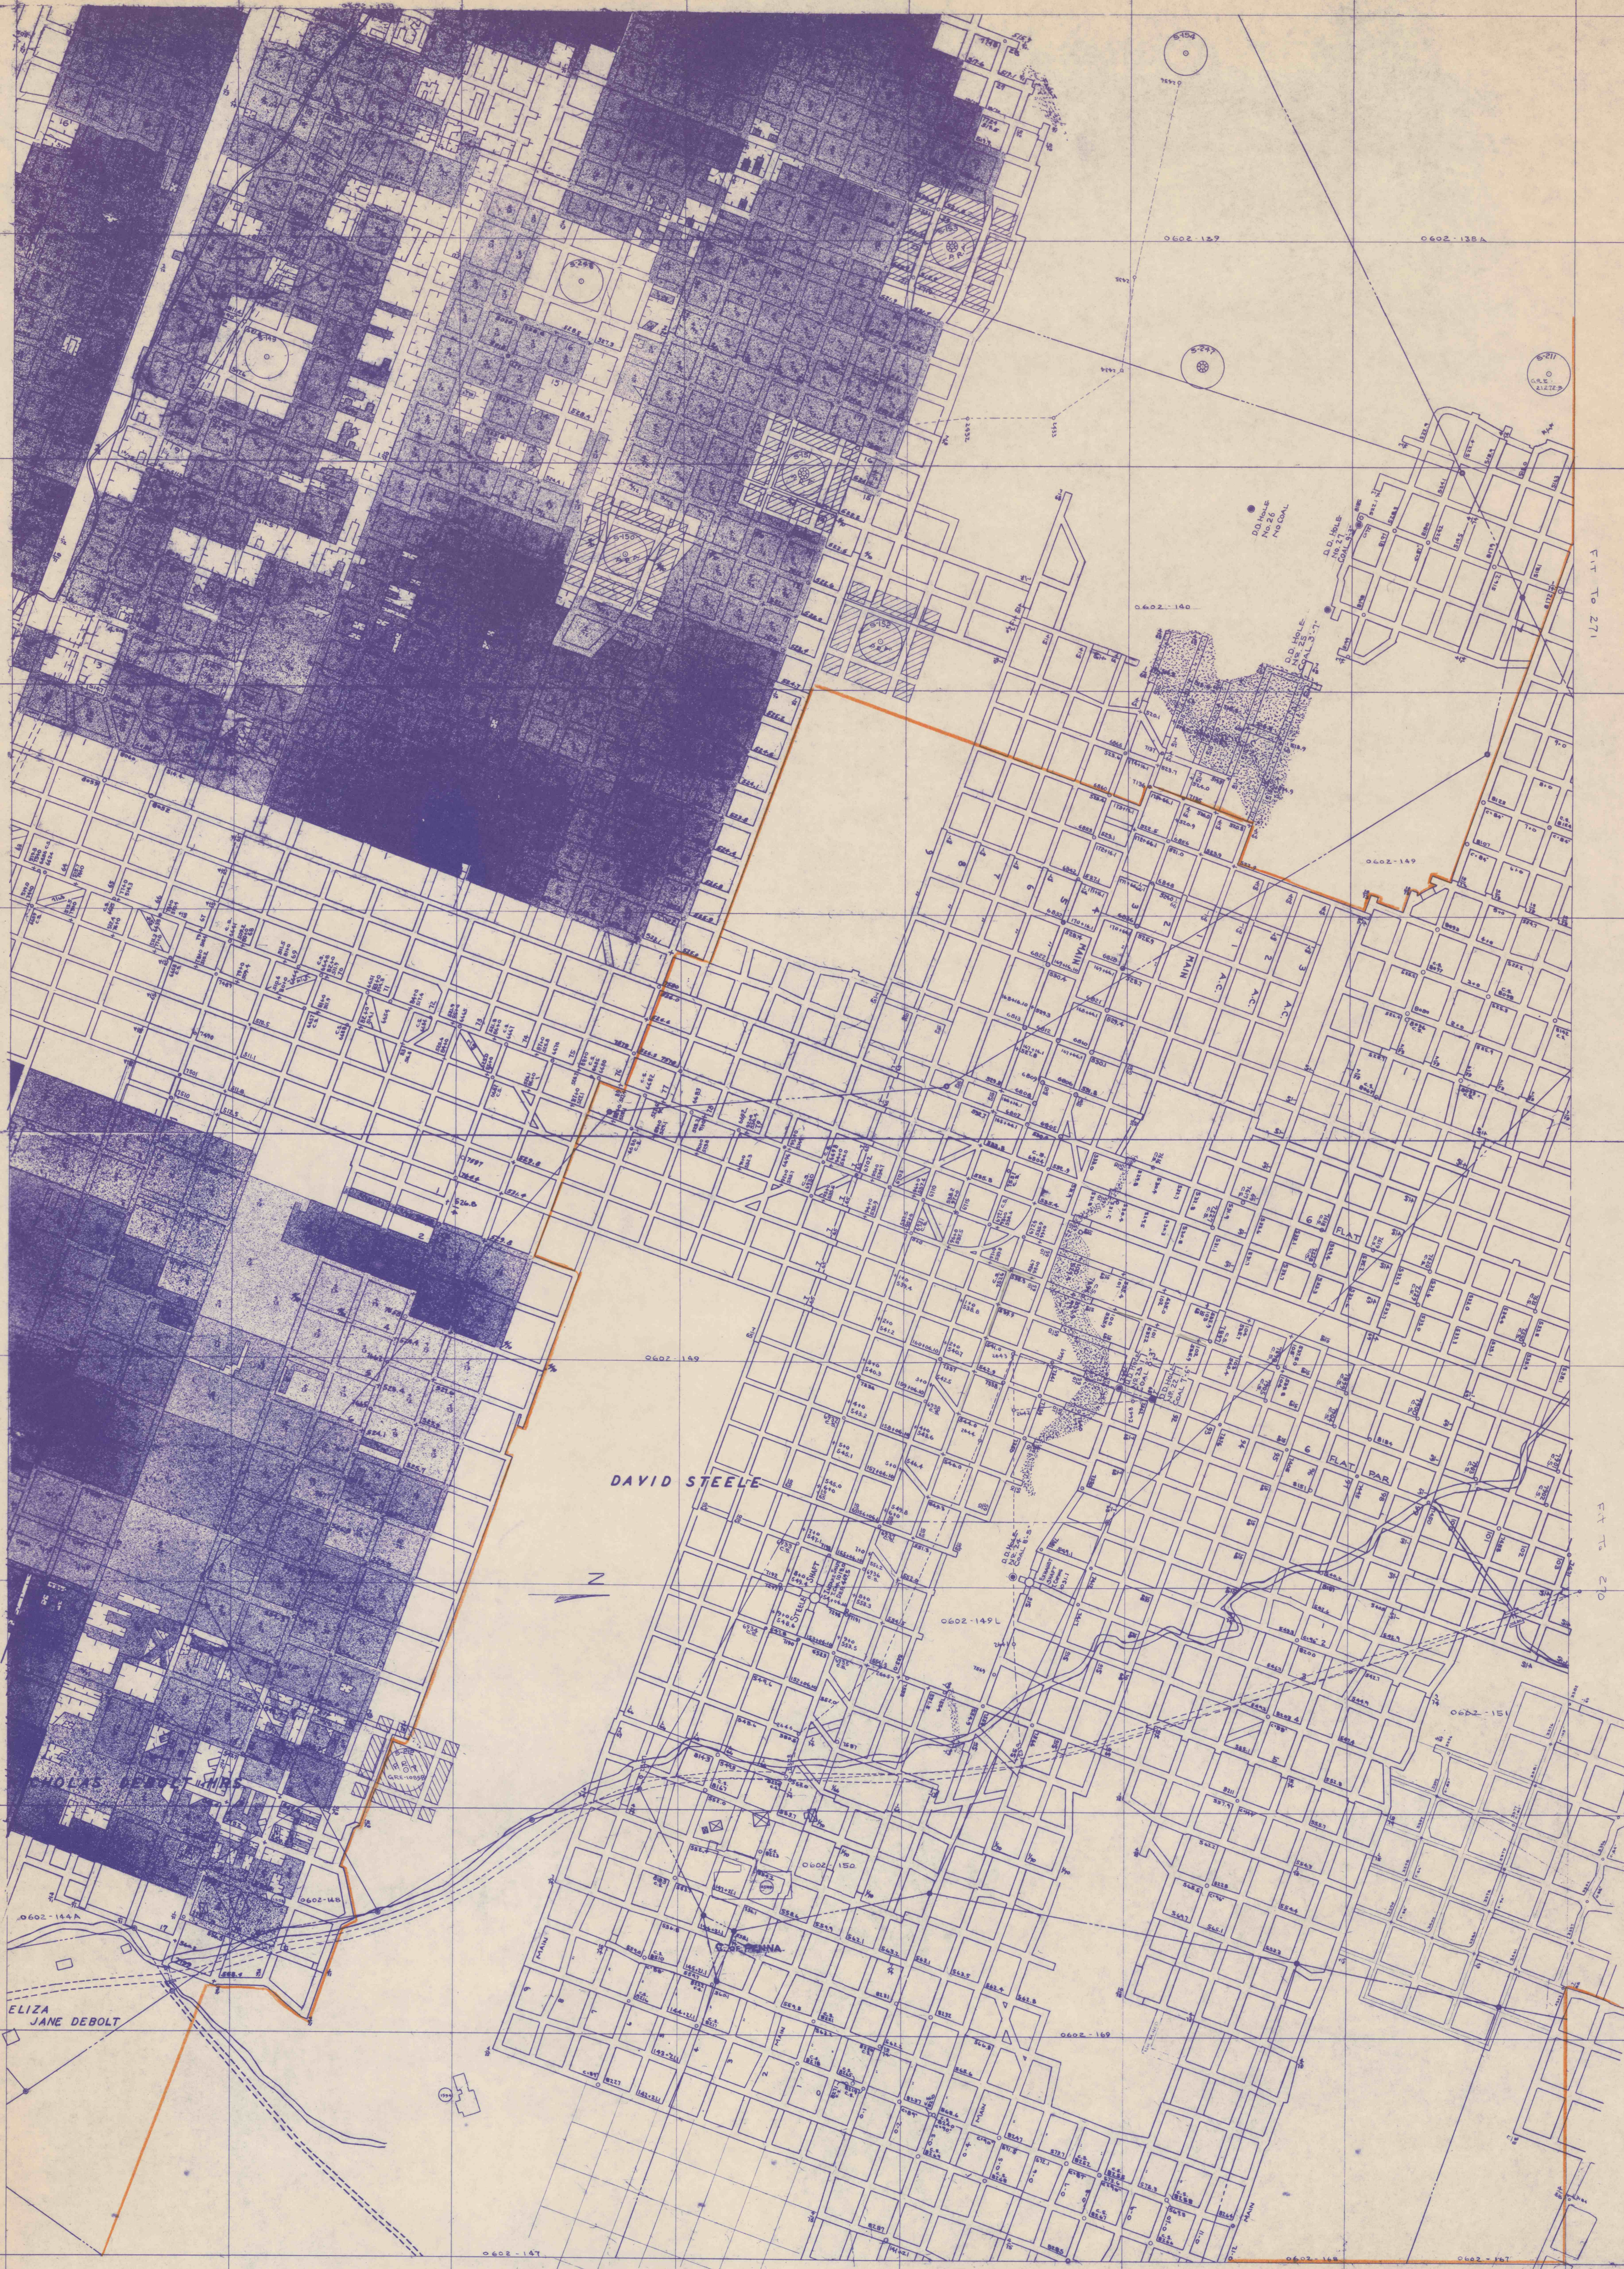

DAVID STEELE

ELIZA JANE DEBOLT

HOLAS BERT

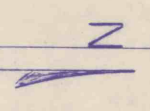

FT. TO 266

SEC. 12 - SHAN
NR. 268

FT. TO 271

FT. TO 270

000317 N

000318 N

000319 N

000320 N