


WEST VIRGINIA  
MARSHALL COUNTY

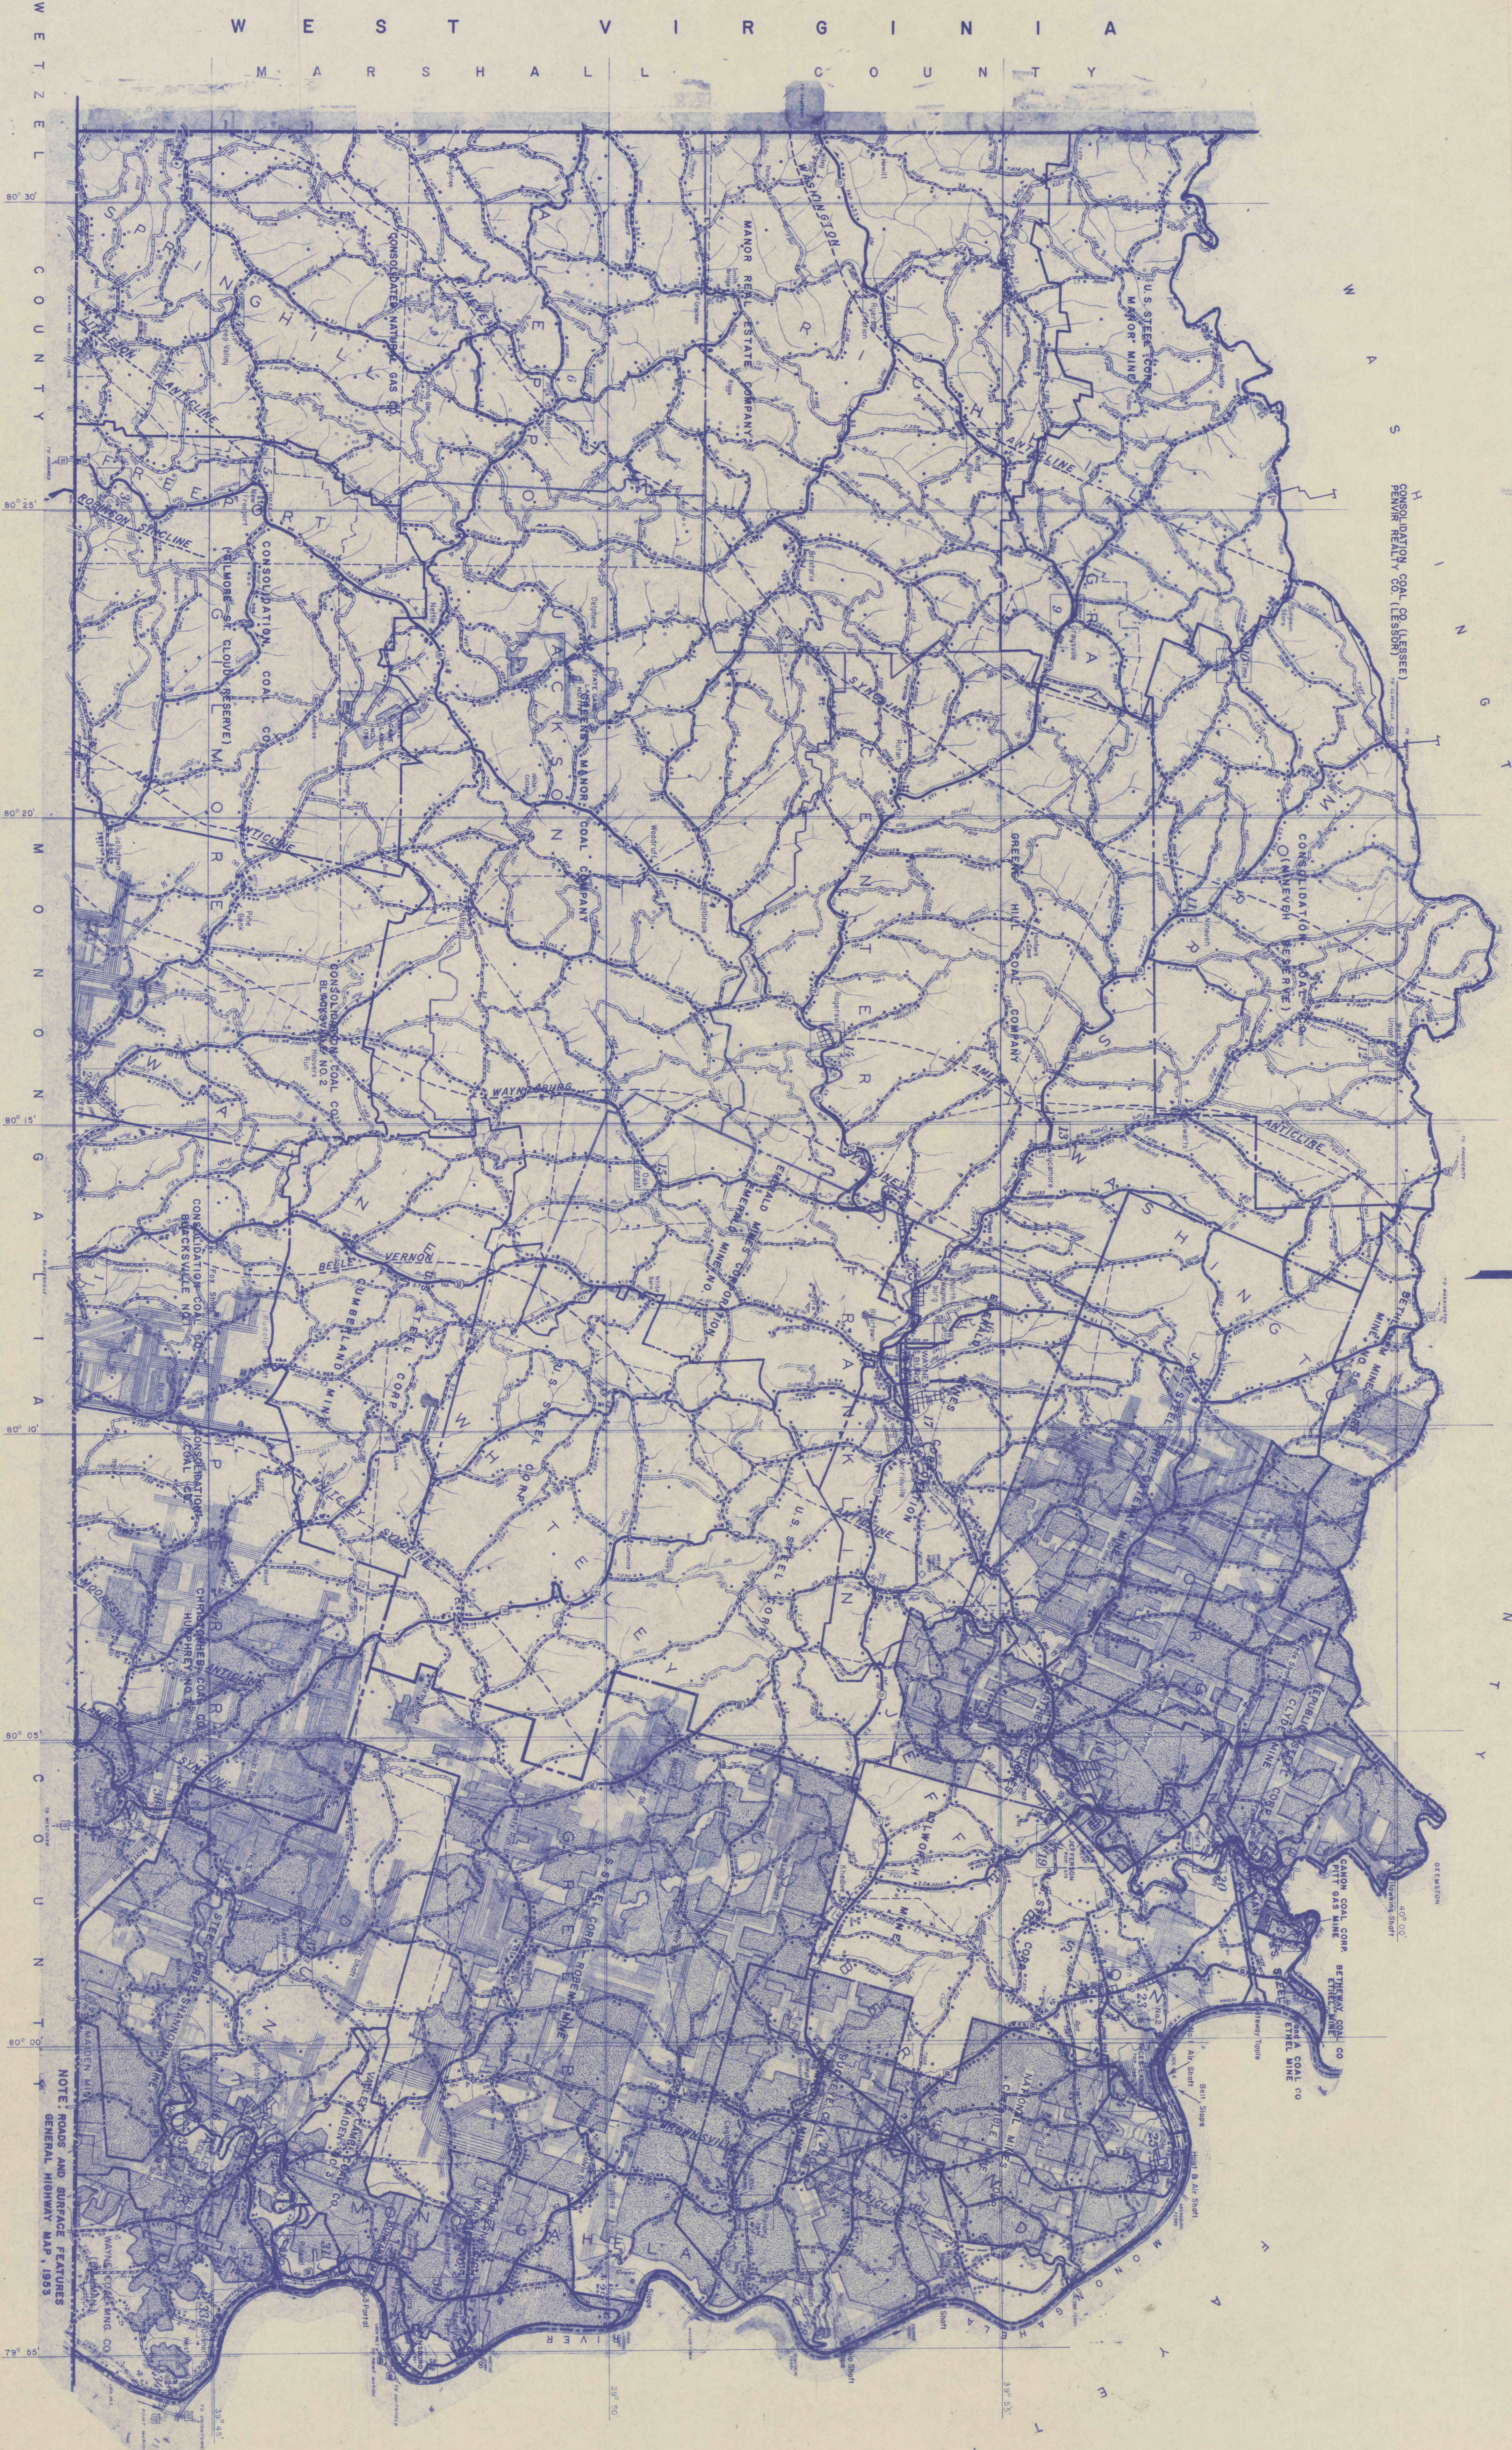

COMMONWEALTH OF PENNSYLVANIA  
DEPARTMENT OF ENVIRONMENTAL RESOURCES  
BUREAU OF LAND PROTECTION  
DIVISION OF MINE SUBSIDENCE REGULATION  
MINE OF  
GREENE COUNTY, PA.

JANUARY-1970



MINING COMPLETED AREAS  
PITTSBURGH COAL SEAM  
SEEDED MARCH 1970

