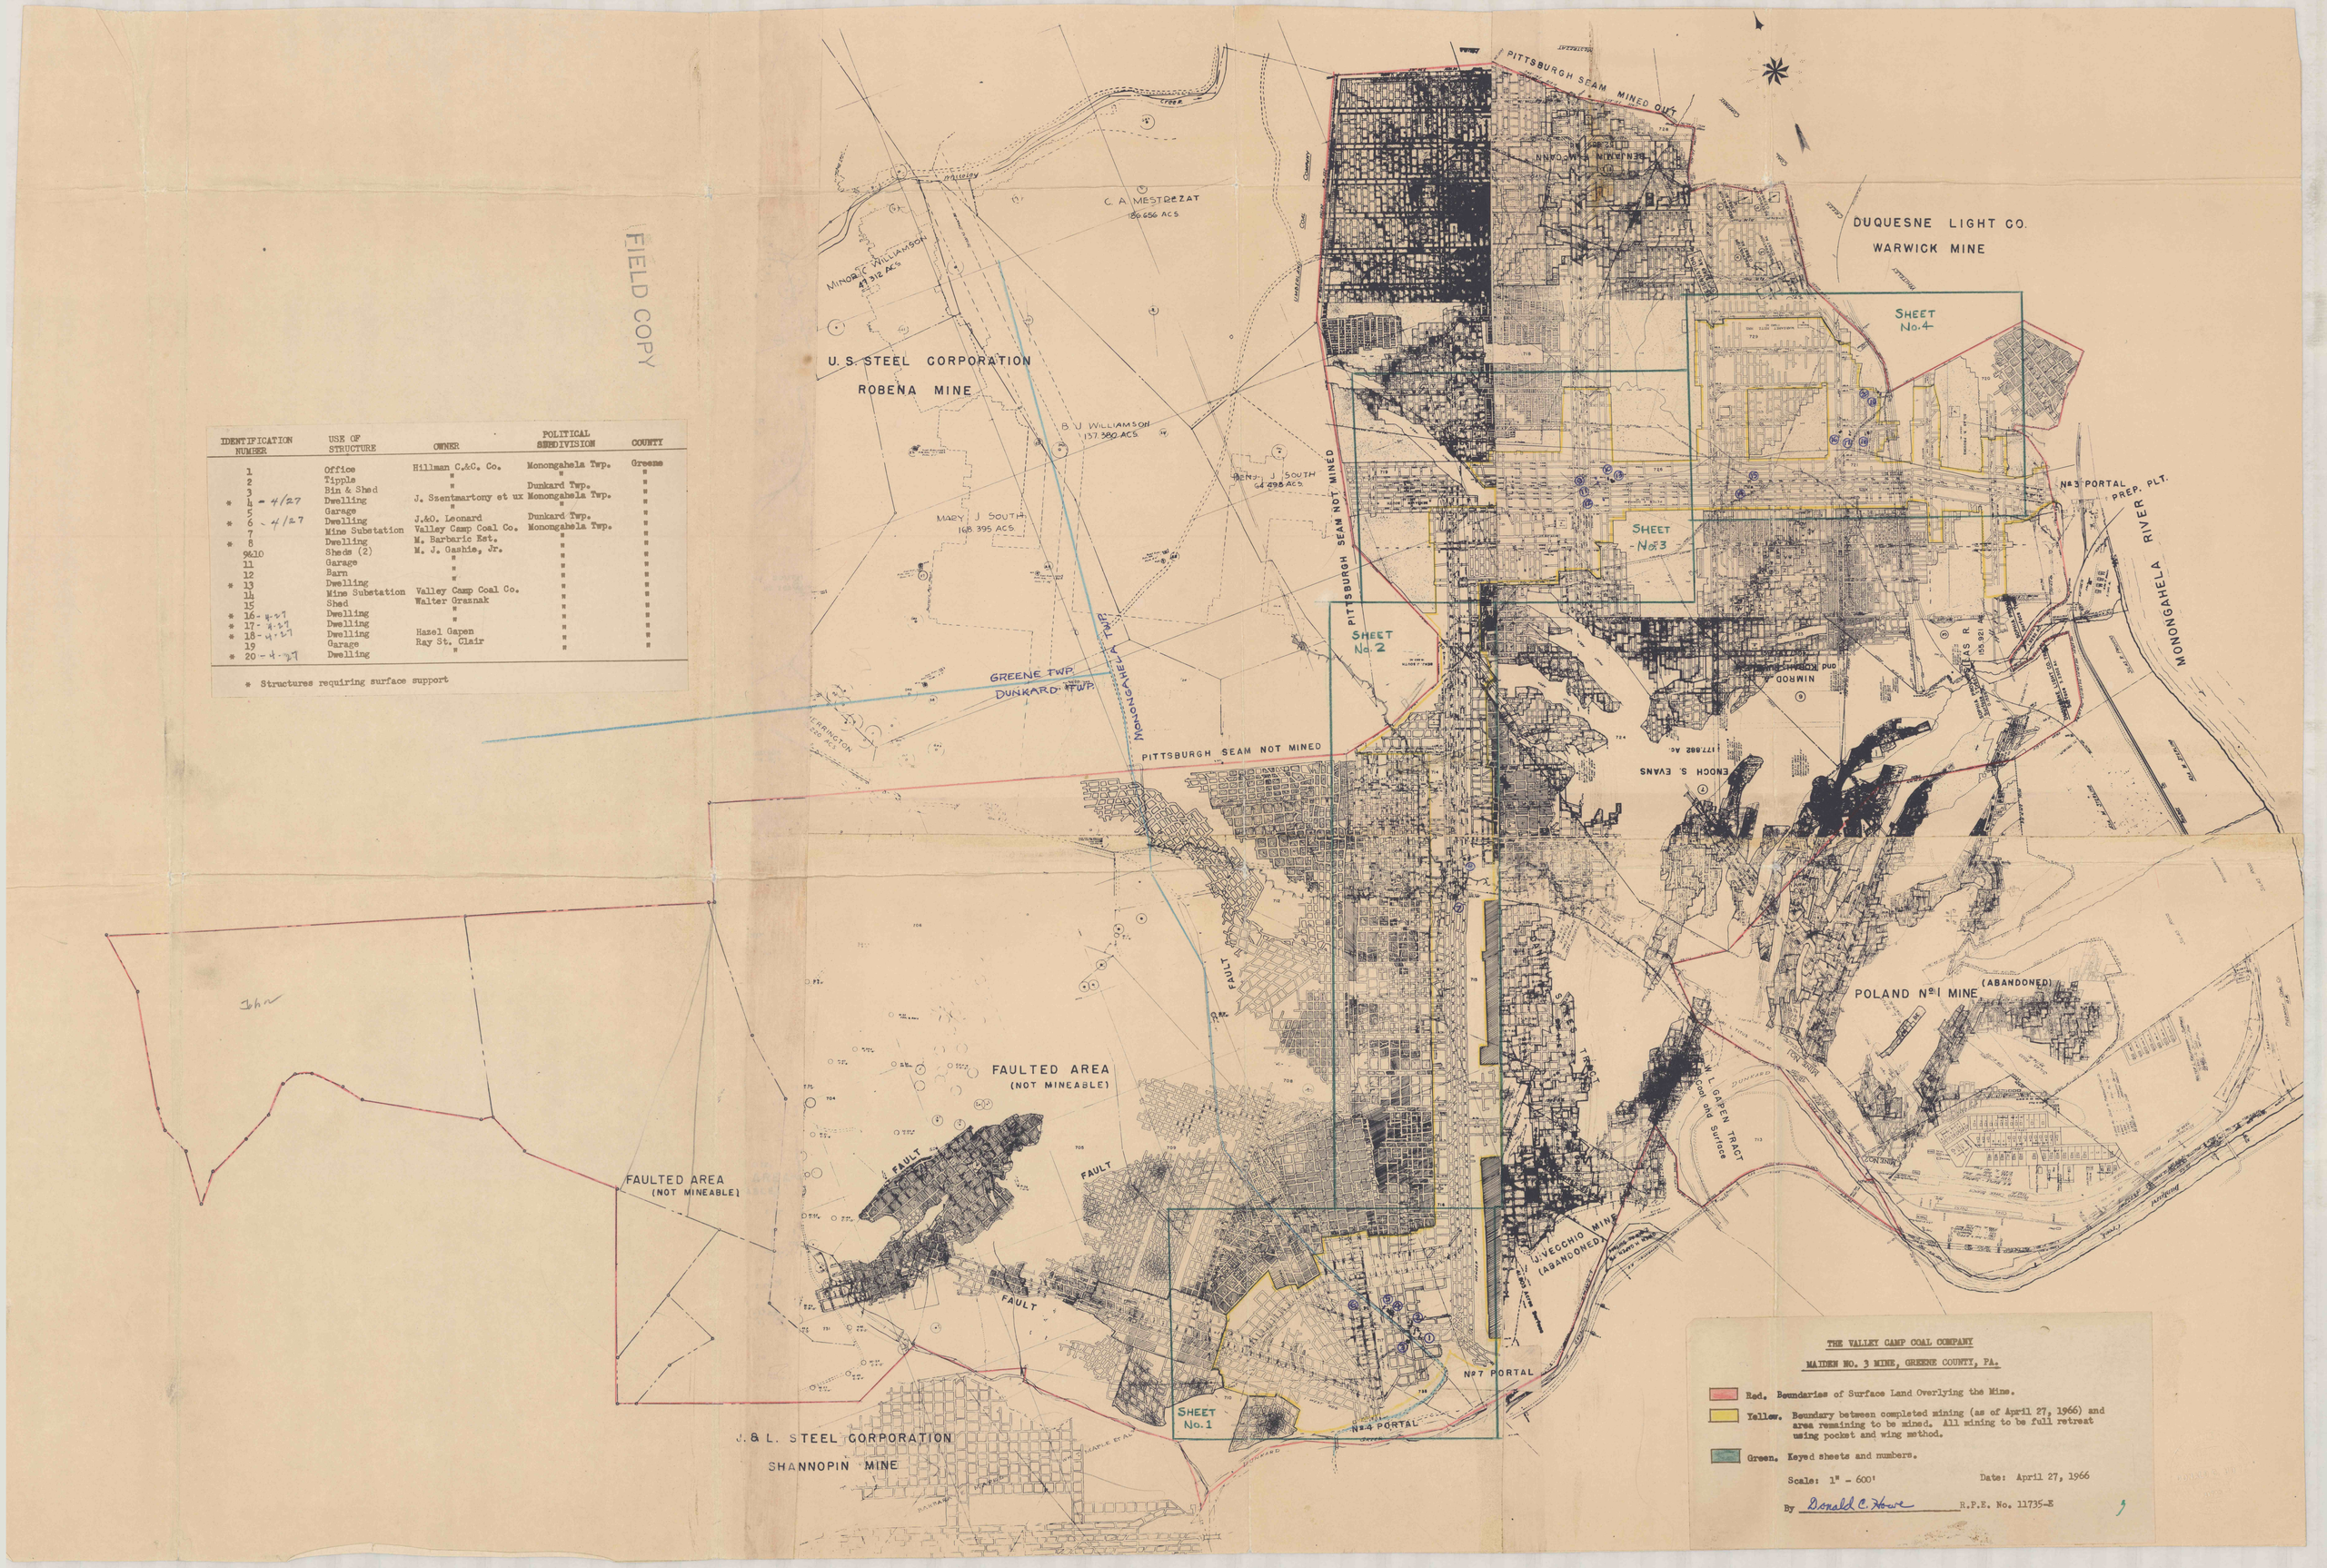

IDENTIFICATION NUMBER	USE OF STRUCTURE	OWNER	POLITICAL SUBDIVISION	COUNTY
1	Office	Hillman C.&C. Co.	Monongahela Twp.	Greene
2	Tipple	"	"	"
3	Bin & Shed	"	Dunkard Twp.	"
* 4 - 4/27	Dwelling	J. Szentmartony et ux	Monongahela Twp.	"
5	Garage	"	"	"
* 6 - 4/27	Dwelling	J.&O. Leonard	Dunkard Twp.	"
7	Mine Substation	Valley Camp Coal Co.	Monongahela Twp.	"
* 8	Dwelling	M. Barbaric Est.	"	"
9&10	Sheds (2)	M. J. Gashie, Jr.	"	"
11	Garage	"	"	"
12	Barn	"	"	"
* 13	Dwelling	"	"	"
14	Mine Substation	Valley Camp Coal Co.	"	"
15	Shed	Walter Graznak	"	"
* 16 - 4-27	Dwelling	"	"	"
* 17 - 4-27	Dwelling	"	"	"
* 18 - 4-27	Dwelling	Hazel Gapen	"	"
19	Garage	Ray St. Clair	"	"
* 20 - 4-27	Dwelling	"	"	"

* Structures requiring surface support

THE VALLEY CAMP COAL COMPANY

MAIDEN NO. 3 MINE, GREENE COUNTY, PA.

Red. Boundaries of Surface Land Overlying the Mine.

Yellow. Boundary between completed mining (as of April 27, 1966) and area remaining to be mined. All mining to be full retreat using pocket and wing method.

Green. Keyed sheets and numbers.

Scale: 1" - 600'

Date: April 27, 1966

By Donald C. Howe R.P.E. No. 11735-E