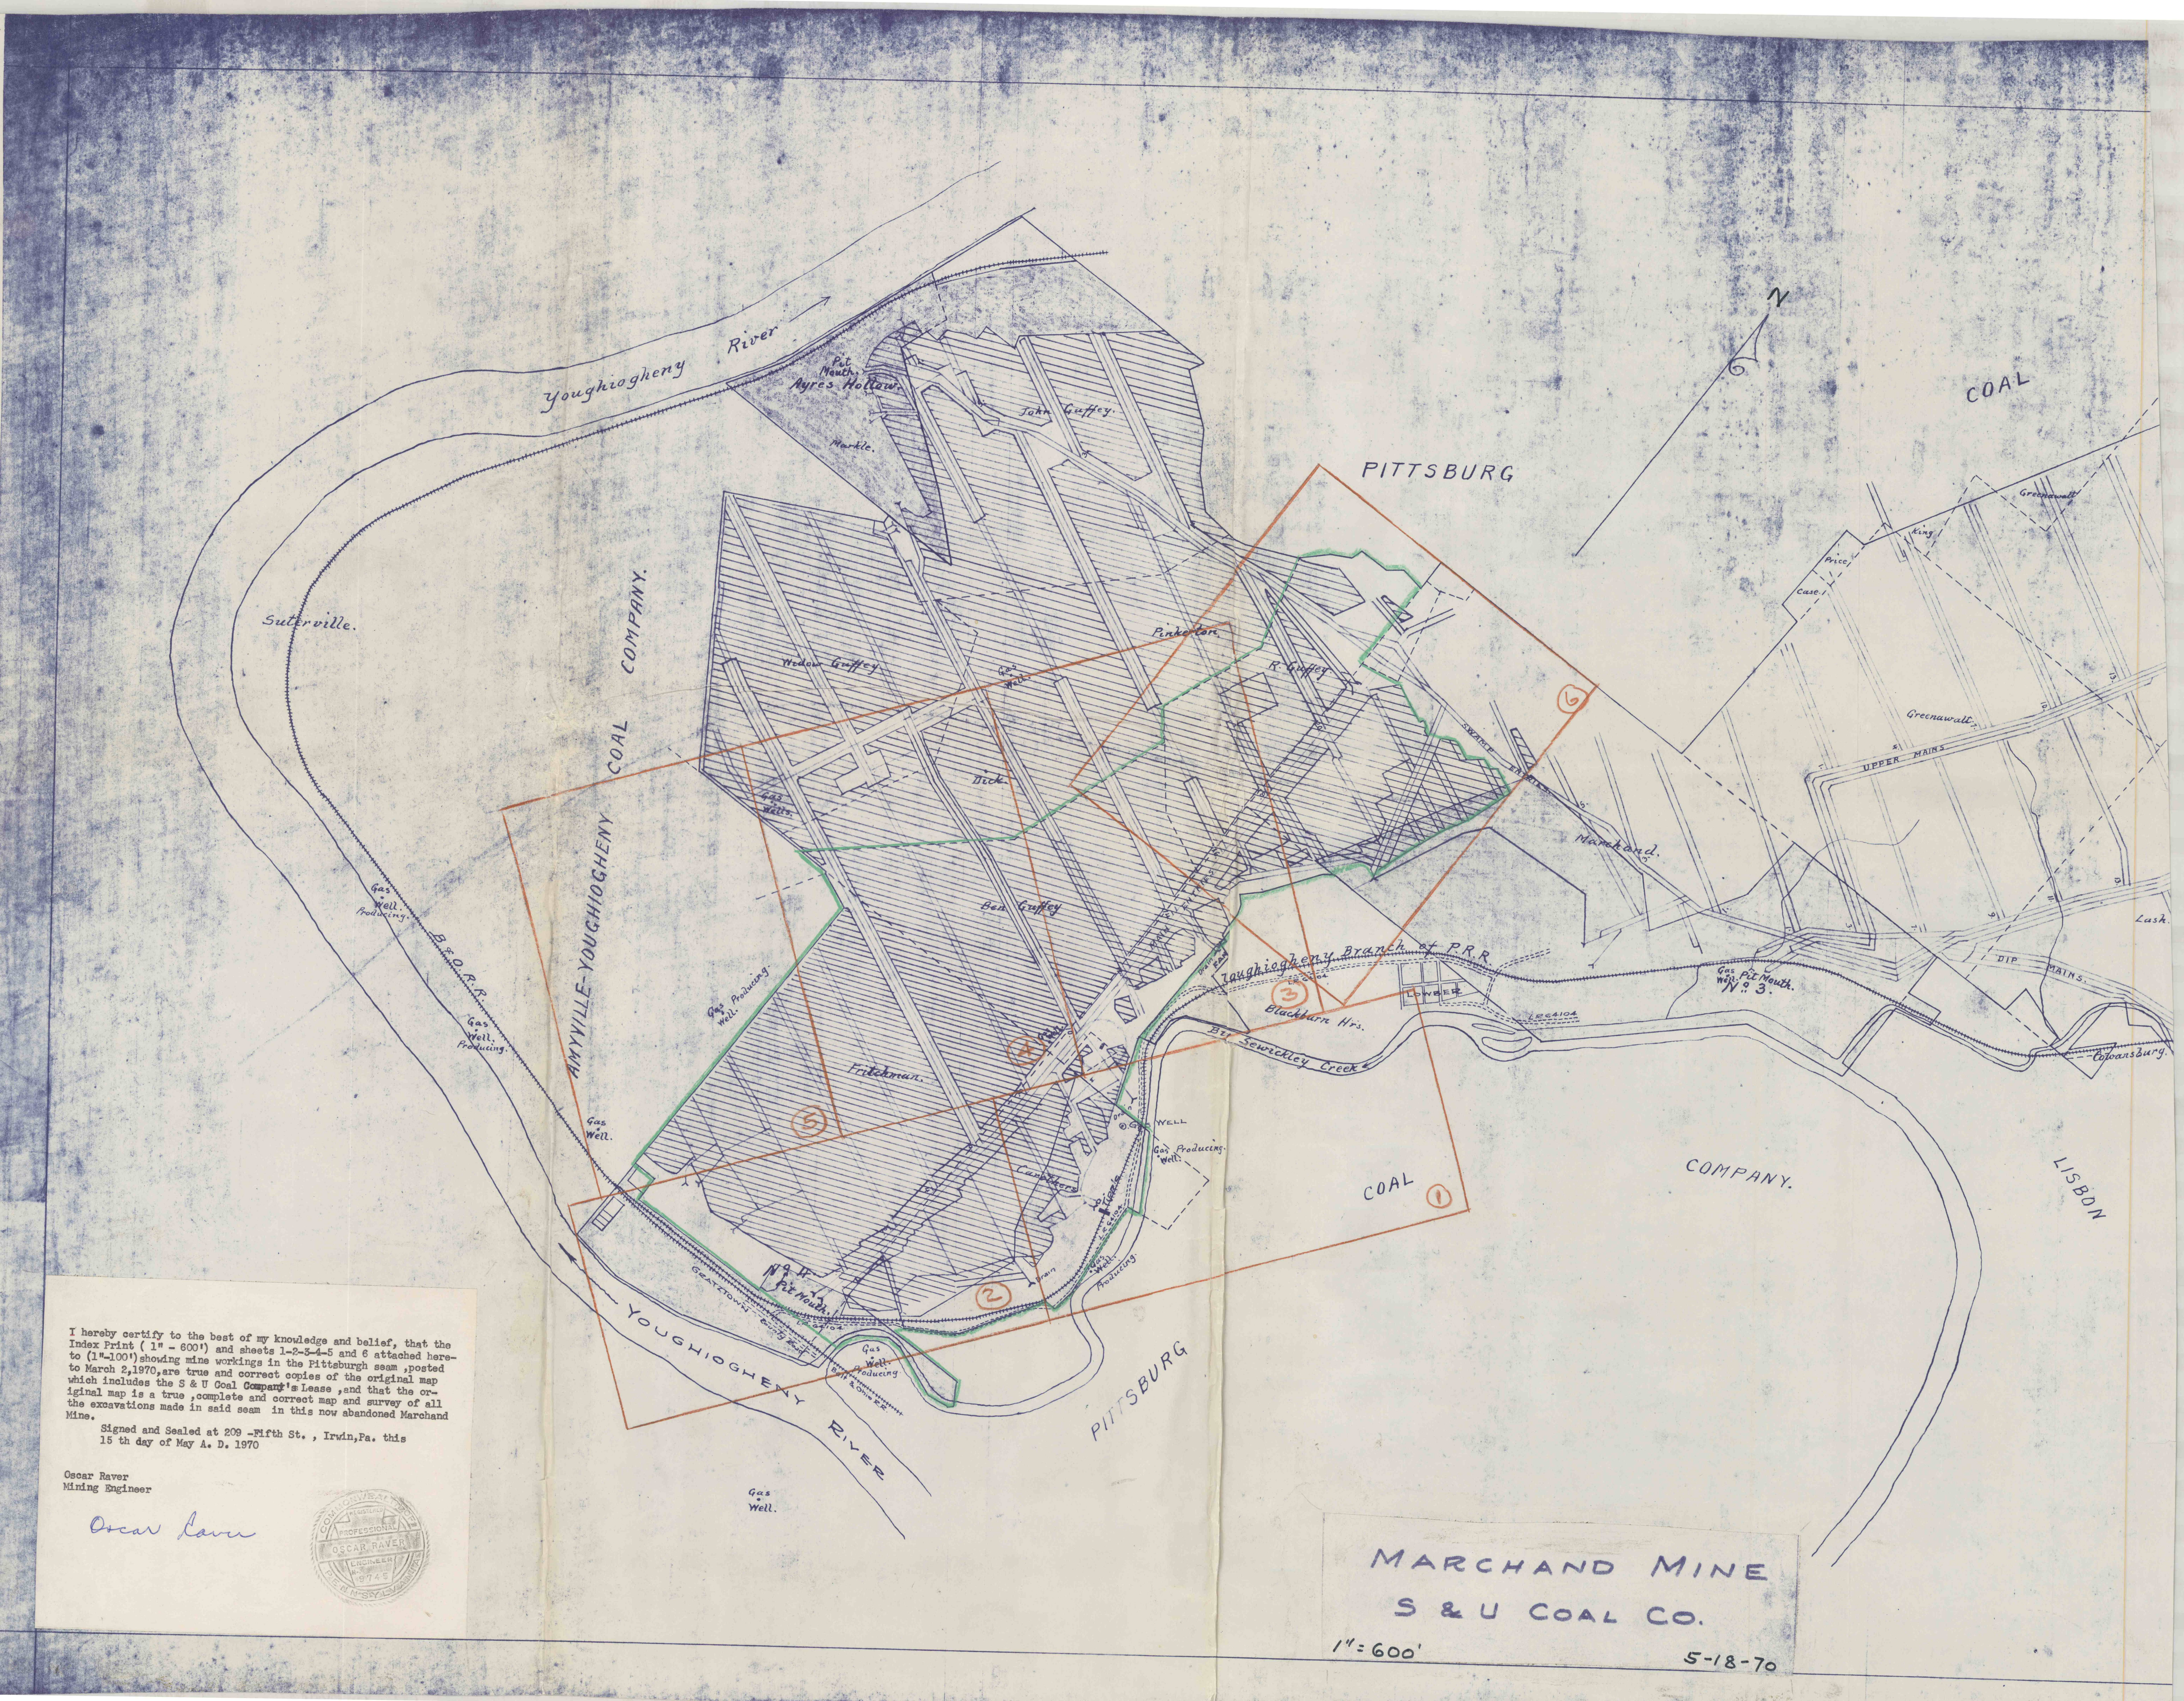

I hereby certify to the best of my knowledge and belief, that the Index Print (1" - 600') and sheets 1-2-3-4-5 and 6 attached hereto (1"-100') showing mine workings in the Pittsburgh seam ,posted to March 2,1970,are true and correct copies of the original map which includes the S & U Coal Company's Lease ,and that the original map is a true ,complete and correct map and survey of all the excavations made in said seam in this now abandoned Marchand Mine.

Signed and Sealed at 209 -Fifth St. , Irwin,Pa. this 15 th day of May A. D. 1970

Oscar Raver
Mining Engineer

Oscar Raver

No. 9745

MARCHAND MINE
S & U COAL CO.

1"=600'

5-18-70