


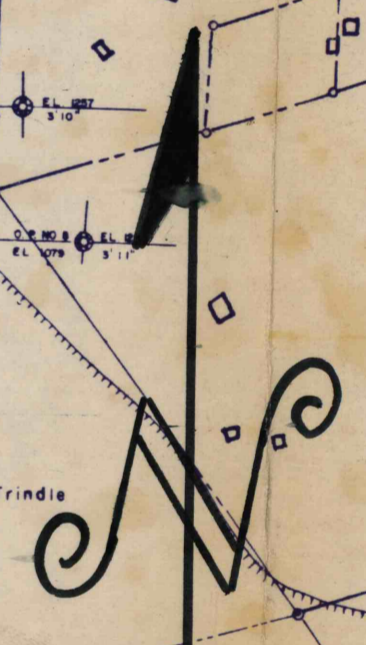

KISKIMINETAS COAL COMPANY
MINED OUT AREA



LEGEND

- MINING OPERATIONS COMPLETED AS OF APRIL 27, 1966
- SURFACE STRUCTURES
- PRESENTLY ASSIGNED ACREAGE

THE FLORENCE MINING CO.
SEWARD, PA.
— RICHARD'S RUN MINE
DATE: 10-11-66 SCALE: 1" = 600'
EAST & WEST & WHEATFIELD TWP.
INDIANA CO.

114-555
114-500