


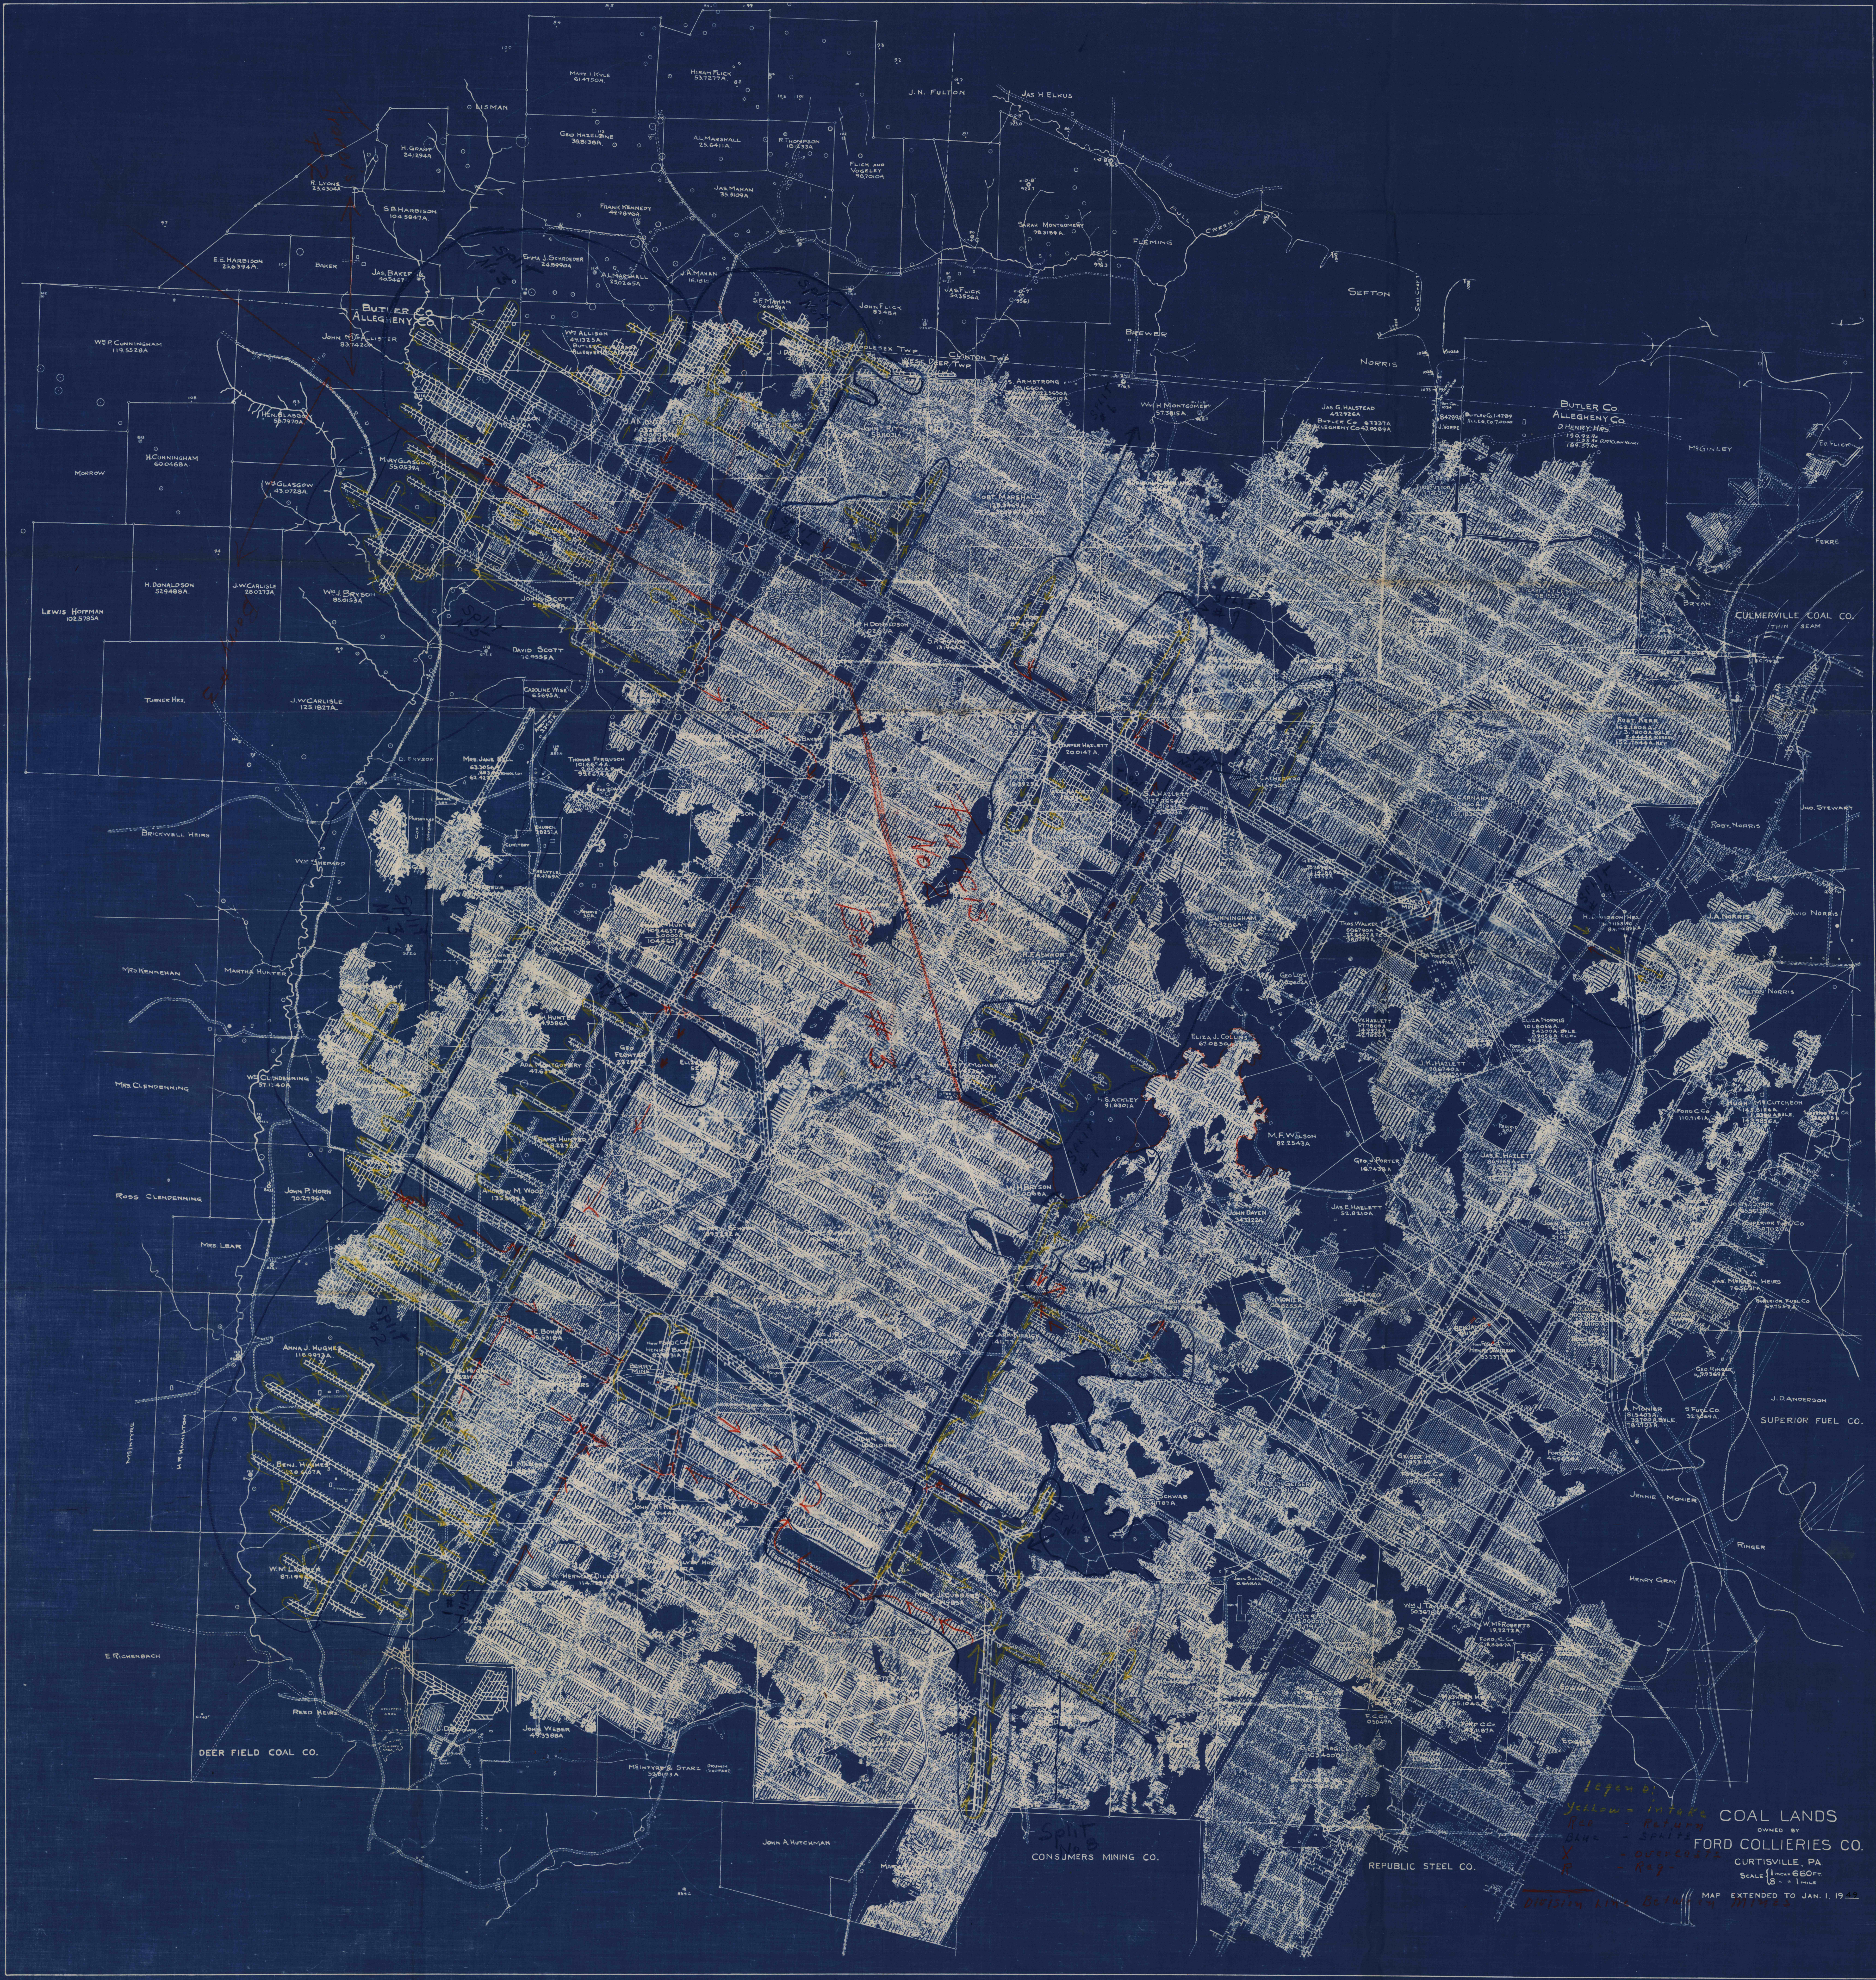

Legend:
Yellow - Intake
Red - Return
Blue - Spill

COAL LANDS
OWNED BY
FORD COLLIERIES CO.
CURTISVILLE, PA.
MAP EXTENDED TO JAN. 1, 1922