


Approximate crop line of Mercer Clay

N. Am. Ref. Co. STRIPPING

Mag. Declin. 6° 16' W

JWB N71°E  
LHFB

62 5' Wod.

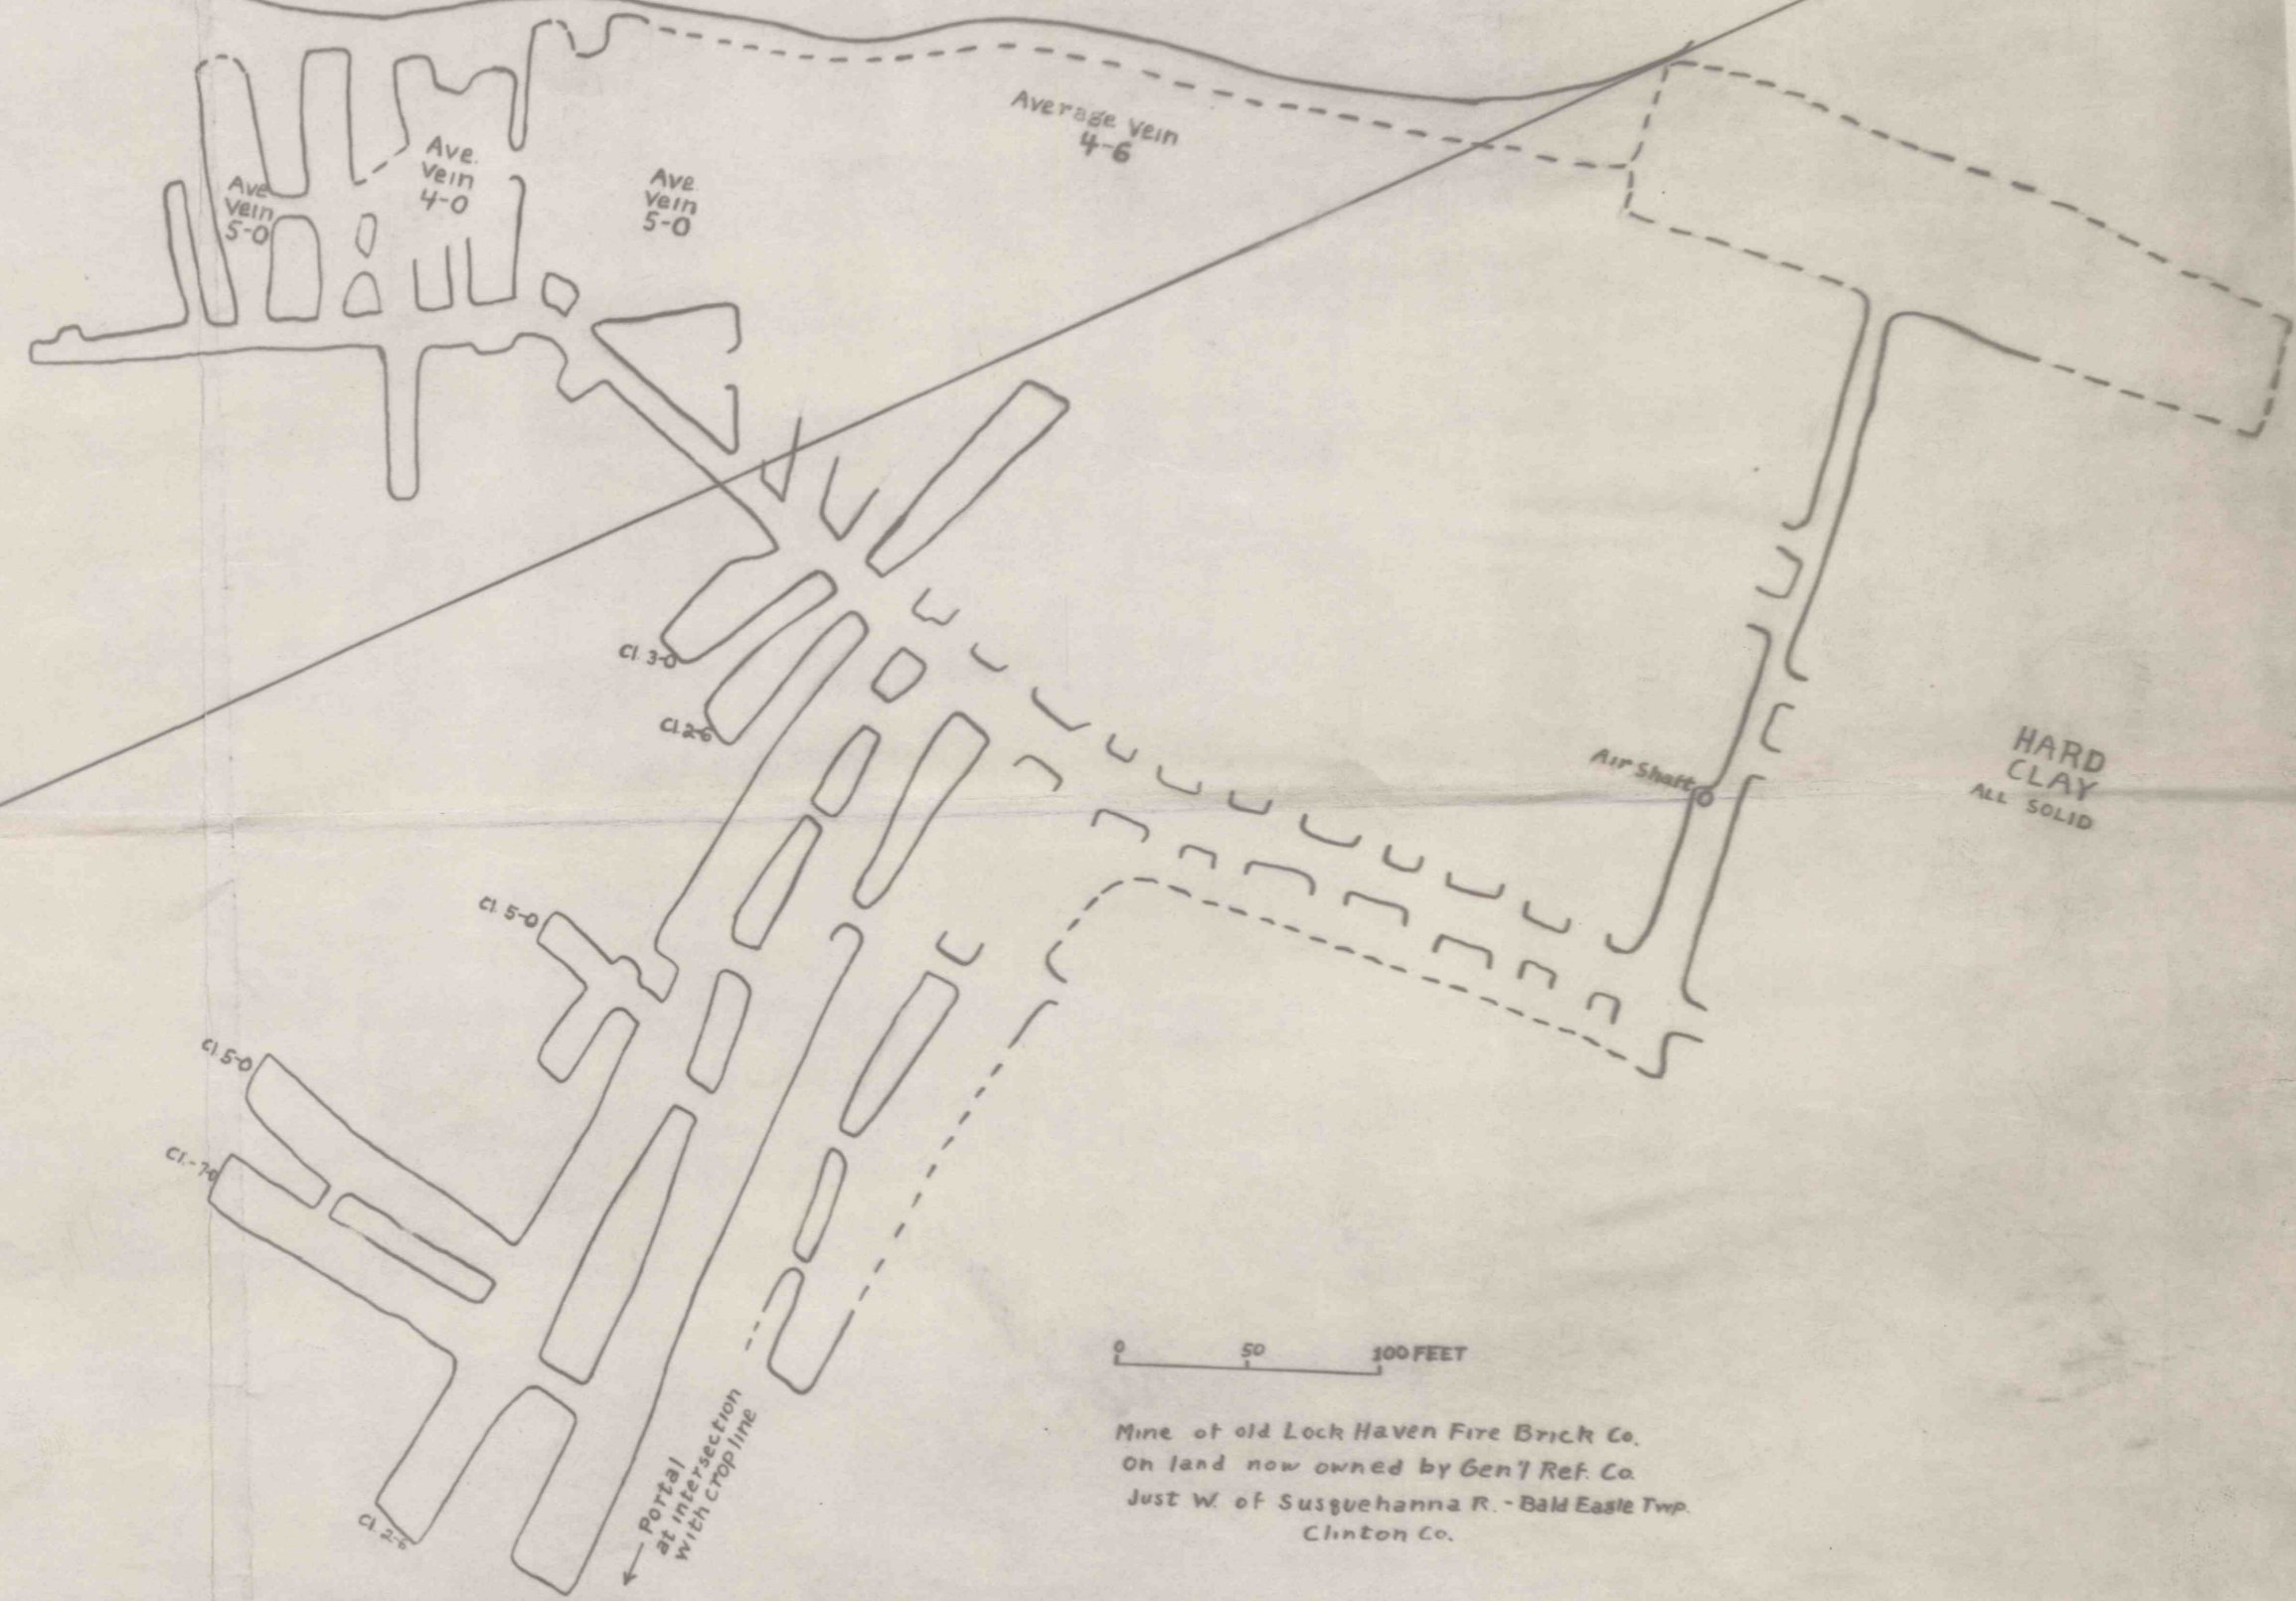

HARD CLAY ALL SOLID

0 50 100 FEET

Mine of old Lock Haven Fire Brick Co.  
On land now owned by Gen'l Ref. Co.  
Just W of Susquehanna R. - Bald Eagle Twp.  
Clinton Co.