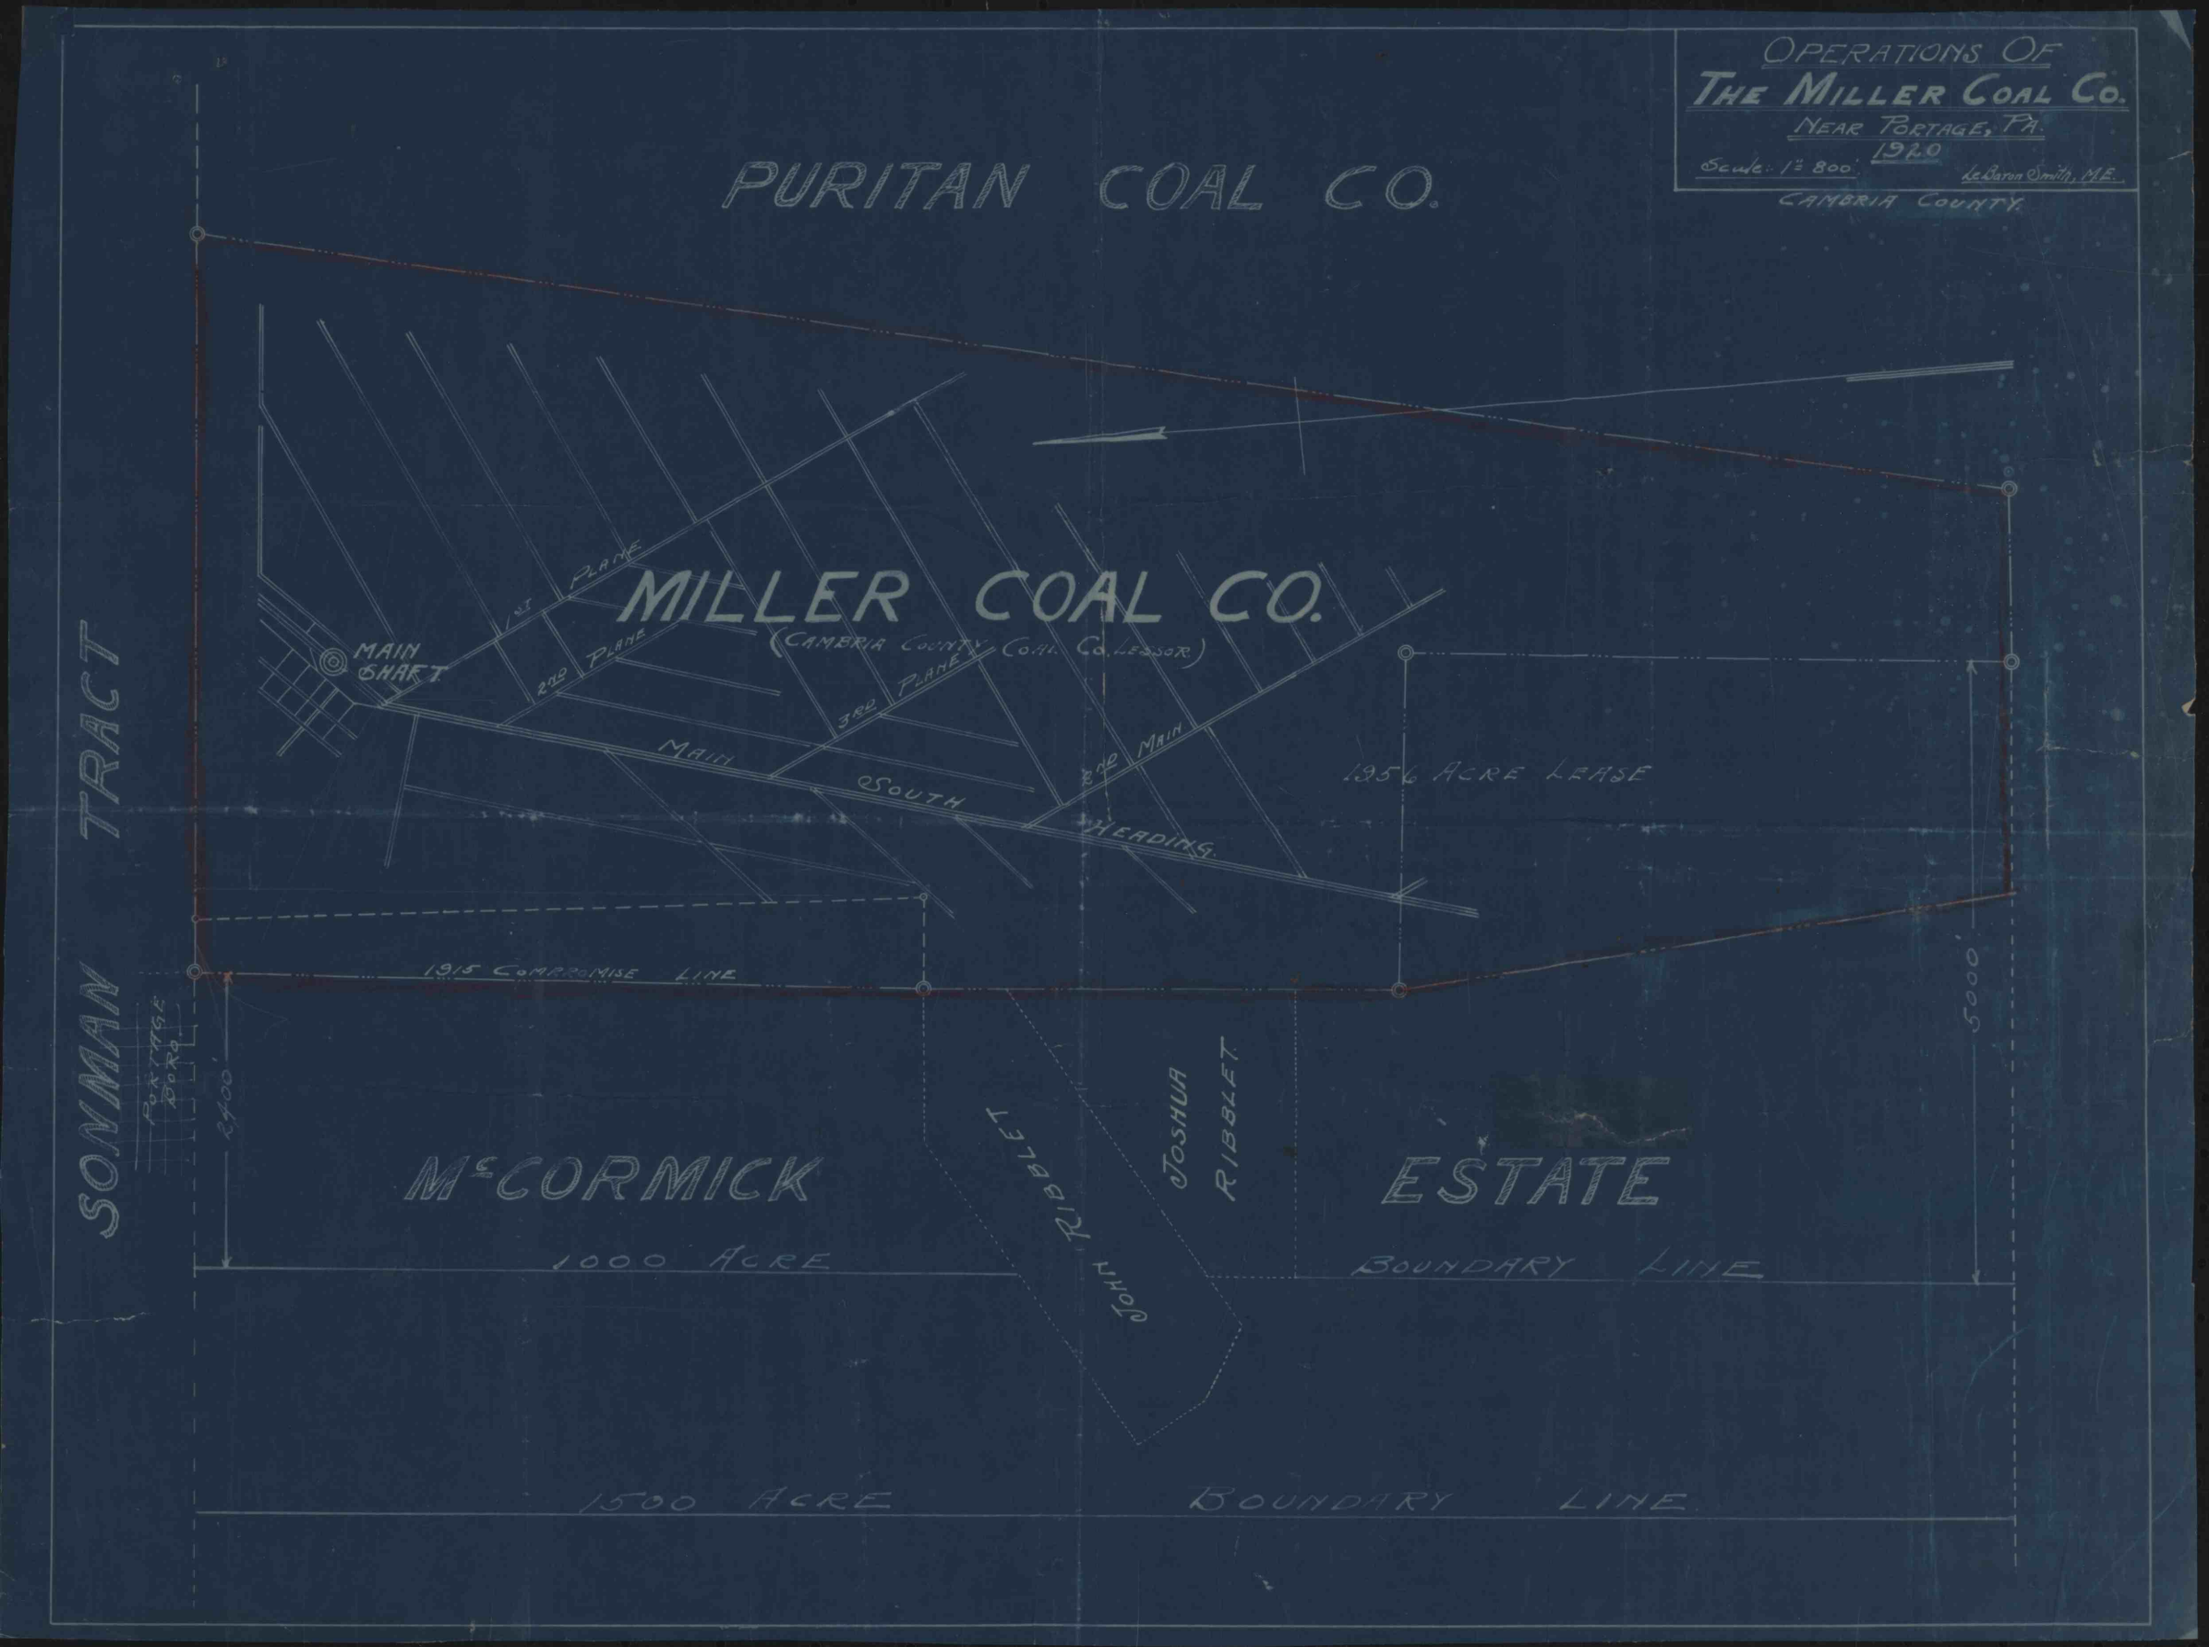
OPERATIONS OF
THE MILLER COAL CO.
NEAR PORTAGE, PA.
1920
Scale: 1" = 800'
LeBaron Smith, M.E.
CAMBRIA COUNTY.
PURITAN COAL CO.
MILLER COAL CO.
(CAMBRIA COUNTY COAL CO. LESSOR)
MAIN SHAFT
1ST PLANE
2ND PLANE
3RD PLANE
MAIN SOUTH
2ND MAIN
HEADINGS
1954 ACRE LEASE
1915 COMPROMISE LINE
SOMMAN TRACT
PORTAGE ROAD
2400'
5000'
McCORMICK
1000 ACRE
JOHN RIBBLET
JOSHUA RIBBLET
ESTATE
BOUNDARY LINE
1500 ACRE
BOUNDARY LINE