

RECEIVED
MAY 26 1988
GBG - D.S.R.

RECEIVED
MAY 26 1988
GBG - D.S.R.

NEMACOLIN MINE


POOL ELEVATIONS - MAY 5, 1988
PROPERTY MAP SHOWING
MINE WORK
AS OF - 19 -
Scale - 1" = 800'
MAP No. 2

DWG. NO. 65046



H. Lovell Hinkle
5/14/88

MAP No. 2

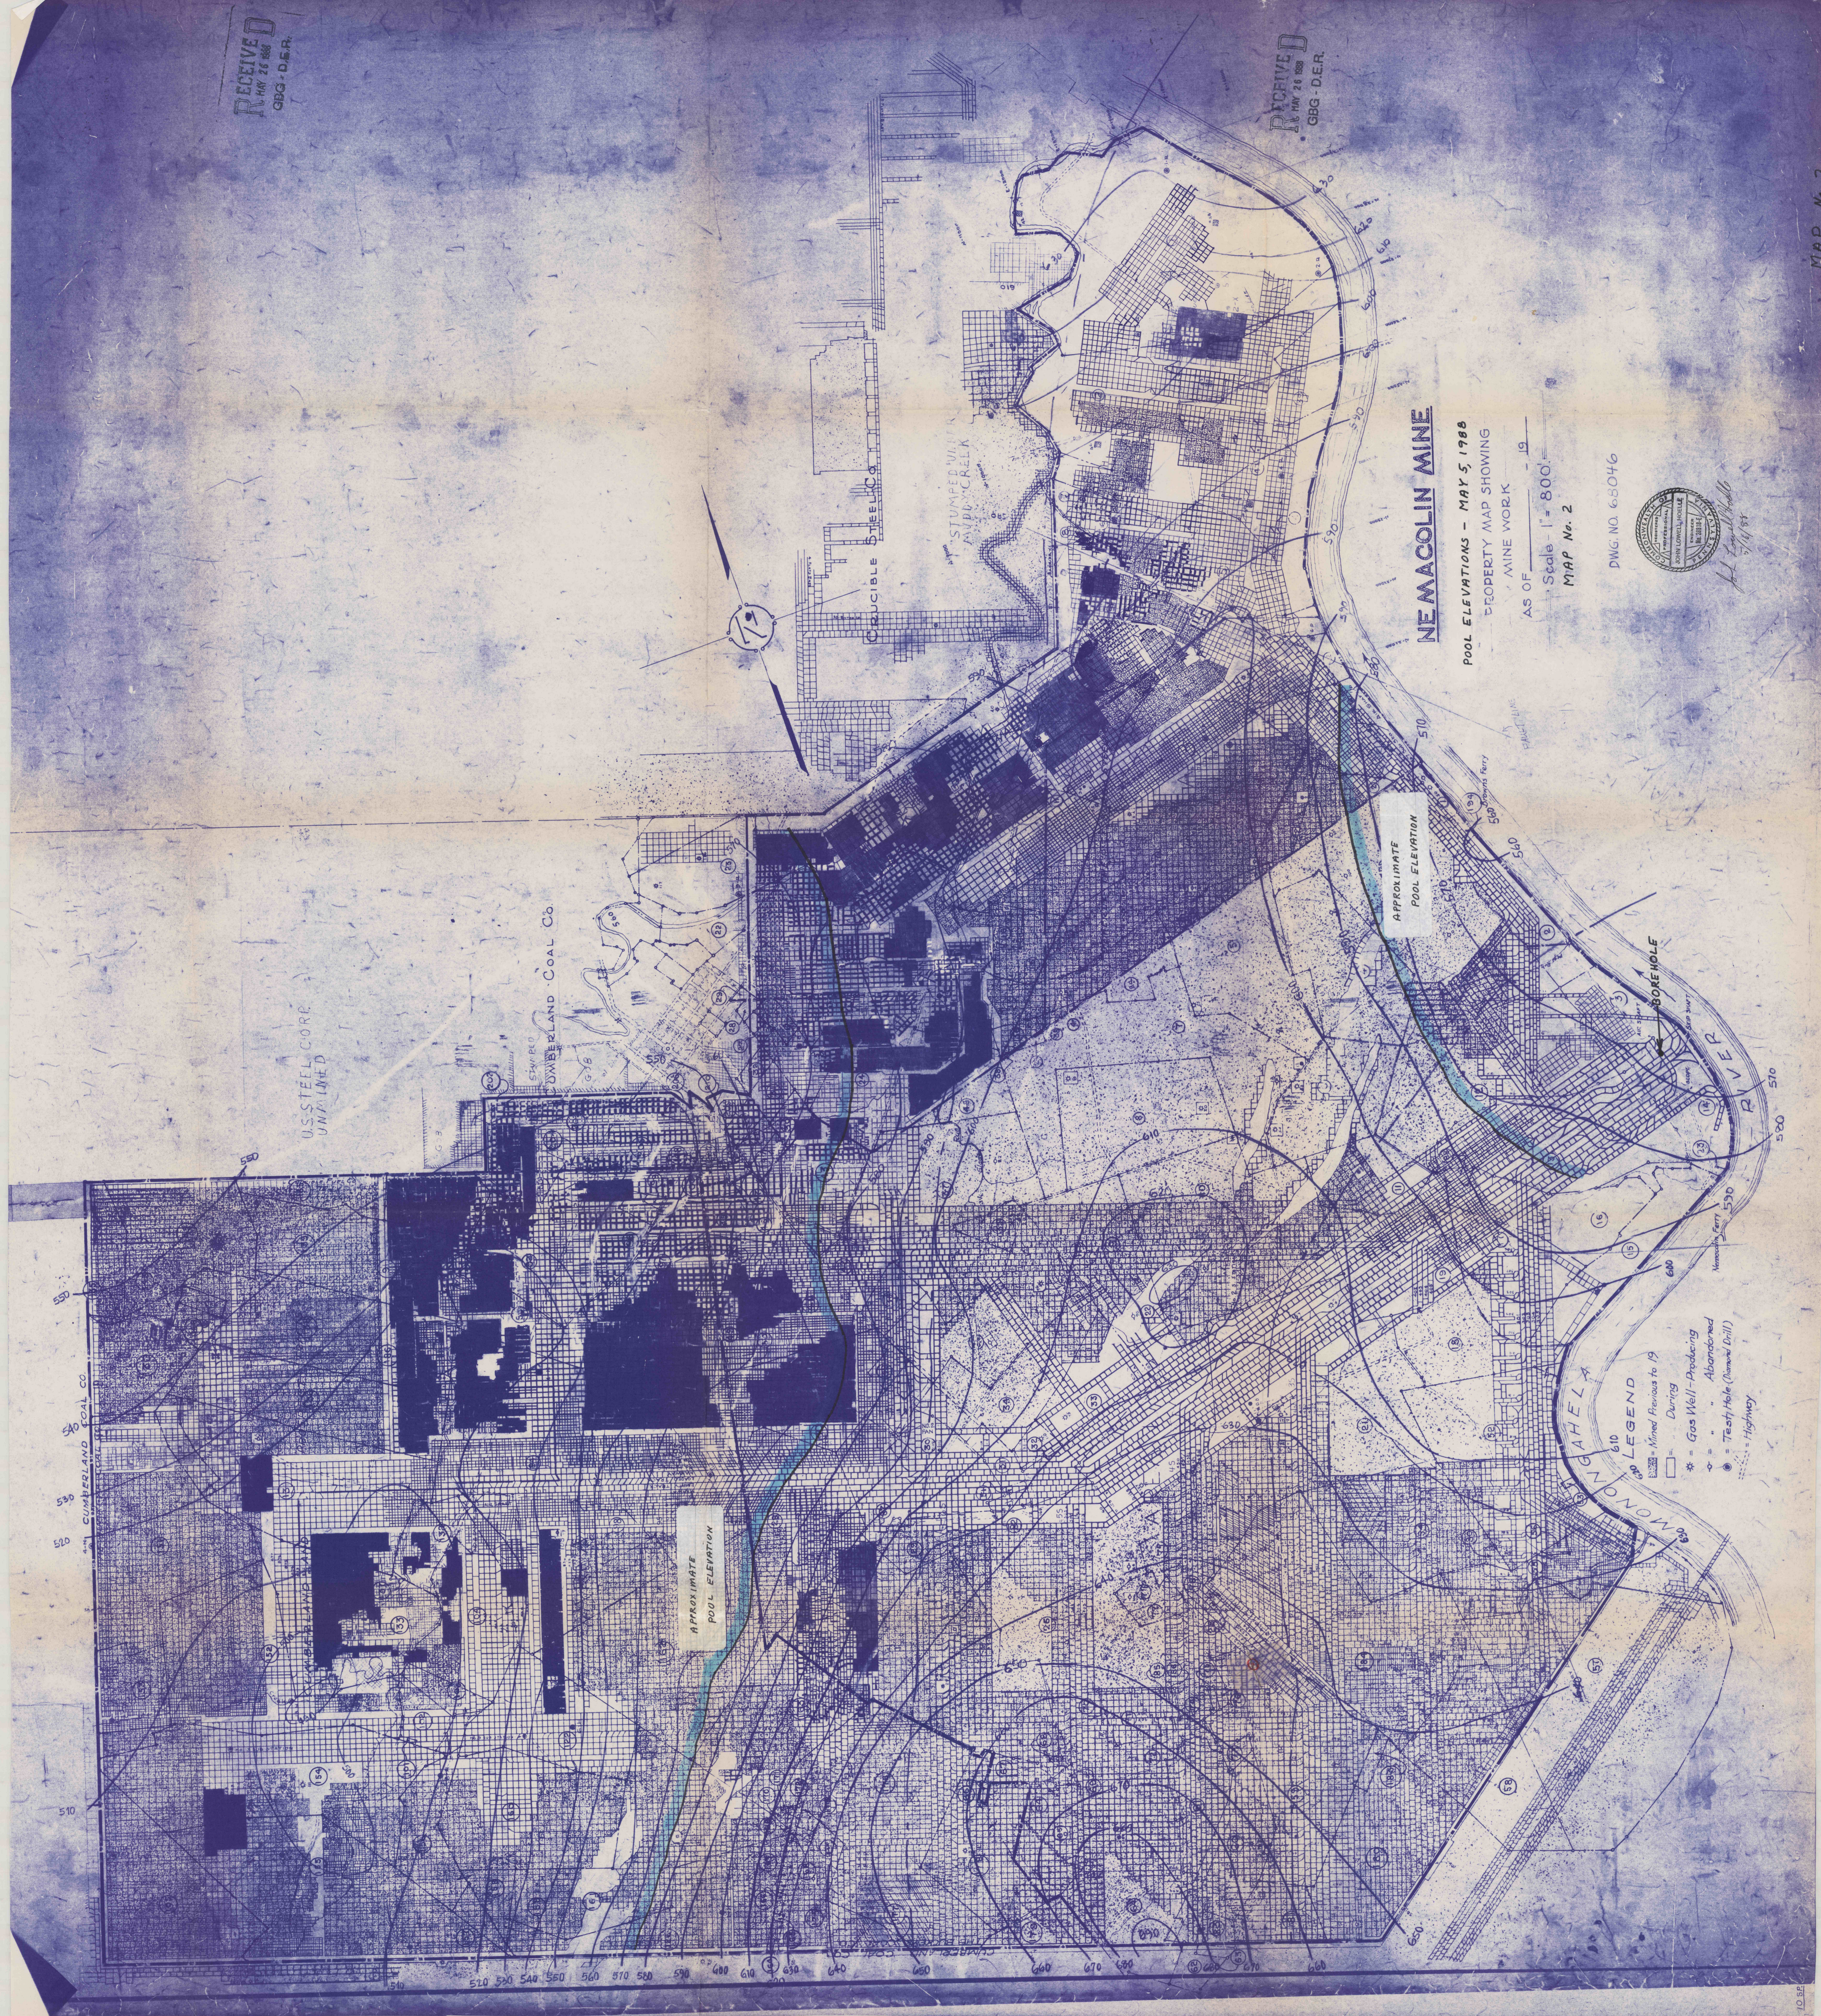

U.S. STEEL CORP.
UNMINED

CUMBERLAND COAL CO.

APPROXIMATE
POOL ELEVATION

APPROXIMATE
POOL ELEVATION

LEGEND
Mined Previous to 19
During
* = Gas Well - Producing
Abandoned
Test Hole (Diamond Drill)
Highway