


DRILL HOLES (B.C. - BOTTOM OF COAL)

No.	SURFACE ELEVATION	UPPER FREEPORT COAL ELEVATION	UPPER FREEPORT COAL THICKNESS
WATSON No. 1	1075.01	838.51	3'9"
" 2	837.09	823.09	"
" 3	1191.49	975.49	"
3 & SALTSBURG B.C. 1402.	1206.55	1206.55	2'9"
4 "	1213.64	1212.89	4'2"
5 "	1237.73	1090.98	3'0"
6 & SALTSBURG B.C. 1423.62	1224.96	1224.96	4'3"
7 - K.F.B. #295	1213.87	924.79	4'2"
8 - G.R. Co. #435	1231.53	954.5	47"
9 - " #636	1177.87	913.8	None
10 - " #637	1210.81	857.1	None
11 - " #638	1104.76	857.1	52"
12 - " #639	835.6	799.6	"
13 - " #640	882.23	777.9	"
14 - " #641	821.41	848.3	40"
15 - " #642	1130.57	838.9	"
16 - " #643	836.92	859.7	"
17 - " #644	926.21	881.8	"
18 - " #645	1155.62	1063.44	"
19 - " #646	1063.44	933.3	"
20 - " #647	1207.39	862.2	"
21 - " #648	1115.67	823.09	"
WATSON No. 21	878.09	951.8	"
22 - G.R. Co. #652	1235.85	951.8	"
23 - G.R. Co. #653	1094.9	824.5	"
24 - " #654	1164.5	887.2	"
28 - " #655	1140.11	929.4	"
29 - " #656	1179.21	985.2	"
30 - " #657	1210.98	927.7	"
G.R. Co. #658	1192.15	977.0	"
" #659	1188.21	972.2	"
" #660	1227.5	1001.0	"
" #661	1213.73	927.7	"
" #662	1237.99	927.9	"
" #663	1260.79	936.1	"
" #664	1219.30	None	"
" #665	1172.43	None	"
" #666	1203.99	None	"
" #667	1249.	None	"
" #669	1222.	None	"
Bottom No. 1			
" 2			
1 X			
2 X			
3 X			
4 X	1272.		
5 X			
6 X	1071.0		
7 X			
8 X	950.		
9 X	852.8		
10 X			
11 X	1219.9	B.C. 988.3	
12 X	1238.2	B.C. 1041.0	
13 X	1236.2	B.C. 1047.6	
14 X	1255.	B.C. 1028.3	
15 X	1280.5	B.C. 1011.0	
16 X	1233.9	B.C. 1016.8	
17 X	1275.1		

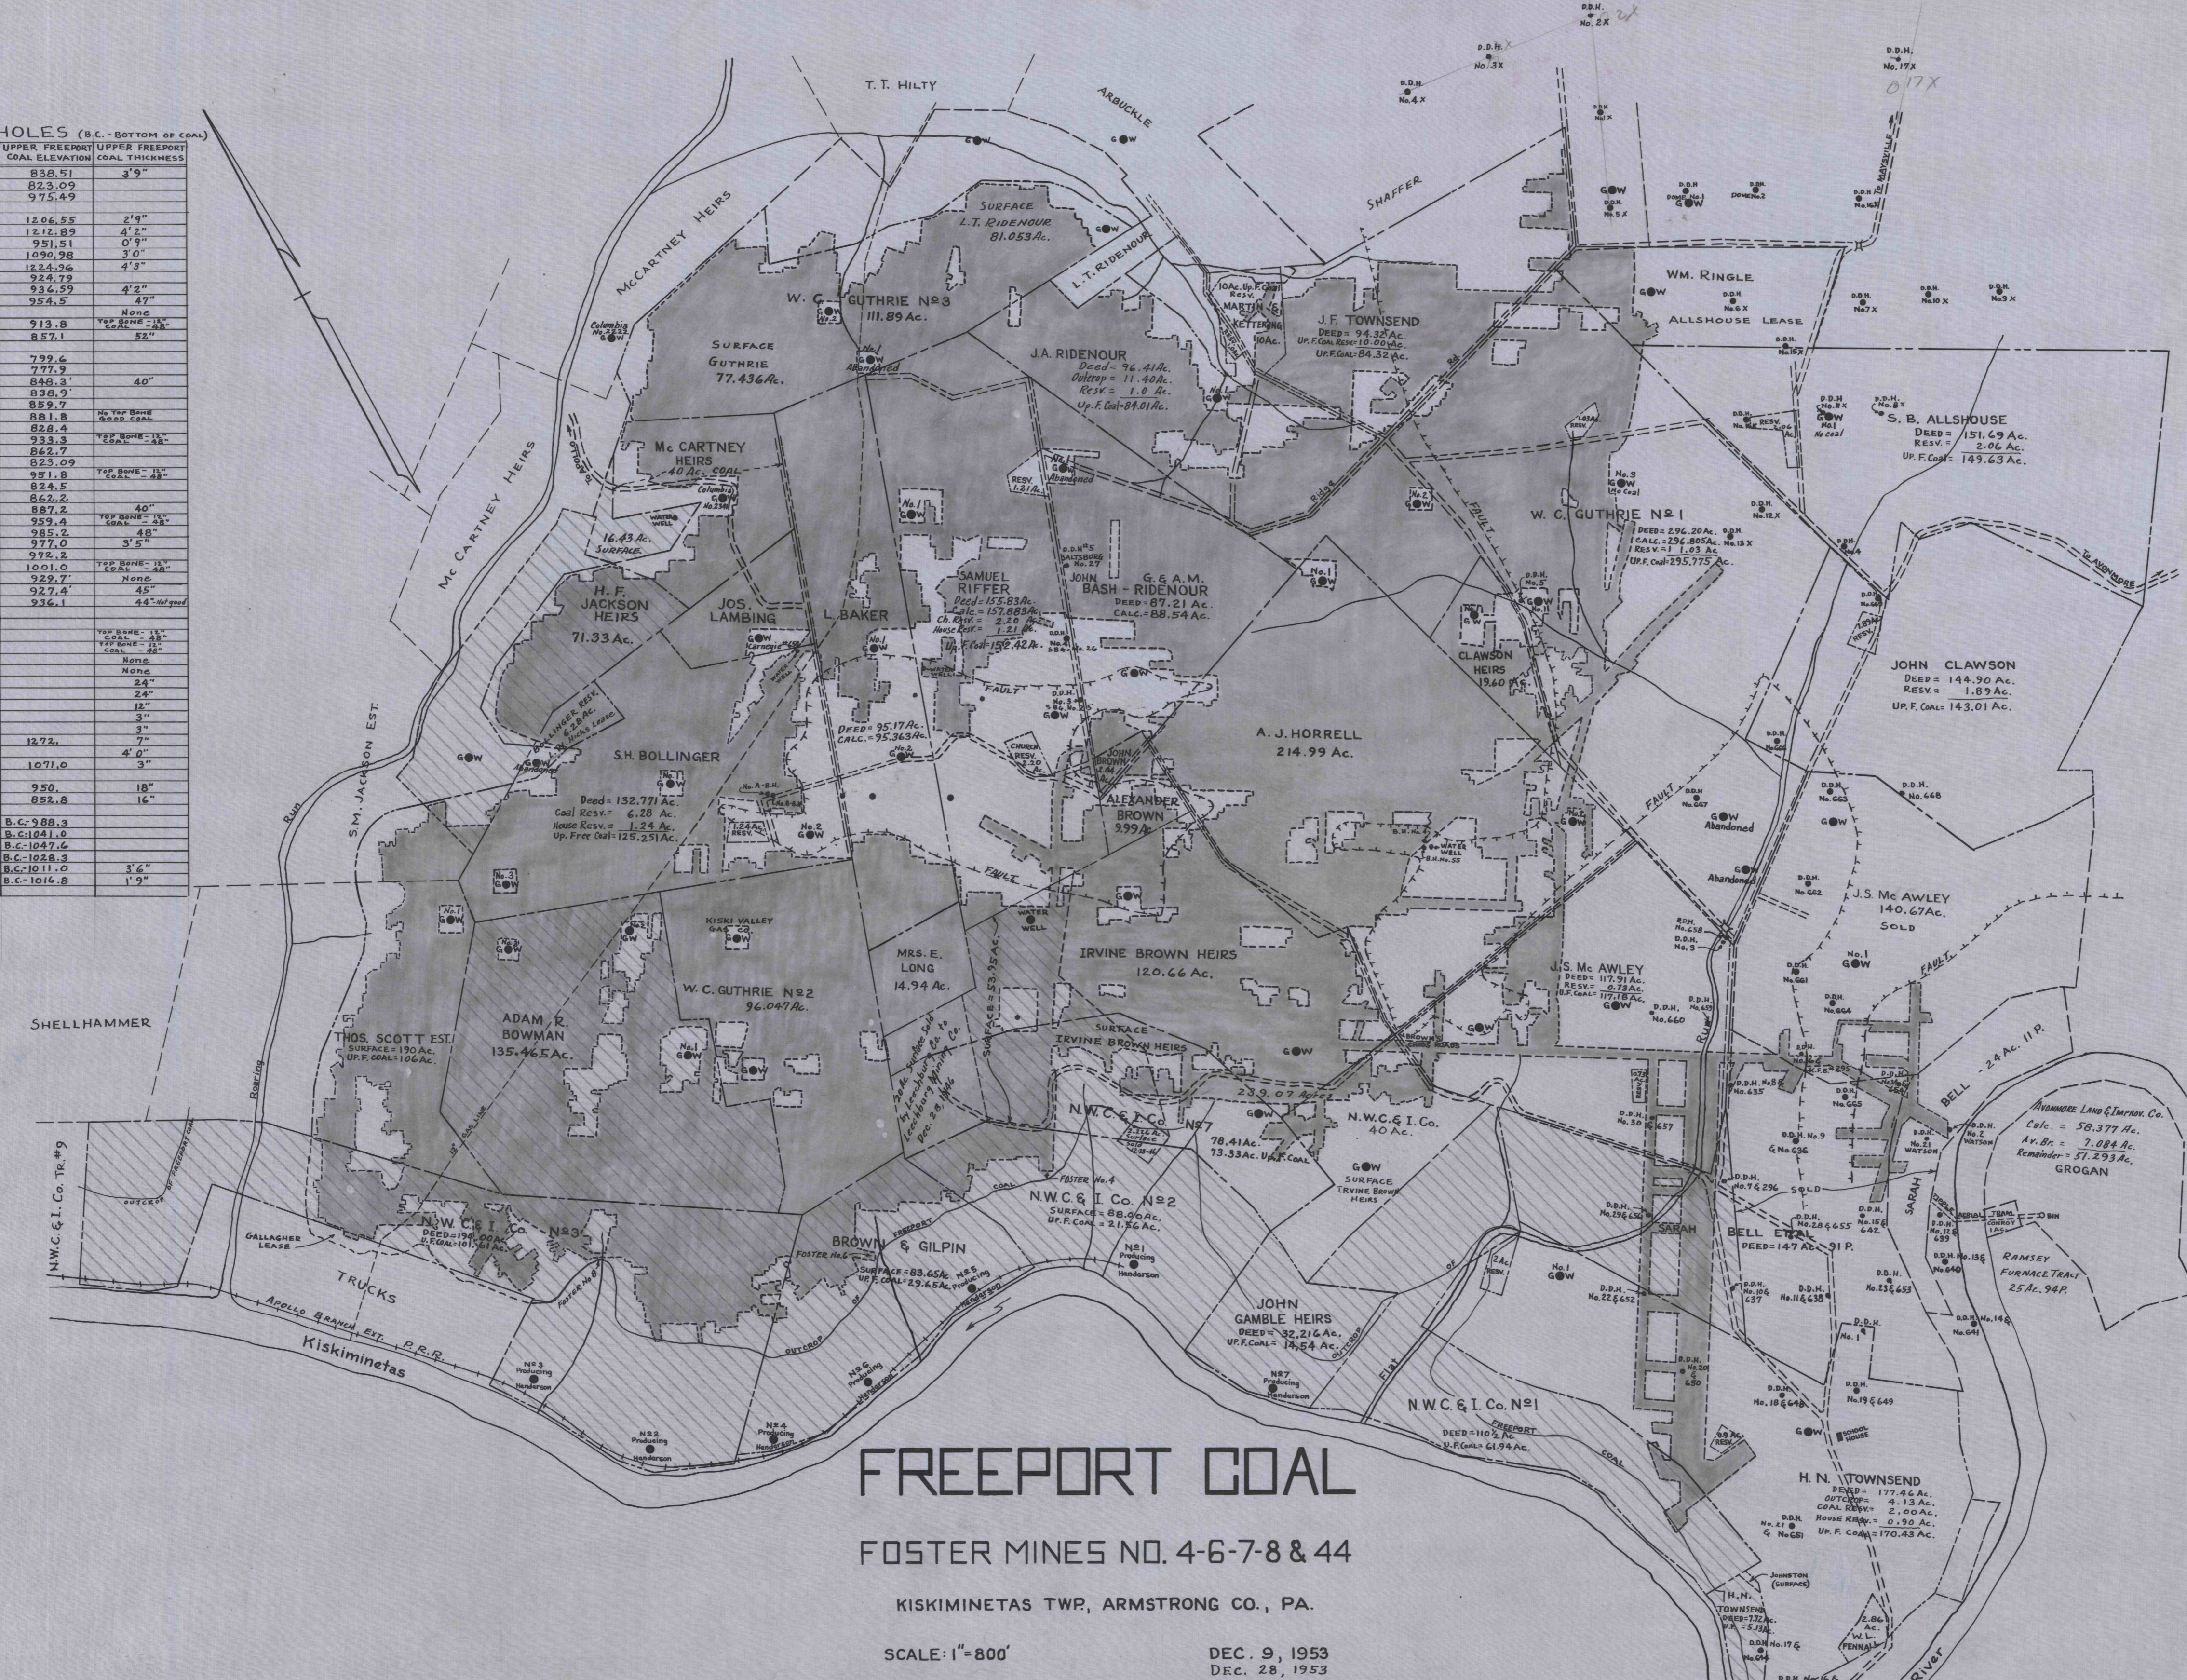

FREEPORT COAL

FOSTER MINES NO. 4-6-7-8 & 44

KISKIMINETAS TWP, ARMSTRONG CO., PA.

SCALE: 1" = 800'

DEC. 9, 1953
DEC. 28, 1953