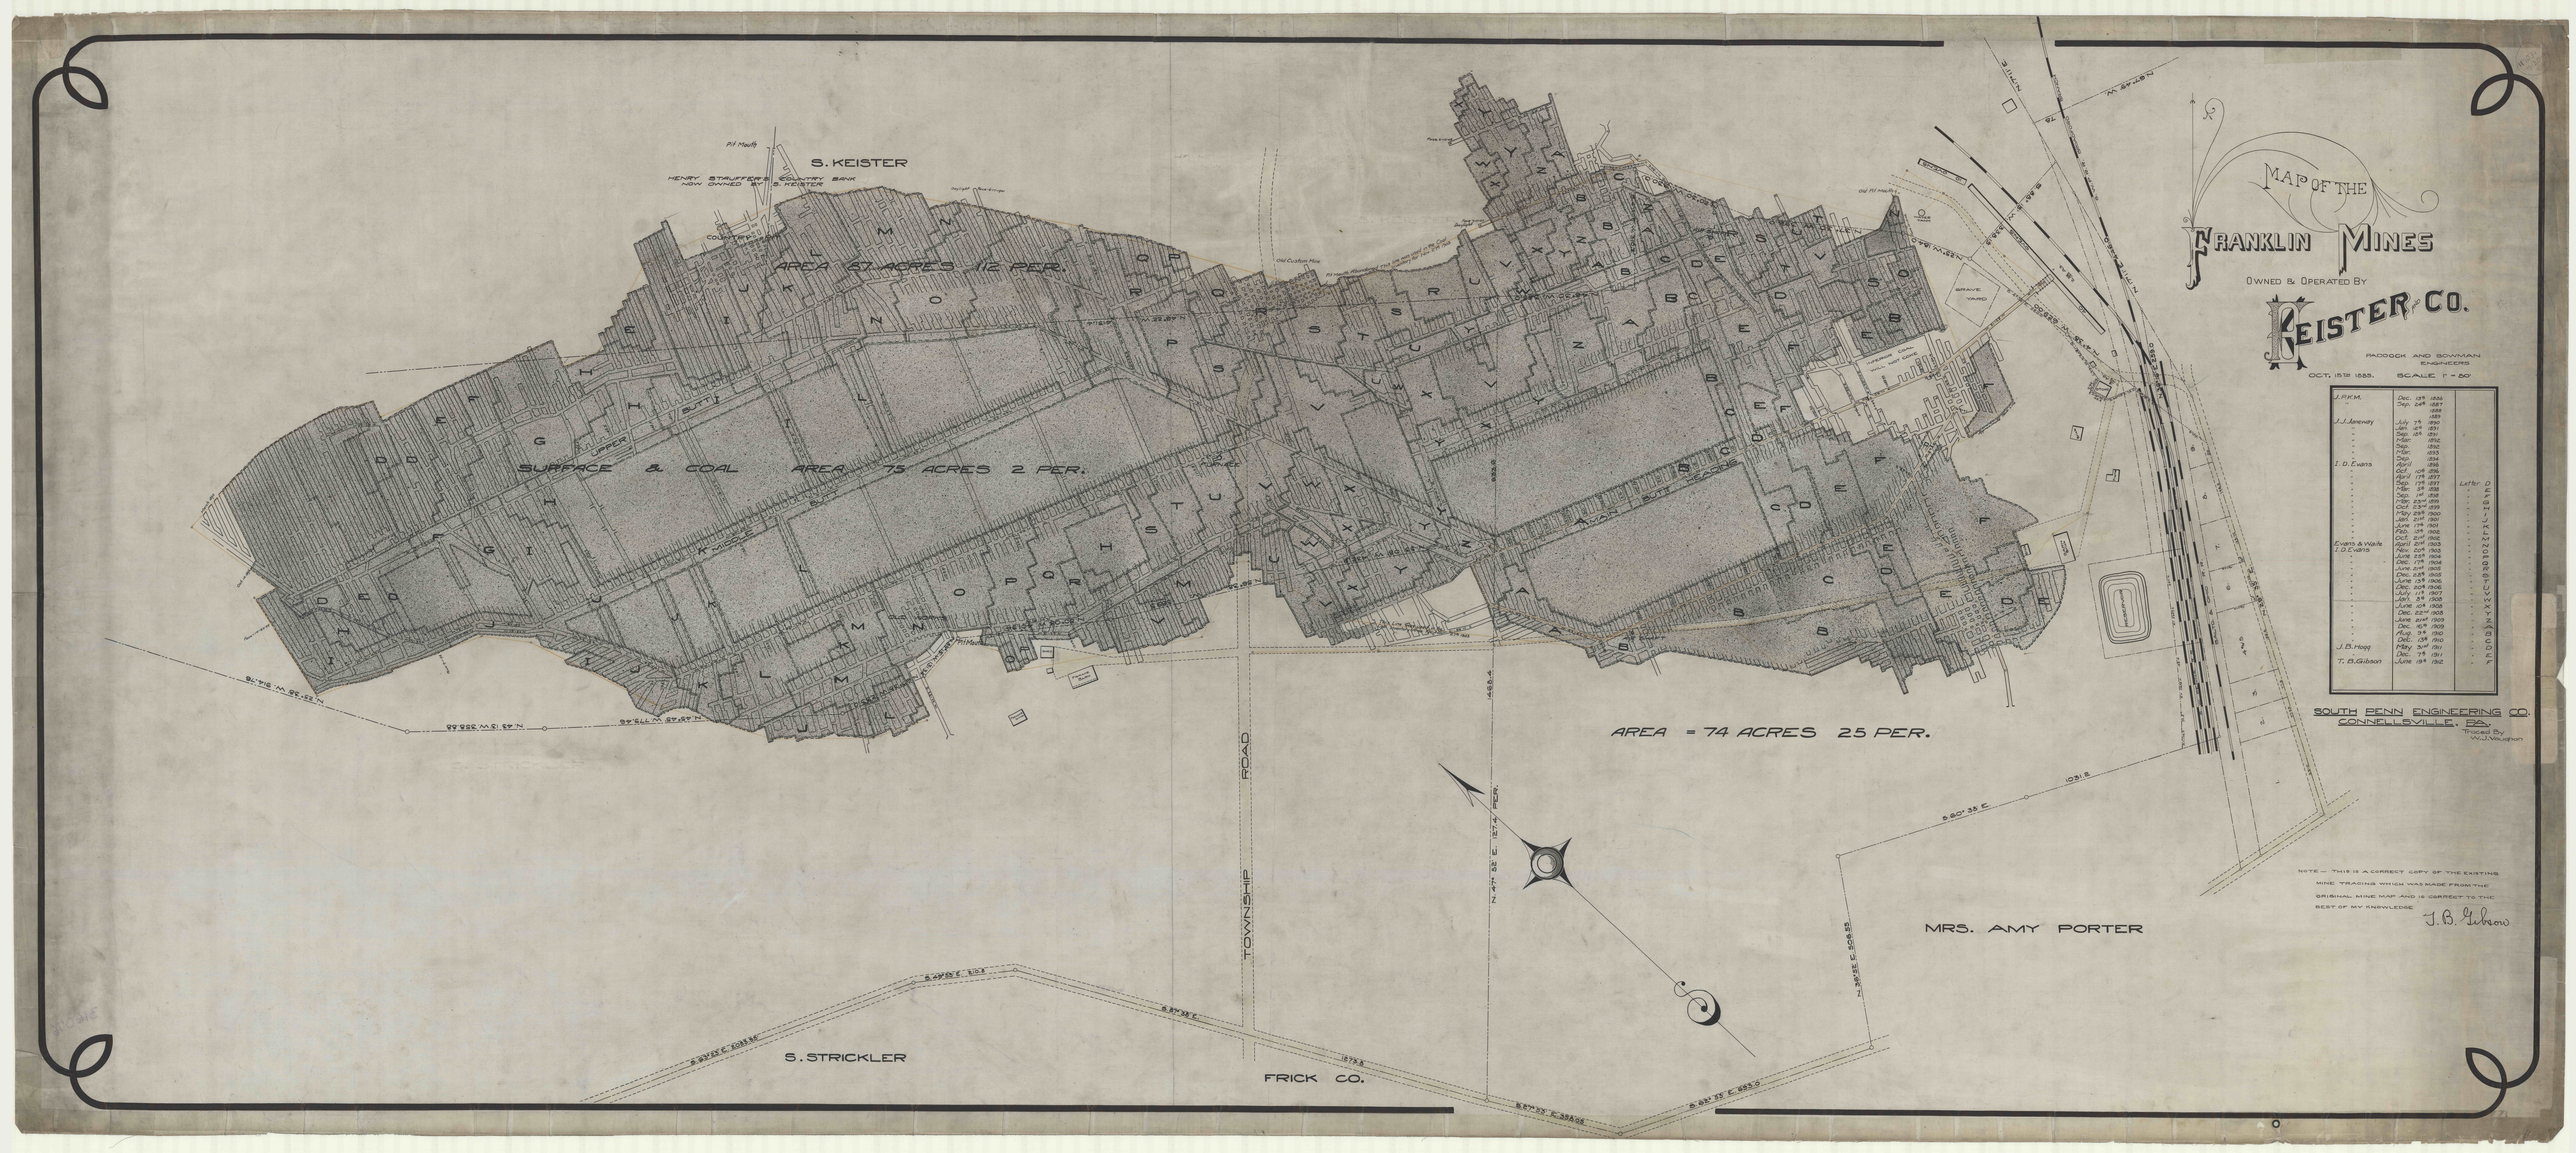

MAP OF THE
FRANKLIN MINES
OWNED & OPERATED BY
KEISTER & CO.
PADDOCK AND BOWMAN
ENGINEERS
OCT. 15TH 1883. SCALE 1" = 50'
S. KEISTER
HENRY STAUFFER'S COUNTRY SEAT NOW OWNED BY S. KEISTER
AREA 67 ACRES 112 PER.
SURFACE & COAL AREA 75 ACRES 2 PER.
AREA = 74 ACRES 25 PER.
TOWNSHIP ROAD
MRS. AMY PORTER
S. STRICKLER
FRICK CO.
SOUTH PENN ENGINEERING CO.
CONNELLSVILLE, PA.
Traced By W.J. Vaughan
NOTE— THIS IS A CORRECT COPY OF THE EXISTING MINE TRACING WHICH WAS MADE FROM THE ORIGINAL MINE MAP AND IS CORRECT TO THE BEST OF MY KNOWLEDGE
J.B. Gibson