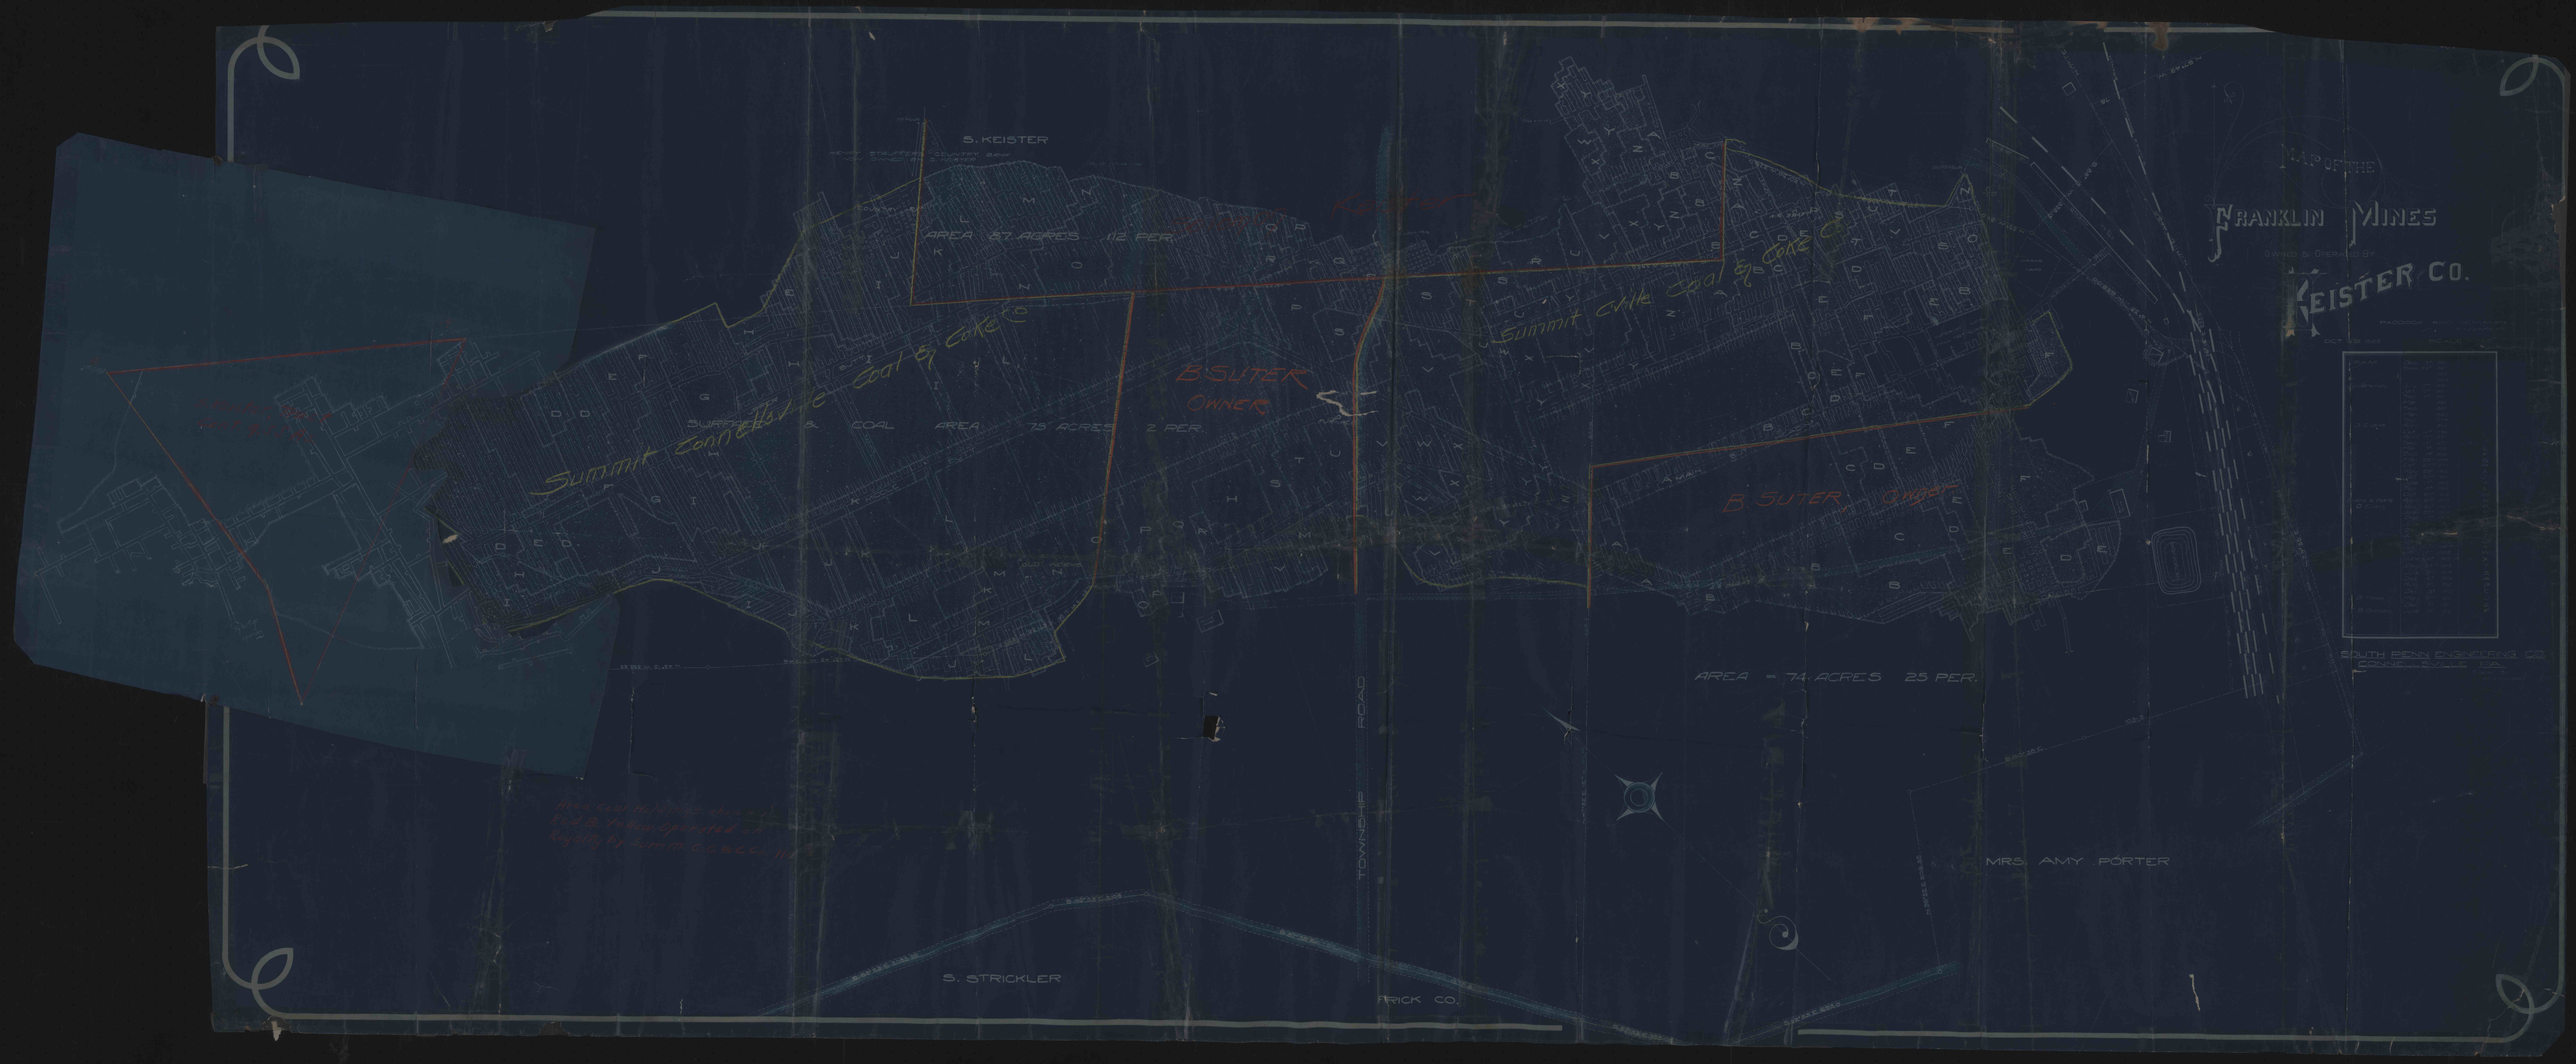
MAP OF THE
FRANKLIN MINES
OWNED & OPERATED BY
KEISTER CO.
S. KEISTER
AREA 57 ACRES 112 PER.
Summit Connellsville Coal & Coke Co
B. SUTER
OWNER
AREA 75 ACRES 2 PER.
Summit Connellsville Coal & Coke Co
B. SUTER
OWNER
AREA = 74 ACRES 25 PER.
SOUTH PENN ENGINEERING CO.
CONNELLSVILLE PA.
TOWNSHIP ROAD
MRS. AMY PORTER
S. STRICKLER
BRICK CO.