
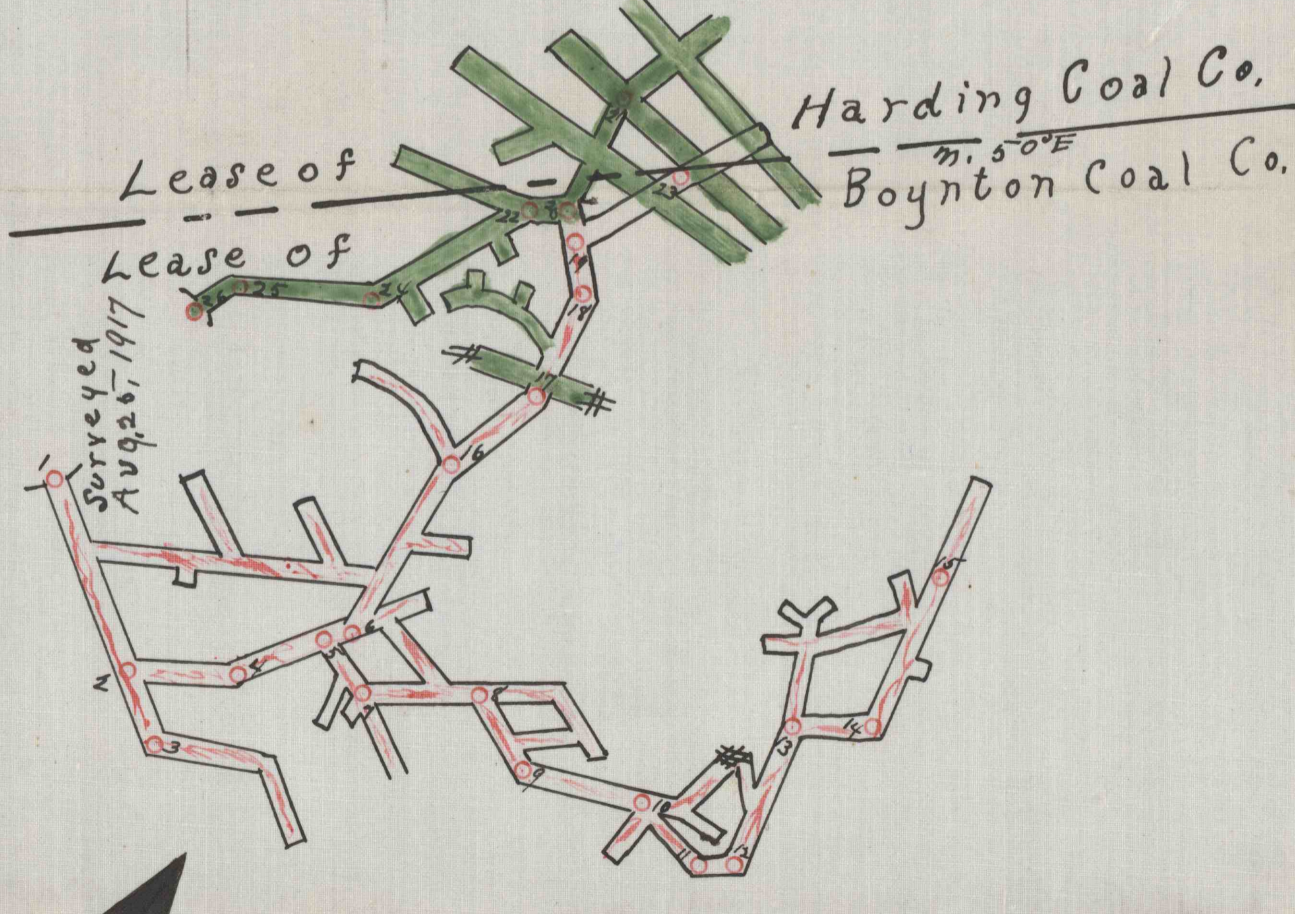


DEPARTMENT
AUDITOR GENERAL
of the
State of Pennsylvania
This is the Exhibit

#30-99
L-83-99
C.C.


G. E. Yoder, Norristown, Pa.

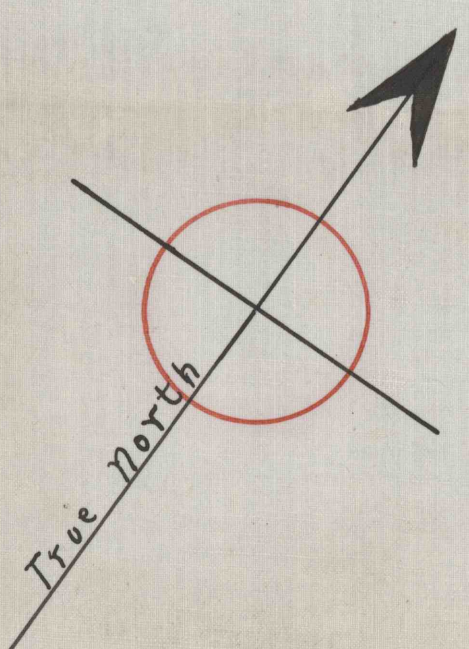

Boynton Coal Co.,
plot of part of
Chapman Mine #4
(Four-foot Seam)
situate in
ELK LICK T.W.P.,
Somerset Co.,
Pennia.

G. E. Yoder,
Norristown, Pa.

Fall
Mined by Harding Coal Co.
Scale: 1 inch = 96 ft

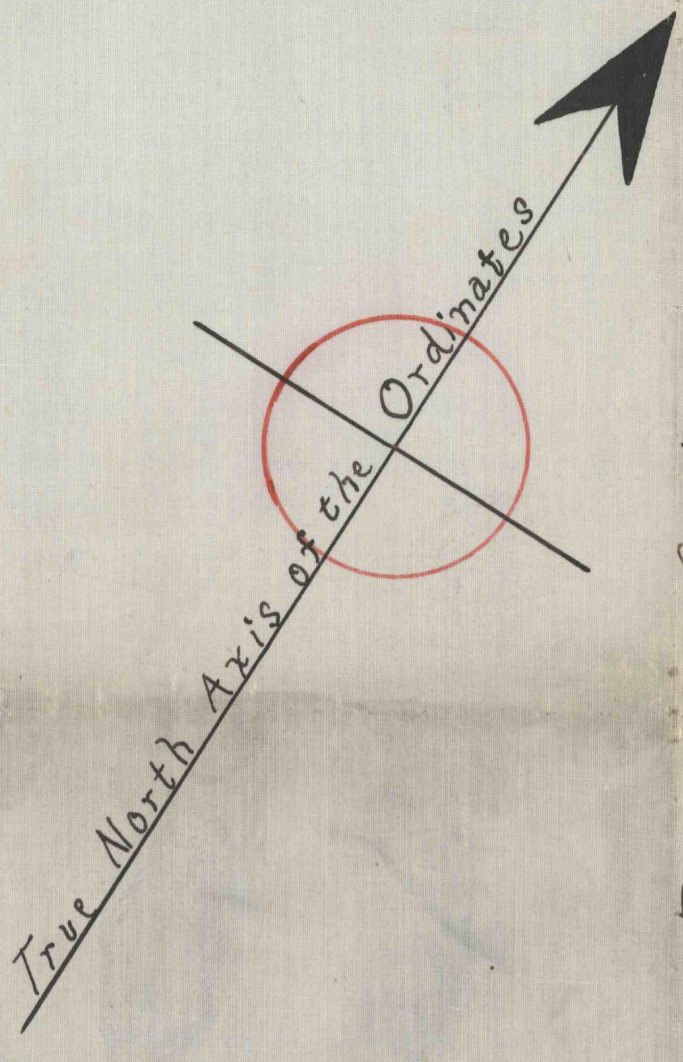

Boynton Coal Co.,
Plot of
Chapman Mine #3
situate in
ELK LICK Township
Somerset Co.,
Pennia

