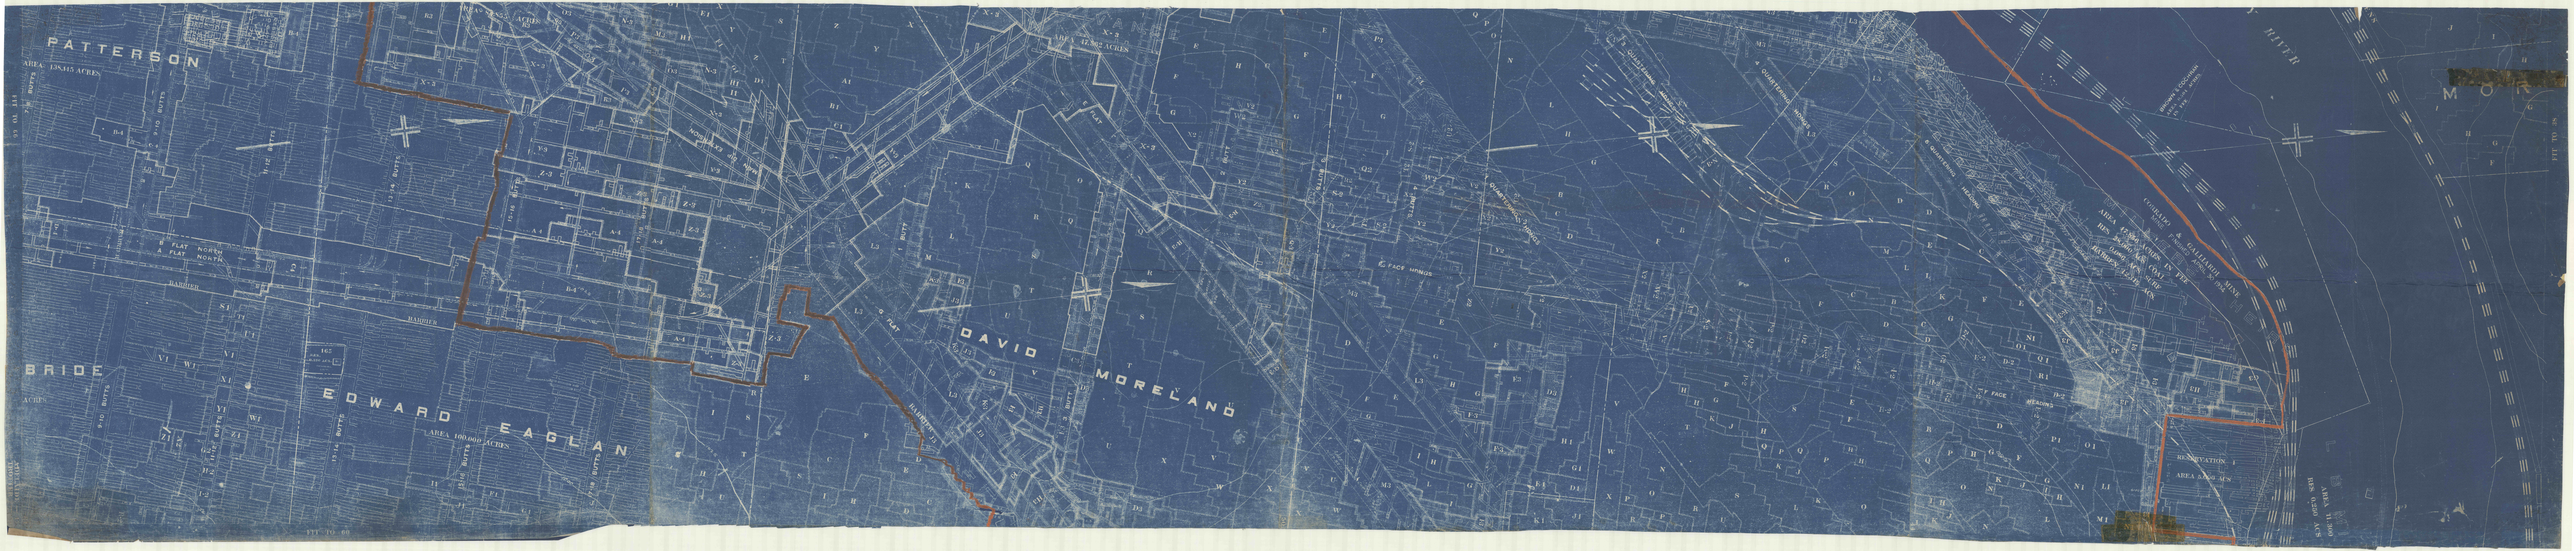
PATTERSON
BRIDE
EDWARD EAGLAN
AREA 100,000 ACRES
DAVID MORELAND
AREA 12,962 ACRES
RIVER
MOR
RESERVATION 1
AREA 2,000 ACRES
COLLIAN & GALLAGHER MINE
BROWN & SCHOMBERG
AREA 1,000 ACRES
FIT TO 60
FIT TO 28